1100

IREDELL COUNTY HEALTH DEPARTMENT

STATESVILLE 704-878-5305 MOORESVILLE 704-664-5281

IMPROVEMENT PERMIT / AUTHORIZATION TO CONSTRUCT / OPERATION PERMIT / EXISTING SYSTEM INSPECTION

PERMIT# 125044 PIN# 4614-74-6524 DATE 3/15/06

OWNER OR APPLICANT Kenneth Beaver Homes PHONE: Business _____ Home _____

ADDRESS PO Box 3398 Mooresville NC 28117

LOCATION RSR, TR Tuskarora, TR Tuskarora Pt at End on Rt

SUBDIVISION Tuskarora Pt BLOCK / SECTION _____ LOT 12 LOT AREA 1.128 AC SITE CLASS PS DESIGN FLOW 450 L.T.A.R. 0.3

Septic Tank: 1000 Gallons: STB 799 Date 10-16-05
Pump Tank: _____ Gallons: PT _____ Date _____
Pump Make: _____ Model _____ Serial No. _____
Nitrification Field: No Fields 1 Square Feet 1200 Linear Feet 400
No Lines 5@13' Trench Width 36" Max Trench Bottom Depth 36" Gravel Depth — ☒ Gravity ☐ Pressure

☒ New System ☐ Repair ☐ Expansion System Type: I (II) III IV V VI
System Description: Gravity 25% Reduct.
Repair System Description: Same
Maintenance Agreement Required: ☐ Yes ☒ No


☒ House/Mod. Home ☐ Mobile Home ☐ Business ☐ Other
No. Bedrooms 4 No. Persons ____ No. Employees ____

Water Supply: ☒ Individual ☐ Public ☐ Community

☐ Slab ☒ Crawl Space ☐ Basement w/plumbing ☐ Basement wo/plumbing


Comments/Conditions:

INITIAL SITE SKETCH

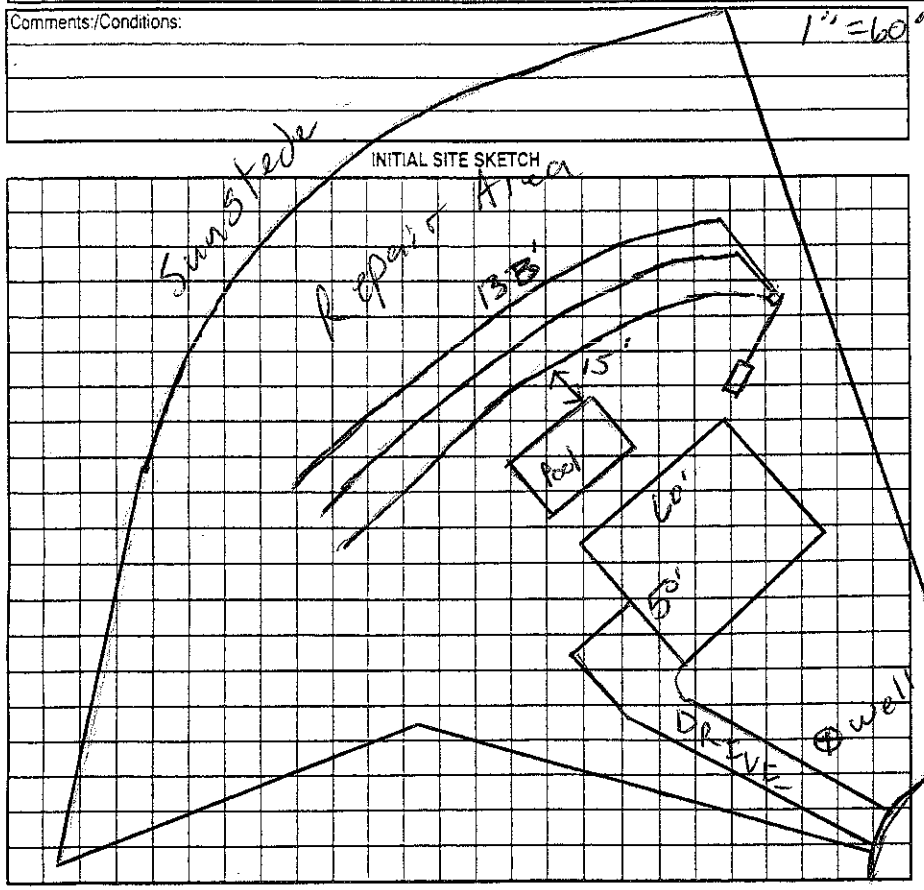

Comments/Conditions:

AS BUILT SKETCH

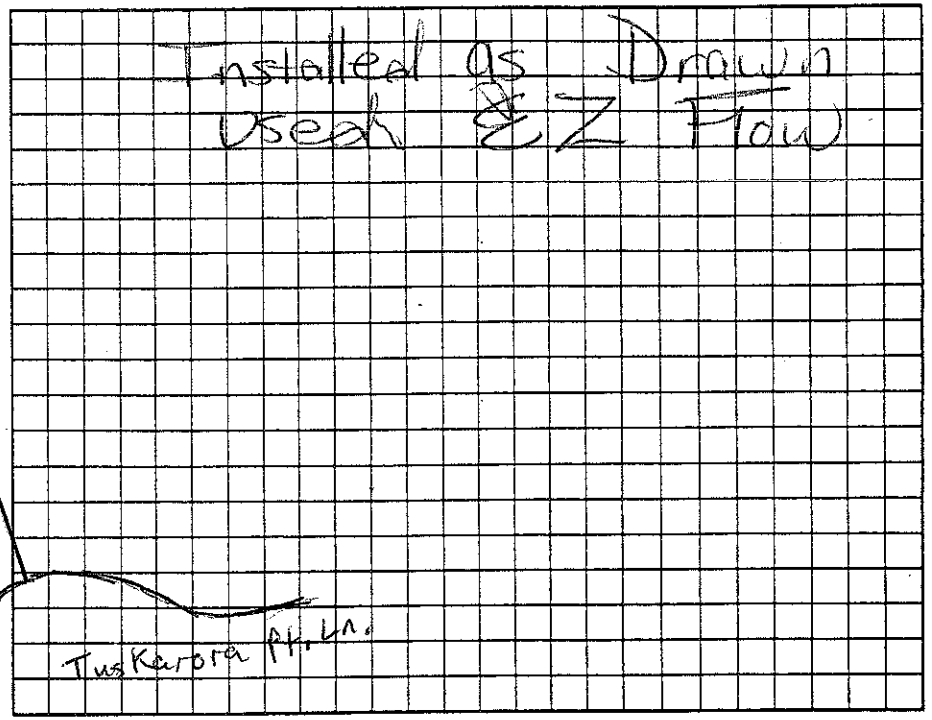

Permit can be suspended or revoked if any false information is supplied toward securing the permit/any unauthorized changes are made to the site/any unauthorized changes are made in the installation of the system. Improvement Permit with plat valid without expiration ☐ Improvement Permit with site plan valid for sixty months ☐ Authorization to Construct is valid for a period equal to that of Improvement Permit -- not to exceed sixty months.

Signed: Molly Beaton date 3-21-06

Improvement Permit by: RS date 3/15/06

Authorization to Construct by: RS date 3/15/06

Installed by: R&H

Operation Permit by: Maria H Dotson RS date 4/6/06

Existing System Inspection by: _____ date _____

HEALTH DEPT. COPY: WHITE OWNER COPY (FINAL): YELLOW OWNER COPY (INITIAL): PINK