10.45

IREDELL COUNTY HEALTH DEPARTMENT

STATESVILLE 704-878-5305 MOORESVILLE 704-664-5281

IMPROVEMENT PERMIT / AUTHORIZATION TO CONSTRUCT / OPERATION PERMIT / EXISTING SYSTEM INSPECTION

PERMIT# 131033 PIN# 4614749385 DATE 9-29-05

OWNER OR CONTRACTOR Kenneth Bealer Homes 28117 PHONE: Business 704-363-0085 Home

ADDRESS PO Box 3398 Mooresville

LOCATION Brawley School Rd TR Tuskarova Trail TR Tuskarova Point on left

SUBDIVISION Tuskarova Point BLOCK / SECTION LOT 15 LOT AREA 1.0609 Ac SITE CLASS. PS DESIGN FLOW 480gpd L.T.A.R. .3 gpd/ft²

Septic Tank: 1000 Gallons; STB 7964 Date 12-11-05
Pump Tank: Gallons; PT Date
Pump Make: Model Serial No.
Nitrification Field: No Fields 1 Square Feet 1600 Linear Feet 400
No Lines 6 Trench Width 36" Max Trench Bottom Depth 36" Gravel Depth N/A

☒ New System ☐ Repair System Type: I (II) III, IV, V, VI
System Description: 25% reduction, gravity
Repair System Description: LP Panel
Maintenance Agreement Required: ☐ Yes ☒ No

☒ House/Mod. Home No. Bedrooms 4
☐ Mobile Home No. Bathrooms
☐ Business No. Employees
☐ Other


☐ Slab ☒ Crawl Space ☐ Basement w/plumbing ☐ Basement wo/plumbing

Water Supply: ☒ Individual ☐ Public ☐ Community

Comments/Conditions:

Comments/Conditions: Checked tank 4/6/06

INITIAL SITE SKETCH 1" = 40'

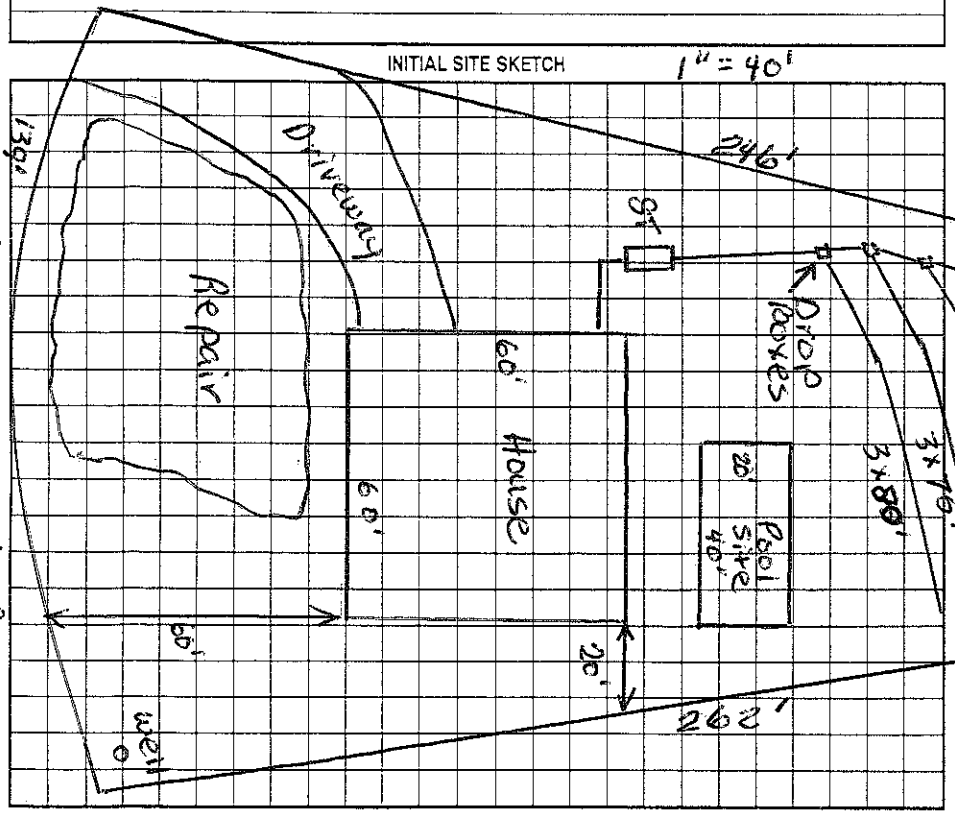

AS BUILT SKETCH

Installed EZ for Drain Field

Permit can be suspended or revoked if any false information is supplied toward securing the permit/any unauthorized changes are made to the site/any unauthorized changes are made in the installation of the system. Improvement Permit with plat valid without expiration. Improvement Permit with site plan valid for sixty months. Authorization to Construct is valid for a period equal to that of Improvement Permit – not to exceed sixty months.

Signed: date 9-30-05 Installed by: R & H RS

Improvement Permit by: Judy Melville date 9-29-05 Operation Permit by: Maria H Dotson date 4/7/06

Authorization to Construct by: Judy Melville date 10-12-05 Existing System Inspection by: date

HEALTH DEPT. COPY: WHITE OWNER COPY (FINAL): YELLOW OWNER COPY (INITIAL): PINK