IREDELL COUNTY HEALTH DEPARTMENT

STATESVILLE 704-878-5305 130.00 Paid MOORESVILLE 704-664-5281

IMPROVEMENT PERMIT / AUTHORIZATION TO CONSTRUCT / OPERATION PERMIT / EXISTING SYSTEM INSPECTION

PERMIT# 124039 PIN# 4614-84-3316.040 4614749612 DATE 10/29/04

OWNER OR CONTRACTOR Kenneth Bealer Homes Inc PHONE: Business 704 662 6400 Home

ADDRESS PO Box 3398 Mooresville NC 28117

LOCATION BSR, TR Tuskarora Tr., TR Tuskarora Pt, on Rt

SUBDIVISION Tuskarora Pt. BLOCK / SECTION LOT 10 LOT AREA 0.700 AC SITE CLASS. PS DESIGN FLOW 480 L.T.A.R. 0.3

Septic Tank: 1000 Gallons; STB 317 Date 4/12/05

Pump Tank: Gallons; PT Date

Pump Make: Model Serial No.

Nitrification Field: No Fields 1 Square Feet 1200 Linear Feet 400

No Lines 4@100' Trench Width 36" Max Trench Bottom Depth 36" Gravel Depth —

☒ New System ☐ Repair System Type: I, II, III, IV, V, VI

System Description: Gravity 25% Reduct.

Repair System Description: Pedi Block

Maintenance Agreement Required: ☐ Yes ☒ No

☒ House/Mod. Home No. Bedrooms 4

☐ Mobile Home No. Bathrooms

☐ Business No. Employees

☐ Other

Water Supply: ☒ Individual ☐ Public ☐ Community


☐ Slab ☒ Crawl Space ☐ Basement w/plumbing ☐ Basement wo/plumbing

Comments:/Conditions:


1" = 40'

Comments:/Conditions: Quick 4 drainfield trench detail.

INITIAL SITE SKETCH

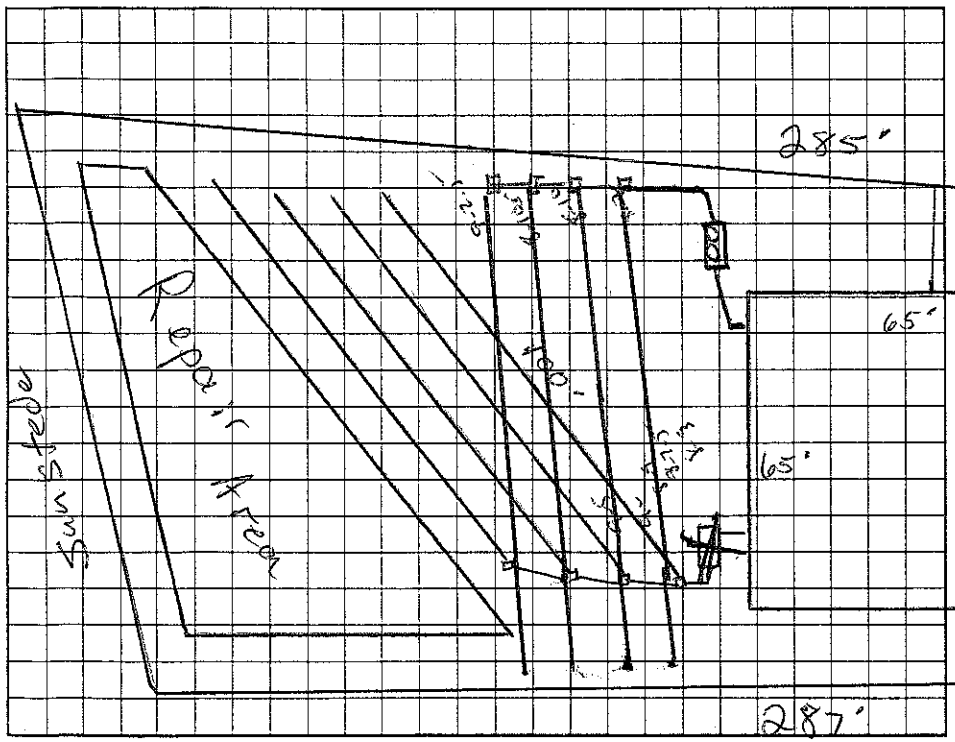

AS BUILT SKETCH

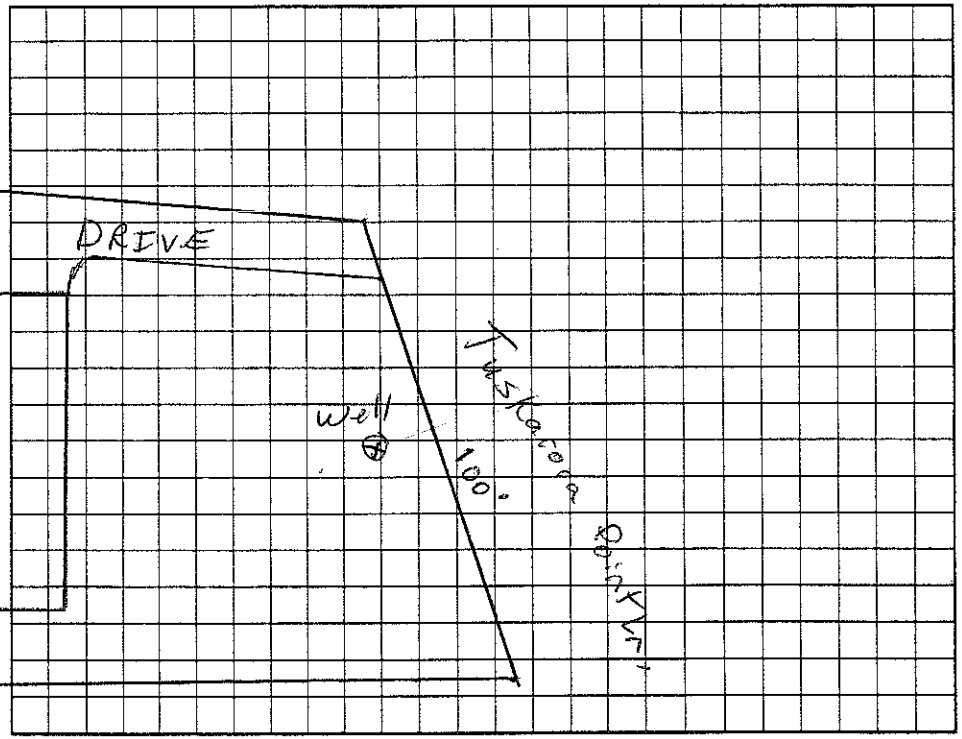

Permit can be suspended or revoked if any false information is supplied toward securing the permit/any unauthorized changes are made to the site/any unauthorized changes are made in the installation of the system. Improvement Permit with plat valid without expiration. Improvement Permit with site plan valid for sixty months. Authorization to Construct is valid for a period equal to that of Improvement Permit – not to exceed sixty months.

Signed: date 11/1/04 Installed by: Hallman Construction

Improvement Permit by: RS date 10/29/04 Operation Permit by: Wesley Sparks RS date 7/19/05

Authorization to Construct by: RS date 10/29/04 Existing System Inspection by: date

HEALTH DEPT. COPY: WHITE OWNER COPY (FINAL): YELLOW OWNER COPY (INITIAL): PINK