IREDELL COUNTY HEALTH DEPARTMENT

STATESVILLE 704-878-5305 MOORESVILLE 704-664-5281

IMPROVEMENT PERMIT / AUTHORIZATION TO CONSTRUCT / OPERATION PERMIT / EXISTING SYSTEM INSPECTION

PERMIT# 113452 PIN# 4614 75 4073 DATE 7/9/03

OWNER OR CONTRACTOR Dean Rodgers PHONE: Business 704-664-9255 Home

ADDRESS 117 Holly Pond Ln. Mooresville, NC. 28117

LOCATION BSR TR Tuscarora TR Sunstede TR Holly Pond, 2ND on (L)

SUBDIVISION No BLOCK / SECTION LOT LOT AREA .97 AC SITE CLASS PS DESIGN FLOW 360 L.T.A.R. .3

Septic Tank: EXISTING Gallons; STB Date

Pump Tank: Gallons; PT Date

Pump Make: Model Serial No.

Nitrification Field: No Fields EXISTING BED SYSTEM Square Feet

No Lines Trench Width Max Trench Bottom Depth Gravel Depth 24

☐ New System ☐ Repair System Type: I (II) III. IV. V. VI

System Description:

Repair System Description: EXISTING SYSTEM

Maintenance Agreement Required: ☐ Yes ☒ No

☒ House/Mod. Home No. Bedrooms 3

☐ Mobile Home No. Bathrooms 3.5

☐ Business No. Employees

☐ Other

☐ Slab ☐ Crawl Space ☒ Basement w/plumbing ☐ Basement wo/plumbing

Water Supply: ☒ Individual ☐ Public ☐ Community NOT CONST. YET


Comments:/Conditions:

Comments:/Conditions:

(1"=50')

INITIAL SITE SKETCH

AS BUILT SKETCH

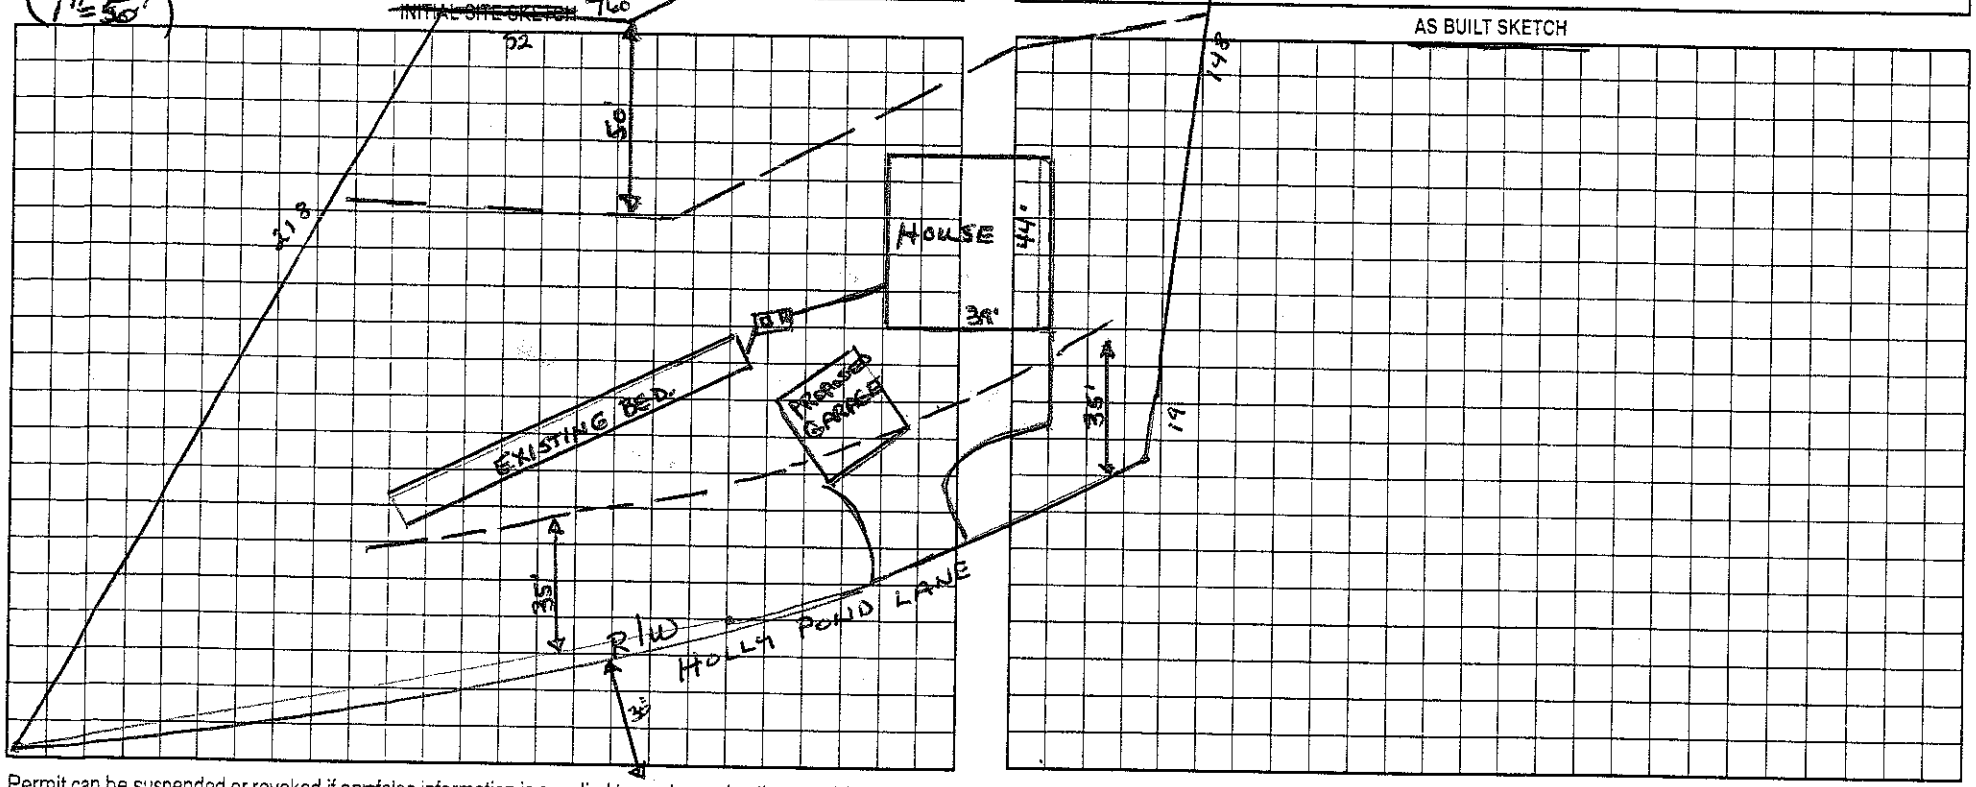

Permit can be suspended or revoked if any false information is supplied toward securing the permit/any unauthorized changes are made to the site/any unauthorized changes are made in the installation of the system. Improvement Permit with plat valid without expiration. Improvement Permit with site plan valid for sixty months. Authorization to Construct is valid for a period equal to that of Improvement Permit – not to exceed sixty months.

Signed: Dean Rodgers date

Improvement Permit by: date

Authorization to Construct by: date

Installed by:

Operation Permit by: date

Existing System Inspection by: Wesley Sparks R.S. date 7/9/03

HEALTH DEPT. COPY: WHITE OWNER COPY (FINAL): YELLOW OWNER COPY (INITIAL): PINK