IREDELL COUNTY HEALTH DEPARTMENT

STATESVILLE 704-878-5305 MOORESVILLE 704-664-5281

IMPROVEMENT PERMIT / AUTHORIZATION TO CONSTRUCT / OPERATION PERMIT / EXISTING SYSTEM INSPECTION

PERMIT# 133348 PIN# 4614838288 DATE 2-24-06

OWNER OR APPLICANT Sandra Graves PHONE: Business 704-664-5765 Home 704-799-0292

ADDRESS 156 Ballycastle Rd Mooresville 28117

LOCATION Brawley School Rd TR Tuscarora Trail TL Syllabub TR Ballycastle 4th house on right (156 Ballycastle)

SUBDIVISION Newjoon CLT BLOCK / SECTION 6 LOT 333 LOT AREA .728 Ac SITE CLASS. PS DESIGN FLOW 120gpd L.T.A.R. .3gpd/ft²

Septic Tank: ~~Existing~~ Gallons; STB 794 Date 12-15-06

Pump Tank: Gallons; PT Date

Pump Make: Model Serial No.

Nitrification Field: No Fields 1 Square Feet 400 Linear Feet 100

No Lines 2 @ 50' Trench Width 24" Max Trench Bottom Depth 36" Gravel Depth NA ☒ Gravity ☐ Pressure

☐ New System ☐ Repair ☒ Expansion System Type: I II (III) IV V VI

System Description: panel block gravity

Repair System Description: 25% or 50% reduction

Maintenance Agreement Required: ☐ Yes ☒ No

☒ House/Mod. Home ☐ Mobile Home ☐ Business ☐ Other

No. Bedrooms ★ 1 No. Persons No. Employees

Water Supply: ☒ Individual ☐ Public ☐ Community

☐ Slab ☐ Crawl Space ☒ Basement w/plumbing ☐ Basement wo/plumbing


Comments:/Conditions: - Existing House & sidewalk to be removed
- Add Bull Run Valve to alternate between existing & new system lines
- Distribution Box w/ speed levelers

1" = 40'


Comments:/Conditions: ★ 2 Bd expanding to 3 Bd.
Keep 5' undisturbed soil between existing line & new lines

Existing house removed may be additional repair area available

INITIAL SITE SKETCH

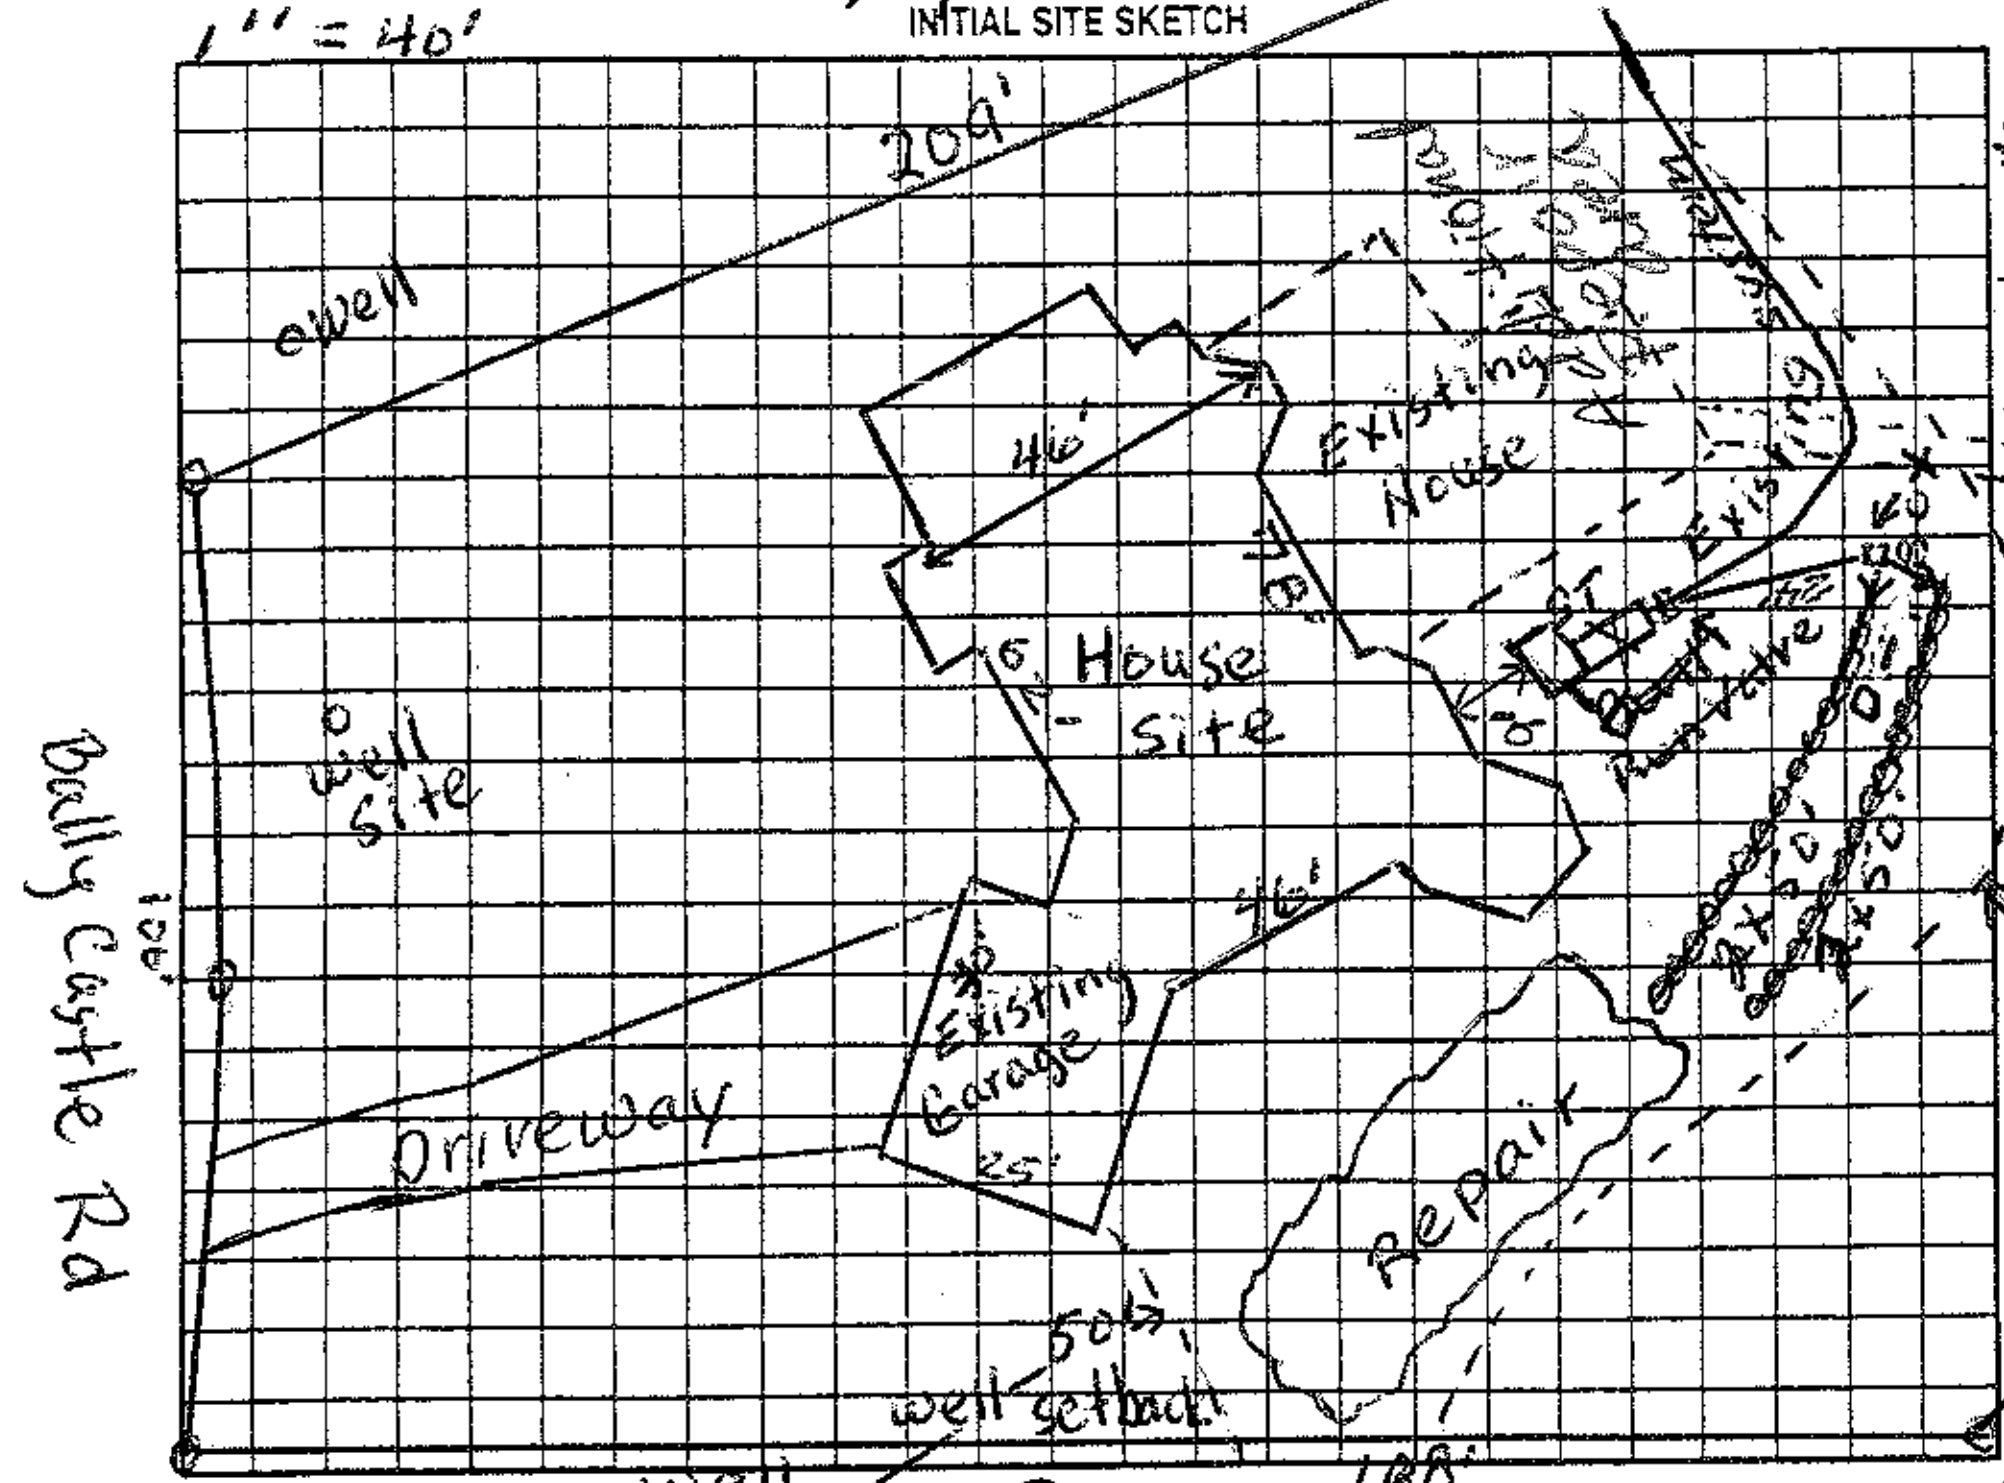

AS BUILT SKETCH

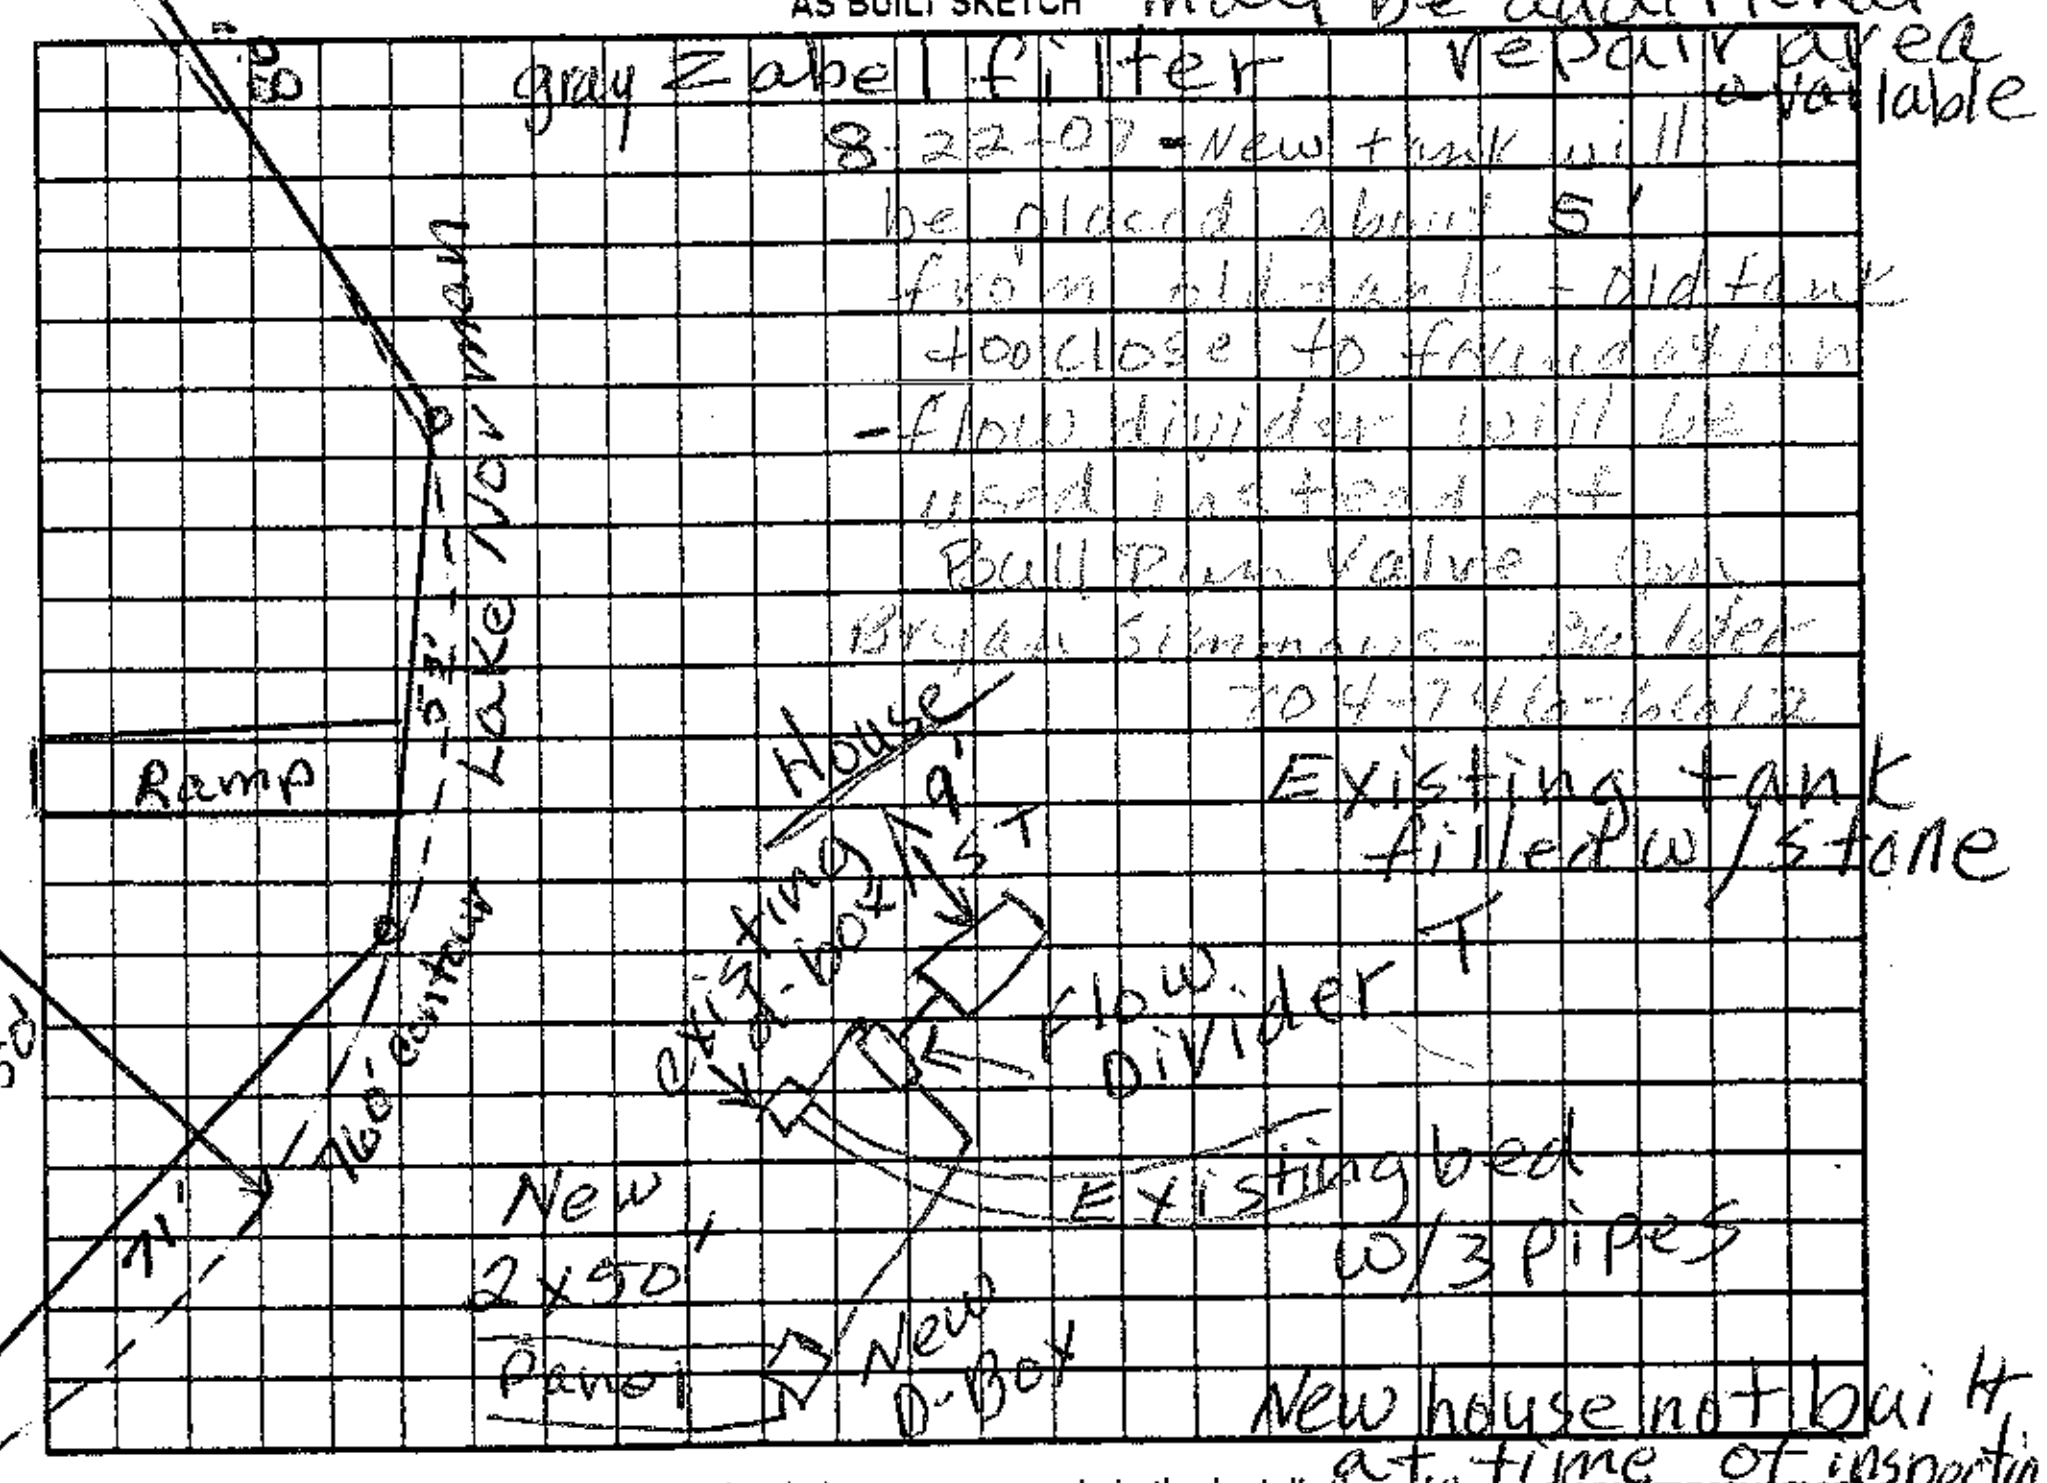

Permit can be suspended or revoked if any false information is supplied toward securing the permit/any unauthorized changes are made to the site/any unauthorized changes are made in the installation of the system. Improvement Permit with plat valid without expiration ☐ Improvement Permit with site plan valid for sixty months ☒

Authorization to Construct is valid for a period equal to that of Improvement Permit – not to exceed sixty months.

Signed: Ronald Snow date 3/16/06

Improvement Permit by: Judy Merrill date 2-24-06

Authorization to Construct by: Judy Merrill date 2-24-06

Installed by: Dellinger Grading

Operation Permit by: Judy Merrill date 8-24-07

Existing System Inspection by: date

HEALTH DEPT. COPY: WHITE OWNER COPY (FINAL): YELLOW OWNER COPY (INITIAL): PINK