2:00

IREDELL COUNTY HEALTH DEPARTMENT

STATESVILLE 704-878-5305 MOORESVILLE 704-664-5281

IMPROVEMENT PERMIT / AUTHORIZATION TO CONSTRUCT / OPERATION PERMIT / EXISTING SYSTEM INSPECTION

PERMIT# 076491 PIN# 4614 83 8576 DATE 10/9/98

OWNER OR CONTRACTOR ROBERT TERRY PHONE: Business Home 552-2090

ADDRESS 1128 CT DRIVE CHARLOTTE NC 28211

LOCATION BRAWLEY SCHOOL - TR TUSKARORA - TL SYLLABUB - TR BALLYCASTLE

SUBDIVISION CLAT BLOCK / SECTION 6 LOT 331 LOT AREA .69AC SITE CLASS PS DESIGN FLOW 480gpd L.T.A.R. .3gal/ft²

Septic Tank: 1000 Gallons; STB 1012 Date 10-8-00

Pump Tank: 1000 Gallons; PT 17 Date 10-9-00

Pump Make: Meyers Model ME40 Serial No.

Nitrification Field: No. Fields 1 Square Feet @600 Linear Feet 300

No Lines 5@60' Trench Width 36" Max Trench Bottom Depth 36"

☑ New System ☐ Repair System Type: I, II, III, IV, V, VI

System Description: PUMP PANEL

Repair System Description: SAME IF AVAILABLE

Maintenance Agreement Required: ☐ Yes ☑ No

Gravel Depth N/A

☑ House/Mod. Home No. Bedrooms 4

☐ Mobile Home No. Bathrooms 4

☐ Business No. Employees

☐ Other


☐ Slab ☑ Crawl Space ☑ Basement w/plumbing ☐ Basement wo/plumbing

Water Supply: ☑ Individual ☐ Public ☐ Community


Comments:/Conditions:
KEEP SYSTEM FROM WELL ON LOT AND NEIGABOR'S WELL.

Comments:/Conditions: Filter not installed yet
Checked lines & tanks 4/19/2001.
Press Checked, Does Not have valve by Pres. Manifold box; Used valve in tank to adjust

INITIAL SITE SKETCH

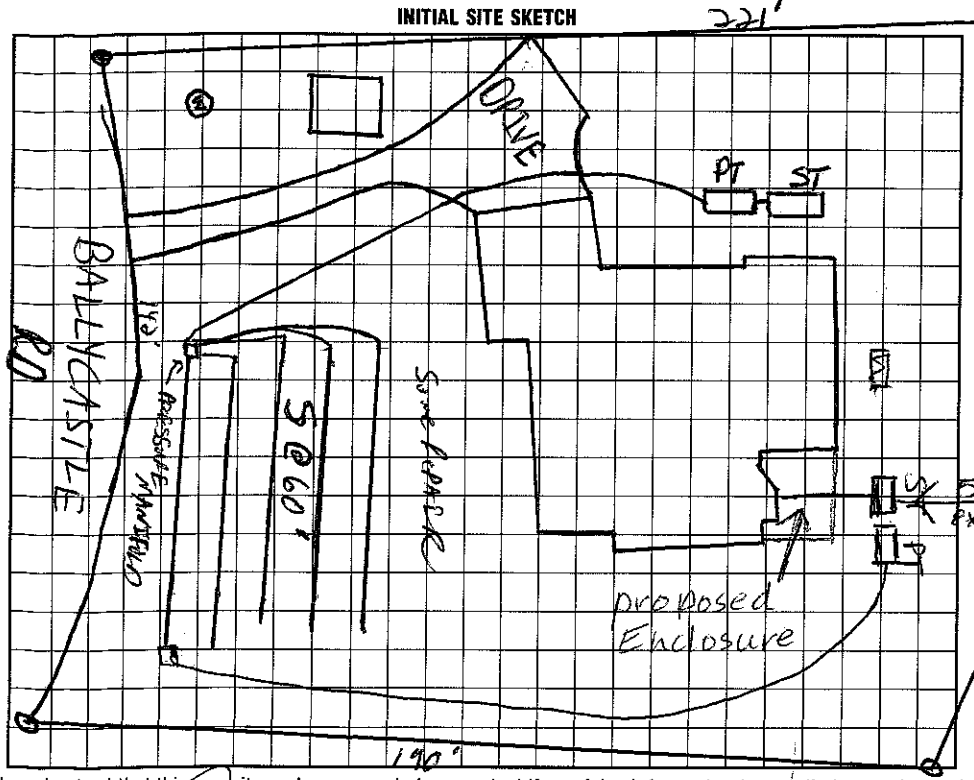

AS BUILT SKETCH

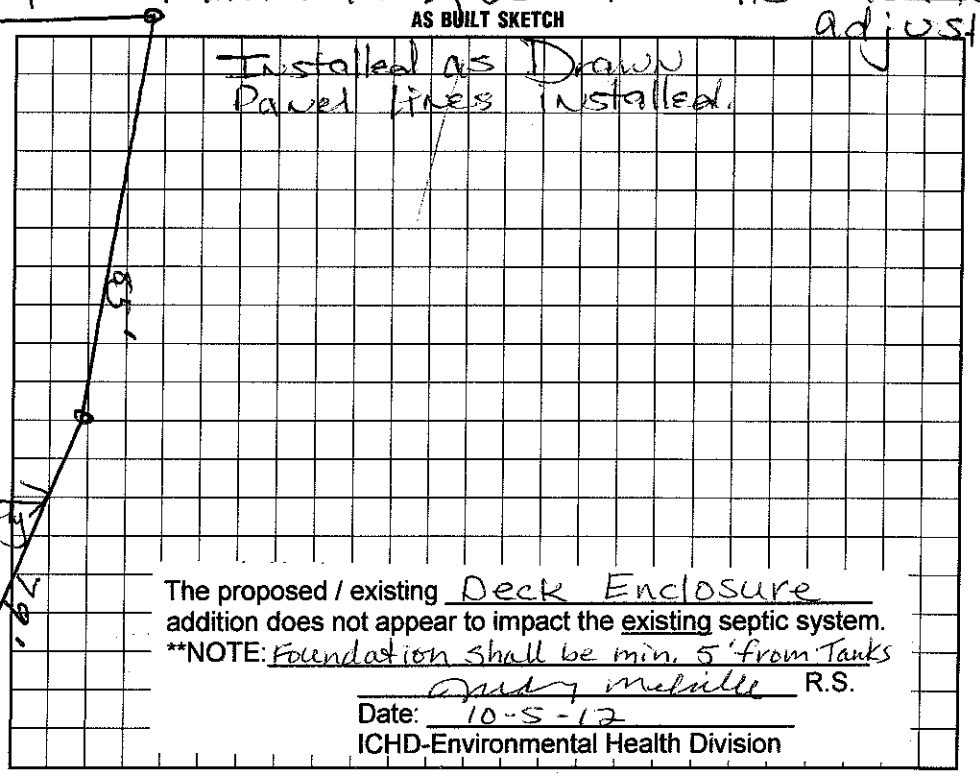

The proposed / existing Deck Enclosure addition does not appear to impact the existing septic system.

**NOTE: Foundation shall be min. 5' from Tanks

Andy Melville R.S.

Date: 10-5-12

ICHD-Environmental Health Division

I understand that this permit can be suspended or revoked if any false information is supplied toward securing the permit/any unauthorized changes are made to the site/any unauthorized changes are made in the installation of the system. Improvement Permit with plat valid without expiration. Improvement Permit with site plan valid for sixty months. Authorization to Construct is valid for a period equal to that of Improvement Permit – not to exceed sixty months.

Signed: [signature] date

Improvement Permit by: C. [signature] LS date 10/9/98

Authorization to Construct by: C. [signature] LS date 10/9/98

Installed by: Richard Abernathy

Operation Permit by: [signature] date 5/18/2001

Existing System Inspection by: date

HEALTH DEPT. COPY: WHITE INSPECTION COPY (FINAL): GREEN OWNER COPY (FINAL): YELLOW INSPECTION COPY (INITIAL): PINK OWNER COPY (INITIAL): GOLD