IREDELL COUNTY HEALTH DEPARTMENT

STATESVILLE 704-878-5305 MOORESVILLE 704-664-5281

IMPROVEMENT PERMIT / AUTHORIZATION TO CONSTRUCT / OPERATION PERMIT / EXISTING SYSTEM INSPECTION

PERMIT# 140090 PIN# 4614840390 DATE 1-29-07

OWNER OR APPLICANT Kenneth Bealer Homes Inc PHONE: Business 662-6400 Home

ADDRESS P.O. Box 3398 Mooresville, NC 28117

LOCATION Brawley School Rd TR Tuskarora Trail TR Tuskarora Point Ln on left

SUBDIVISION Tuskarora Pt BLOCK / SECTION LOT 16 LOT AREA .694 Acre SITE CLASS. PS DESIGN FLOW 480gpd L.T.A.R. .3

Septic Tank: 1000 Gallons; STB 794 Date 1-5-07

Pump Tank: 1000 Gallons; PT 27 Date 2-10-07

Pump Make: Goulds Model WE03E2MV Serial No.

Nitrification Field: No Fields 1 Square Feet 540' Linear Feet 270'

No Lines 4 Trench Width Min. 24" Max Trench Bottom Depth 36" Gravel Depth N/A ☐ Gravity ☒ Pressure

☒ New System ☐ Repair ☐ Expansion System Type: I II III IV V VI

System Description: Pump-LP-Panel Blk

Repair System Description: Same

Maintenance Agreement Required: ☒ Yes ☐ No

☒ House/Mod. Home ☐ Mobile Home ☐ Business ☐ Other

No. Bedrooms 4 No. Persons ___ No. Employees ___


Water Supply: ☒ Individual ☐ Public ☐ Community

☐ Slab ☐ Crawl Space ☒ Basement w/plumbing ☐ Basement wo/plumbing


Comments:/Conditions: Note: Keep Septic System 25Ft away From basement if Upslope & 15Ft if Side Slope or 10Ft otherwise. PL 246.2

Comments:/Conditions: 5/2/07 Okay to do Drainfield as Installer has lay out
5/3/07 Checked Tanks

INITIAL SITE SKETCH 1:40

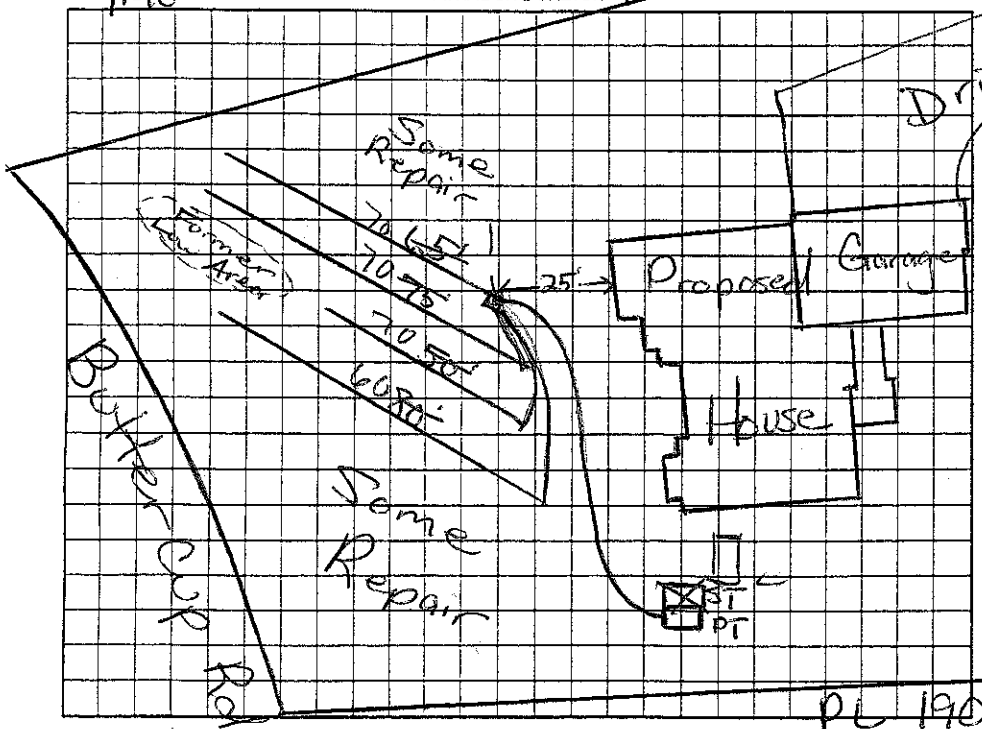

AS BUILT SKETCH

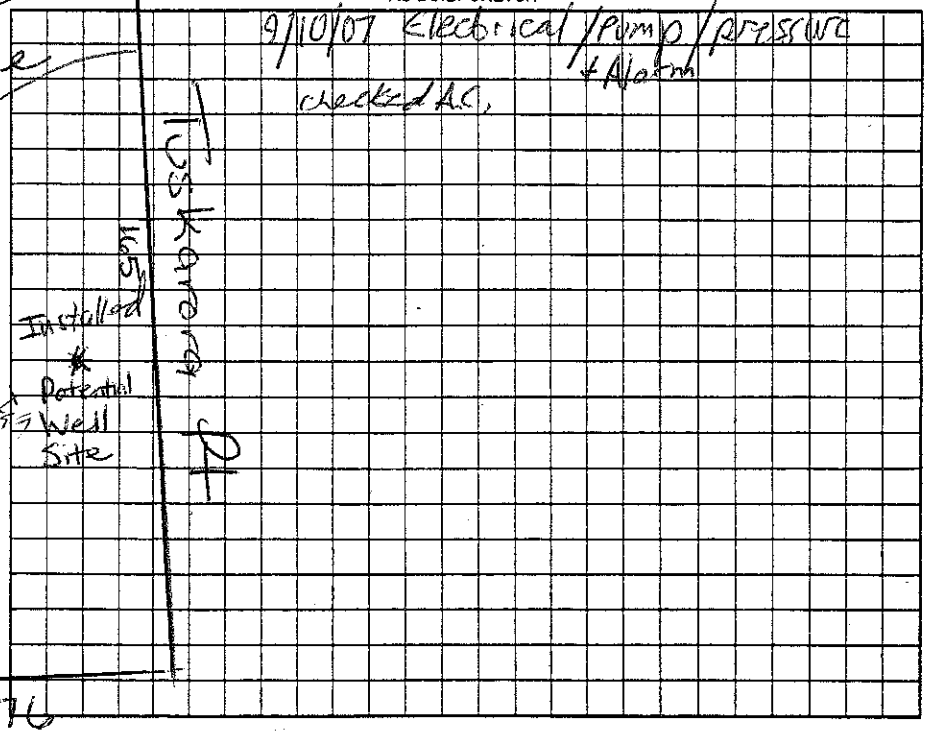

Permit can be suspended or revoked if any false information is supplied toward securing the permit/any unauthorized changes are made to the site/any unauthorized changes are made in the installation of the system. Improvement Permit with plat valid without expiration ☐ Improvement Permit with site plan valid for sixty months ☐ Authorization to Construct is valid for a period equal to that of Improvement Permit – not to exceed sixty months.

Signed: [signature] date 1-30-07 Installed by: K & H

Improvement Permit by: Maria H. Delgado RS date 1/29/07 Operation Permit by: Anthony Cokes II date 9/10/07

Authorization to Construct by: Maria H. Delgado RS date 1/30/07 Existing System Inspection by: ___ date ___

HEALTH DEPT. COPY: WHITE OWNER COPY (FINAL): YELLOW OWNER COPY (INITIAL): PINK