IREDELL COUNTY HEALTH DEPARTMENT

STATESVILLE 704-878-5305 MOORESVILLE 704-664-5281

IMPROVEMENT PERMIT / AUTHORIZATION TO CONSTRUCT / OPERATION PERMIT / EXISTING SYSTEM INSPECTION

PERMIT# 140090 PIN# 4614840390 DATE 1-29-07

OWNER OR APPLICANT Kenneth Bealer Homes Inc PHONE: Business 662-6400 Home

ADDRESS P.O. Box 3398 Mooresville, NC 28117

LOCATION Brawley School Rd TR Tuskarora Trail TR Tuskarora Point Ln on left

SUBDIVISION Tuskarora Pt BLOCK / SECTION LOT 16 LOT AREA .694 Acre SITE CLASS. PS DESIGN FLOW 480gpd L.T.A.R. .3

Septic Tank: 1000 Gallons: STB 794 Date 1-5-07
Pump Tank: 1000 Gallons: PT 27 Date 2-10-07
Pump Make: Goulds Model WE03T2MV Serial No.
Nitrification Field: No Fields 1 Square Feet 540' Linear Feet 270'
No Lines 4 Trench Width min. 24" Max Trench Bottom Depth 36" Gravel Depth N/A ☐ Gravity ☒ Pressure ☐ Slab ☐ Crawl Space ☒ Basement w/plumbing ☐ Basement wo/plumbing

☒ New System ☐ Repair ☐ Expansion System Type: I II III IV V VI
System Description: Pump-LP-Panel Blk
Repair System Description: Same
Maintenance Agreement Required: ☒ Yes ☐ No


☒ House/Mod. Home No. Bedrooms 4
☐ Mobile Home No. Persons
☐ Business No. Employees
☐ Other

Water Supply: ☒ Individual ☐ Public ☐ Community


Comments/Conditions: Note: Keep Septic System 25Ft away From basement if upslope & 15Ft if side slope or 10Ft otherwise.

Comments/Conditions: 5/2/07 Okay to do Drainfield as Installer has Lay out
5/3/07 Checked Tanks

1:40 INITIAL SITE SKETCH

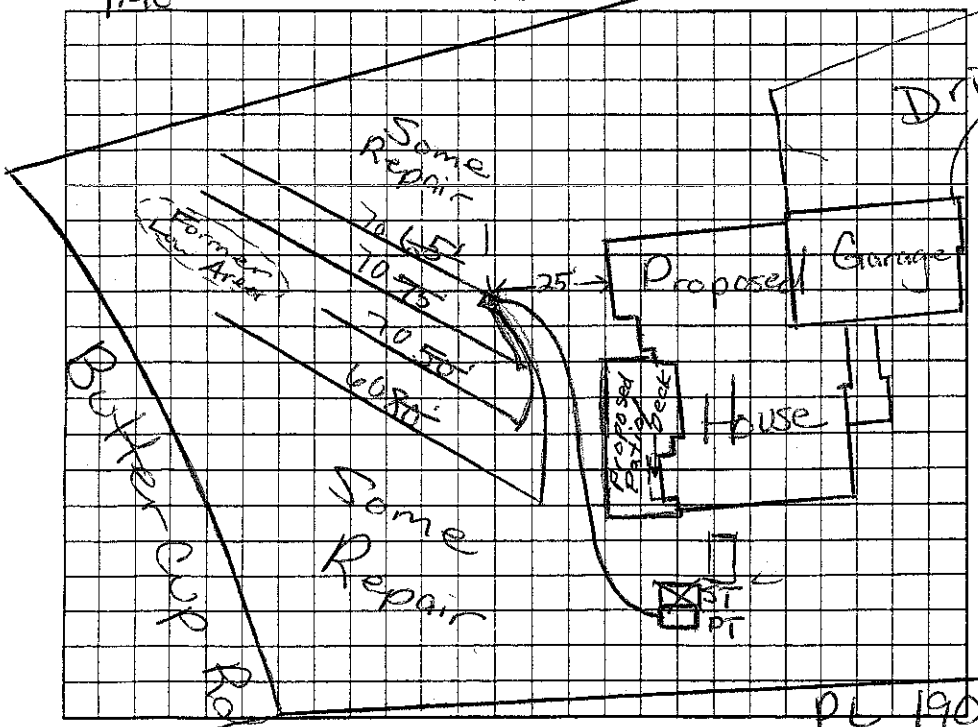

AS BUILT SKETCH

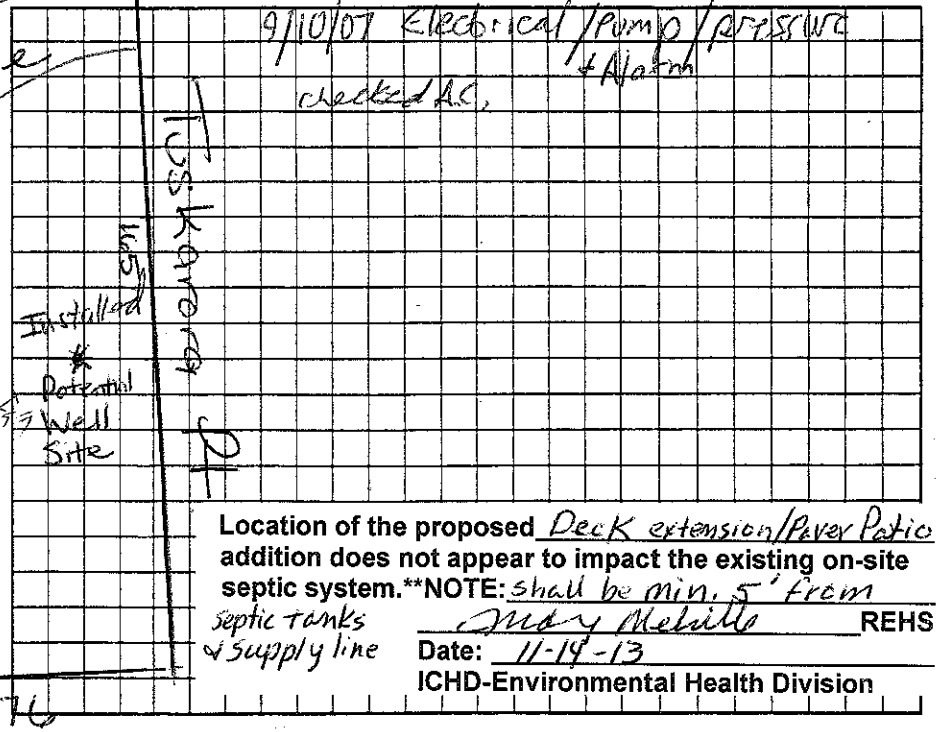

Location of the proposed Deck extension/Paver Patio **addition does not appear to impact the existing on-site septic system.**NOTE:** shall be min. 5' from septic tanks & supply line

Mary Melville REHS
Date: 11-14-13
ICHD-Environmental Health Division

Permit can be suspended or revoked if any false information is supplied toward securing the permit/any unauthorized changes are made to the site/any unauthorized changes are made in the installation of the system. Improvement Permit with plat valid without expiration ☐ Improvement Permit with site plan valid for sixty months ☐ Authorization to Construct is valid for a period equal to that of Improvement Permit – not to exceed sixty months.

Signed: [signature] date 1-30-07
Improvement Permit by: [signature] RS date 1/29/07
Authorization to Construct by: [signature] RS date 1/30/07

Installed by: K & H
Operation Permit by: Anthony Coker Jr. date 9/10/07
Existing System Inspection by: date

HEALTH DEPT. COPY: WHITE OWNER COPY (FINAL): YELLOW OWNER COPY (INITIAL): PINK