IREDELL COUNTY HEALTH DEPARTMENT

STATESVILLE 704-[illegible]-5305 #375 MOORESVILLE 704-664-5281

IMPROVEMENT PERMIT / AUTHORIZATION TO CONSTRUCT / OPERATION PERMIT / EXISTING SYSTEM INSPECTION

PERMIT# 124090 PIN# 4614-84-3346.019 4614-84-4150 DATE 10/13/04

OWNER OR CONTRACTOR Kenneth Bealer Homes, Inc PHONE: Business 704 662-6400 Home

ADDRESS PO Box 8398 Mooresville NC 28117

LOCATION BSR TR Tuskarora Tr., TR Tuskarora Pt, 1st on Lt

SUBDIVISION Tuskarora Pt. BLOCK / SECTION LOT 19 LOT AREA 0.721AC SITE CLASS PS DESIGN FLOW 480 L.T.A.R. 0.3

Septic Tank: 1000 Gallons; STB 312 Date 11/25/05
Pump Tank: 1000 Gallons; PT 333 Date 12/26/04
Pump Make: Gould's Model WE0537411M Serial No.
Nitrification Field: No Fields 1 Square Feet 810 Linear Feet 270
No Lines 3@90' Trench Width 24" DFOC Max Trench Bottom Depth 36" Gravel Depth —

☒ New System ☐ Repair System Type: I, II, III, IV, V, VI
System Description: LP Panel Block
Repair System Description: Same
Maintenance Agreement Required: ☒ Yes ☐ No

☒ House/Mod. Home No. Bedrooms 4
☐ Mobile Home No. Bathrooms
☐ Business No. Employees
☐ Other

☐ Slab ☒ Crawl Space ☐ Basement w/plumbing ☐ Basement wo/plumbing

Water Supply: ☒ Individual ☐ Public ☐ Community

Comments:/Conditions: 36" 9FOC


1"=40'

Comments:/Conditions: Tanks & lines checked by GM 3/29/05


Pres, elect & alarm checked by KM 5/27/05

Jet box needs to be raised to 1ft above grade

INITIAL SITE SKETCH

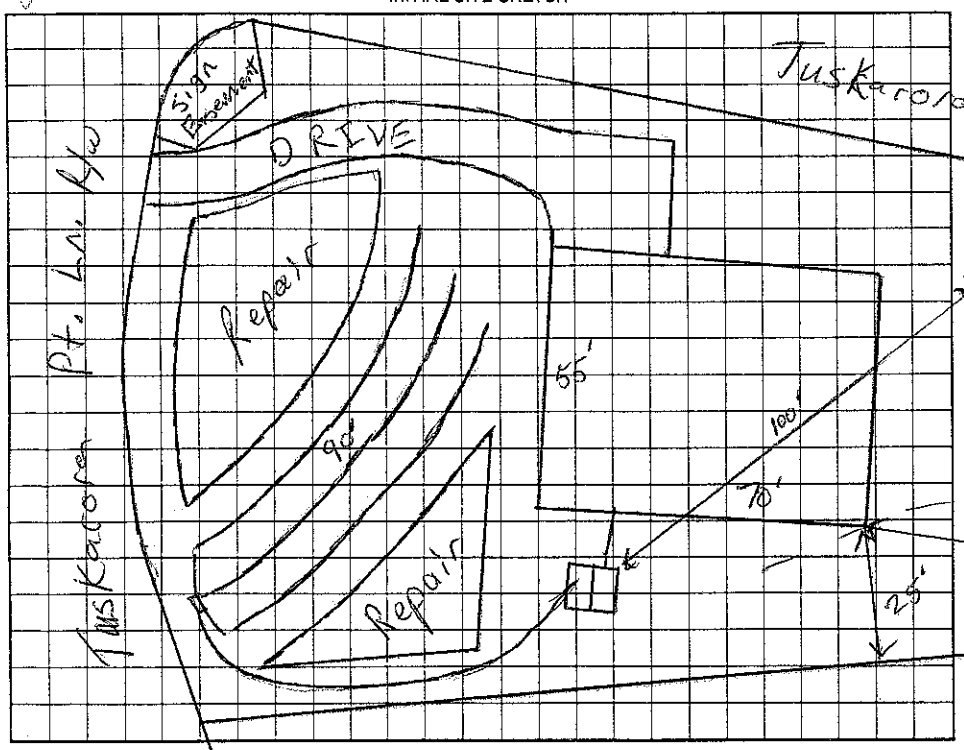

AS BUILT SKETCH

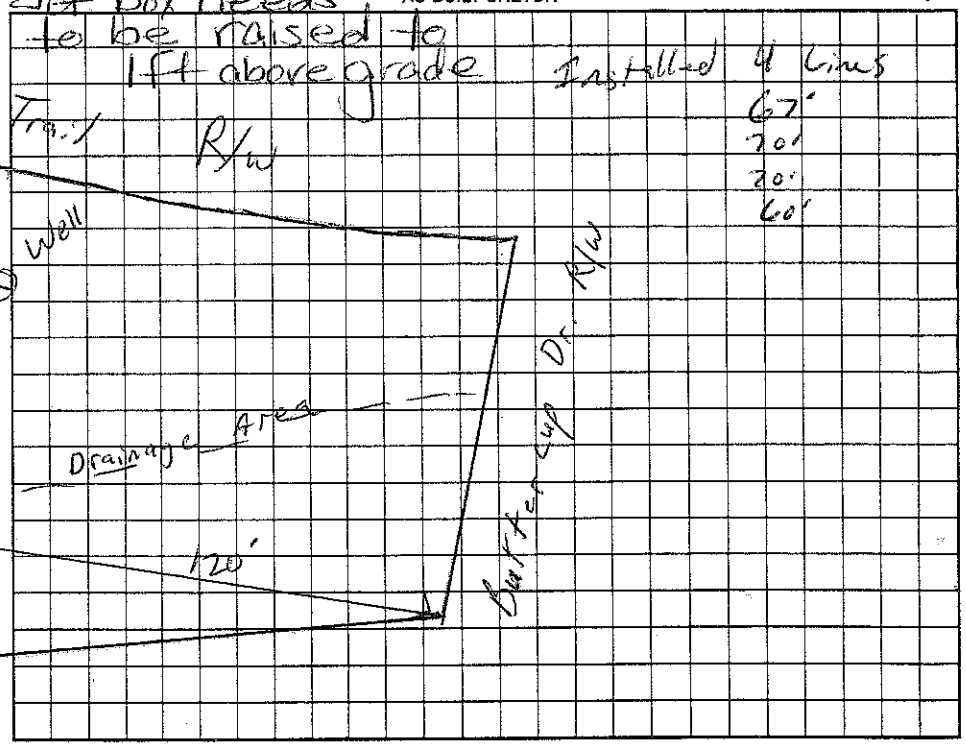

Permit can be suspended or revoked if any false information is supplied toward securing the permit/any unauthorized changes are made to the site/any unauthorized changes are made in the installation of the system. Improvement Permit with plat valid without expiration. Improvement Permit with site plan valid for sixty months. Authorization to Construct is valid for a period equal to that of Improvement Permit – not to exceed sixty months.

Signed: date 10/13/04 Installed by: R+H

Improvement Permit by: RS date 10/13/04 Operation Permit by: RS date 5/27/05

Authorization to Construct by: RS date 10/13/04 Existing System Inspection by: date

HEALTH DEPT. COPY: WHITE OWNER COPY (FINAL): YELLOW OWNER COPY (INITIAL): PINK