IREDELL COUNTY HEALTH DEPARTMENT

STATESVILLE 704-878-5305 MOORESVILLE 704-664-5281

IMPROVEMENT PERMIT / AUTHORIZATION TO CONSTRUCT / OPERATION PERMIT / EXISTING SYSTEM INSPECTION

PERMIT # 142131 PIN # 4614-84-6362 DATE 9-21-12

OWNER or APPLICANT KENNETH BEALER HOMES INC. PHONE: Business 704-662-6400 Home:

OWNER or APPLICANT ADDRESS PO BOX 3998 MOORESVILLE 28117

LOCATION / DIRECTIONS BSR, TUSK. TRAIL, TUSK. POINT LN. 1ST ON R

SUBDIVISION TUSKARORA POINT BLOCK / SECTION LOT # 3 LOT AREA .697AC DESIGN FLOW 480 L.T.A.R. .3

Septic Tank 1000 Gallons: STB 1012 Date 8-2-12
Pump Tank Gallons: P.T Date
Pump Make Model Serial #
Nitrification Field No Fields 1 No Lines 6 Linear Feet 400'
Trench Width 36" Max. Trench Bottom Depth 36" Gravel Depth

☒ New System ☐ Repair ☐ Expansion System Type I II (III) IV V VI
System Description: 25% REDUCTION
Repair System Description: PANEL
Maintenance Agreement Required ☐ YES ☒ NO
☒ GRAVITY ☐ PRESSURE


☒ Residence No. Bedrooms 4
☐ Business No. Persons
☐ Other No. Employees
☐ Slab ☒ Crawl Space
☐ Basement w/plumbing ☐ Basement w/o plumbing

Water Supply: ☒ Private ☐ Public ☐ Community


Comments / Conditions

Comments / Conditions

INITIAL SITE SKETCH

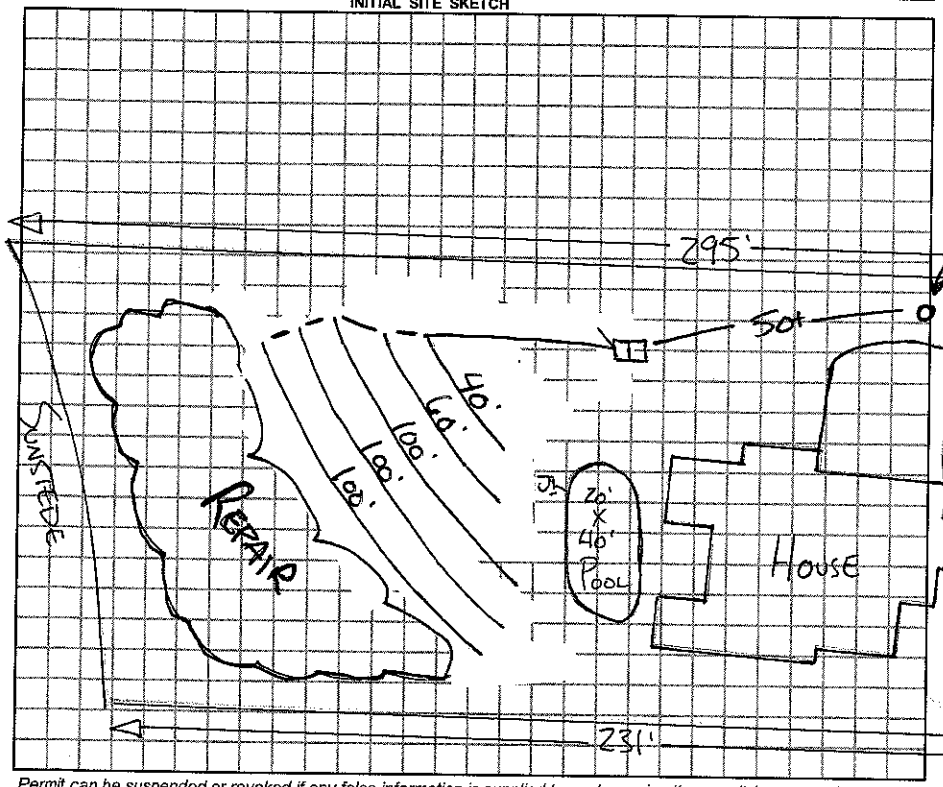

AS BUILT SKETCH

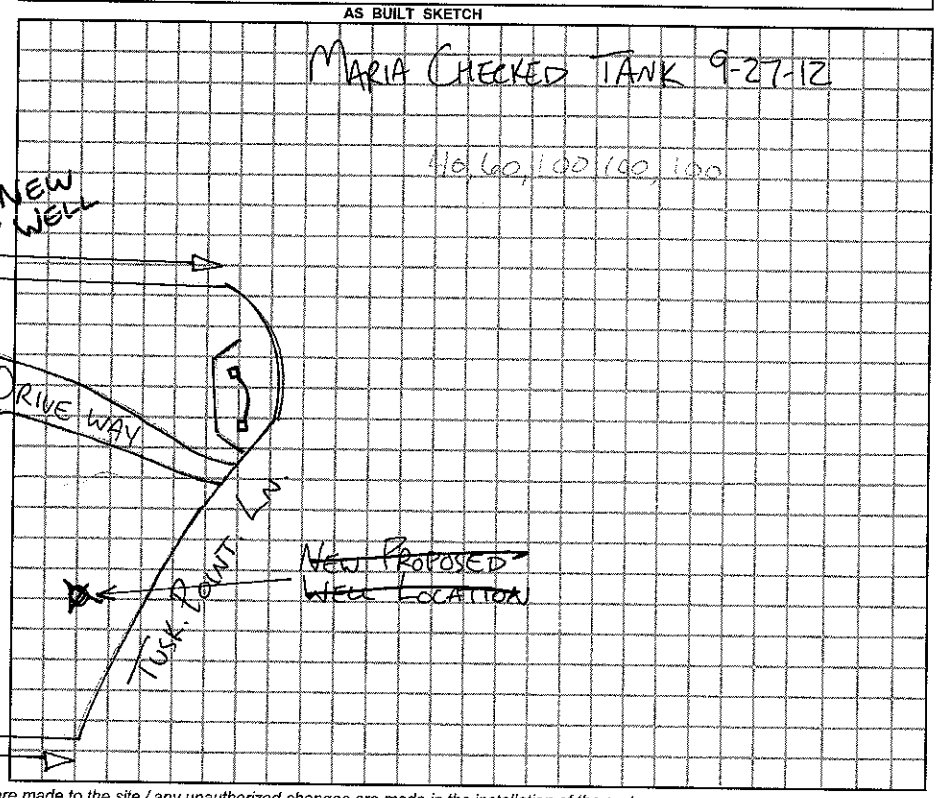

Permit can be suspended or revoked if any false information is supplied toward securing the permit / any unauthorized changes are made to the site / any unauthorized changes are made in the installation of the system.

☐ *IMPROVEMENT PERMIT w / plat valid without expiration.* ☒ *IMPROVEMENT PERMIT w / site plan valid for 60 mos.* ☒ *AUTHORIZATION TO CONSTRUCT valid for period equal to IMPROVEMENT PERMIT-not to exceed 60 mo.*

Owner / Applicant Signature: Date

Improvement Permit by: REHS Date 9-21-12

Authorzation to Construct by: REHS Date 9-21-12

YOU SHOULD CONTACT A LOCATOR SERVICE PRIOR TO ANY EXCAVATION.

Installed by: STEVEN JORDAN

Operation Permit by: Date: 11-28-12

Existing System Inspected by: Date:

WHITE COPY Environmental Health YELLOW COPY (Final) Owner / Applicant PINK COPY (Initial) Owner / Applicant