IREDELL COUNTY HEALTH DEPARTMENT

Statesville Office (704) 878-5305 Mooresville Office (704) 660-3625 PERMIT # 156639

IMPROVEMENT PERMIT / AUTHORIZATION TO CONSTRUCT / OPERATION PERMIT / EXISTING SYSTEM

PIN # 4614-84-8610

APPLICANT: Steven Cook APPLICANT ADDRESS: 118 Sunstede Dr Mooresville NC 28117

SITE ADDRESS: 118 Sunstede Dr PHONE: 704-791-1638 ALT. PHONE:


SITE DIRECTIONS: Brawley Sch Rd, TR on Tuskarora Trl, TR on Sunstede Lot on R

SUBDIVISION: SECTION: LOT # LOT AREA: 0.678 DESIGN FLOW: 360gpd L.T.A.R.: EXISTING


Septic Tank	EXISTING	(gal)	STB		Date	☐ New System	☐ Repair	☐ Expansion	System Type: I	☑ II	III	IV	V	VI	☑ Residence	No. Bedrooms	3	Water Supply
Pump Tank		(gal)	PT		Date	System Description:	EXISTING BED								☐ Business	No. Persons	6	☑ Private
Pump Make		Model			Serial #	Repair System Description:									☐ Other	No. Employees		☐ Public
# Nitrification Fields		# Lines			Linear Ft:	Maintenance Agreement Required:	☐ YES	☑ NO							☐ Slab	☑ Crawl Space		☐ Community
Trench Width		Max. Trench Bottom Depth			Gravel Depth		☑ GRAVITY	☐ PRESSURE							☐ Basement w/plumbing		☐ Basement w/o plumbing	

Comments / Conditions:

INITIAL SITE SKETCH

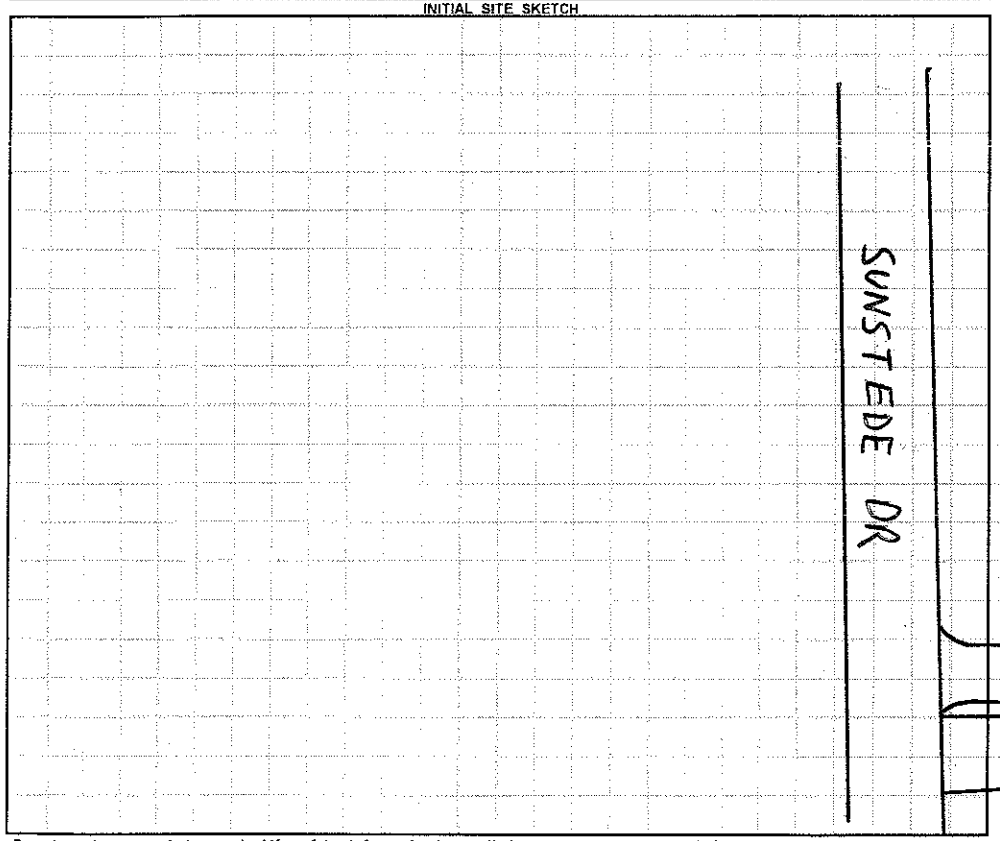

AS BUILT SKETCH

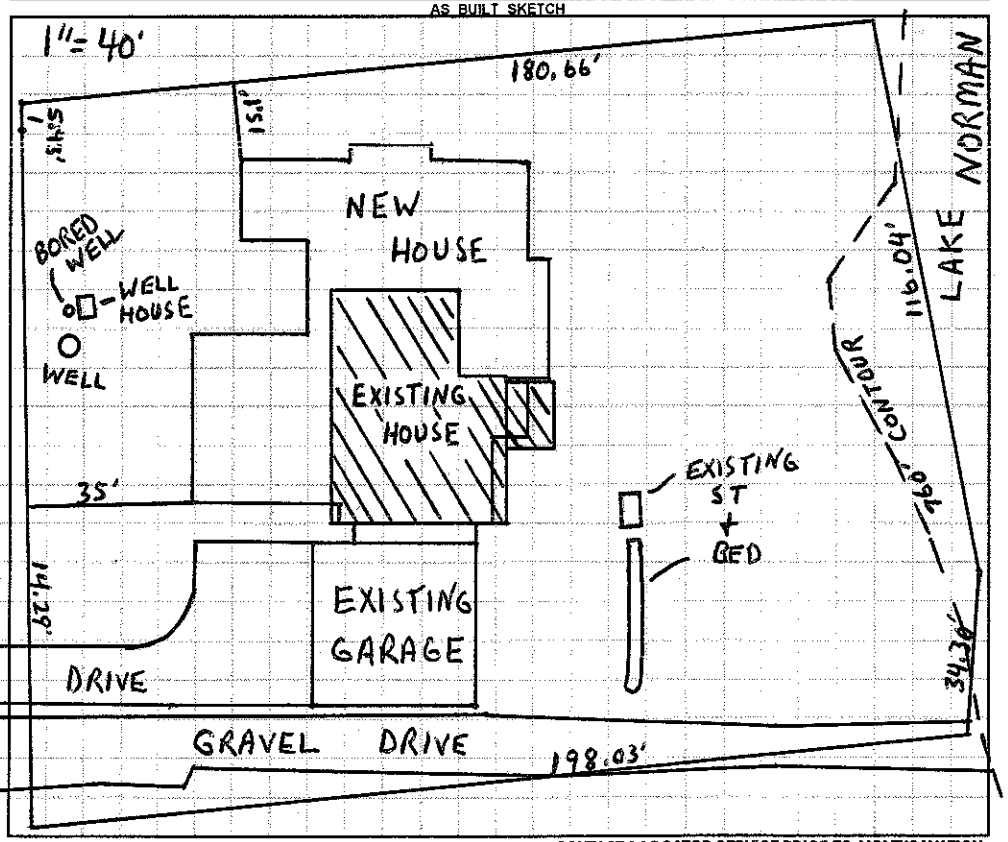

Permit can be suspended or revoked if any false information is supplied toward securing the permit / any unauthorized changes are made to the site / any unauthorized changes are made in the installation of the system. **CONTACT A LOCATOR SERVICE PRIOR TO ANY EXCAVATION**

☐ **IMPROVEMENT PERMIT** *with plat valid without expiration.* ☐ **IMPROVEMENT PERMIT** *with site plan valid for 60 mos.* ☐ **AUTHORIZATION TO CONSTRUCT** *valid for period equal to IMPROVEMENT PERMIT--not to exceed 60 mo.*

Owner / Applicant Signature: Steven Robert Cook Date: 1-16-14 Installed by:

IMPROVEMENT PERMIT by: Date: OPERATION PERMIT by: Date:

AUTHORIZATION TO CONSTRUCT by: Date: Existing System Inspected by: Chris L. Pruett Date: 1-14-14

Health Dept. Copy - WHITE Applicant (Final Approval) - YELLOW Applicant (Conditional Approval) - PINK