IREDELL COUNTY HEALTH DEPARTMENT

STATESVILLE 704-878-5305 / $30.00 Paid / MOORESVILLE 704-664-5281

IMPROVEMENT PERMIT / AUTHORIZATION TO CONSTRUCT / OPERATION PERMIT / EXISTING SYSTEM INSPECTION

PERMIT# 106397 PIN# 4614-93-2208 DATE 5/30/02

OWNER OR CONTRACTOR James C. Williams PHONE: Business 704-639-0168 Home

ADDRESS 512 Klumac Rd, Salisbury NC 28144

LOCATION Brawley School, TR Tuscarora, TL Syllabub, TR Ballycastle on Lt.

SUBDIVISION CL+T BLOCK / SECTION 6 LOT 352 LOT AREA 0.57AC SITE CLASS. PS DESIGN FLOW 360 L.T.A.R. 0.3

Septic Tank: 1000 Gallons; STB 825 Date 8/5/01
Pump Tank: Gallons; PT Date
Pump Make: Model Serial No.
Nitrification Field: No Fields 1 Square Feet 400 Linear Feet 200
No Lines 4 @ 50' Trench Width 24" Max Trench Bottom Depth 36" Gravel Depth —

☒ New System ☐ Repair System Type: I, II, (III), IV, V, VI
System Description: Gravity Panel Block
Repair System Description: Pump Panel Block
Maintenance Agreement Required: ☐ Yes ☒ No


☒ House/Mod. Home No. Bedrooms 3
☐ Mobile Home No. Bathrooms 2
☐ Business No. Employees
☐ Other
☐ Slab ☒ Crawl Space ☐ Basement w/plumbing ☐ Basement wo/plumbing

Water Supply: ☒ Individual ☐ Public ☐ Community
Existing


Comments:/Conditions:

Comments:/Conditions:

INITIAL SITE SKETCH

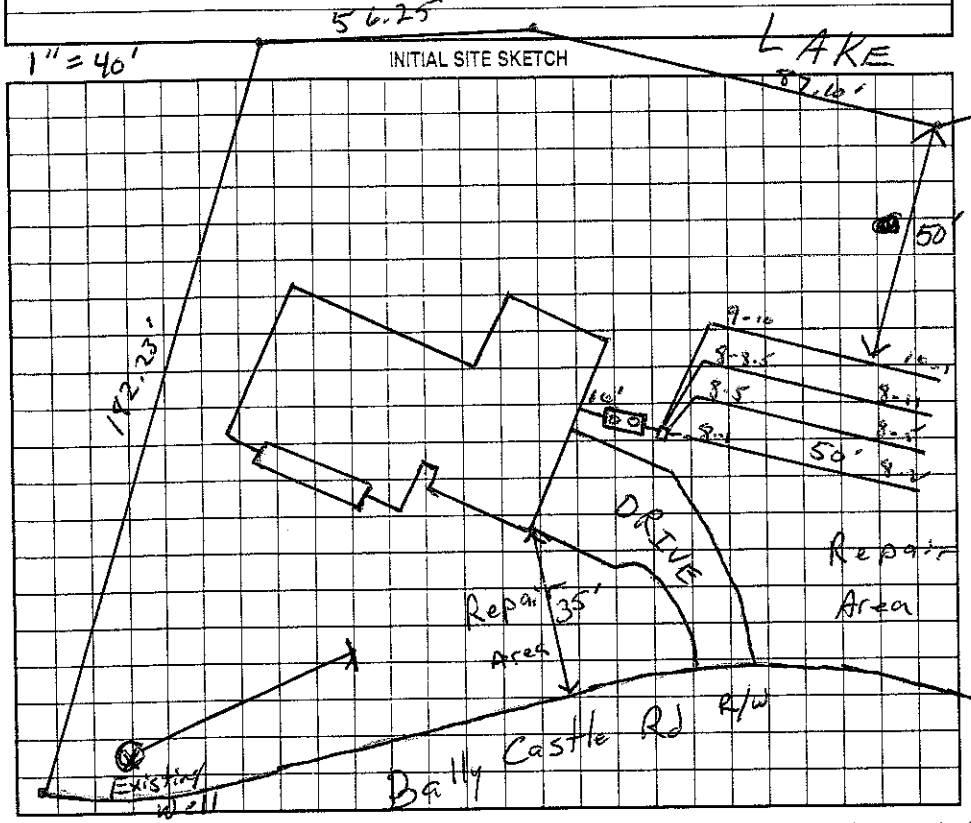

AS BUILT SKETCH

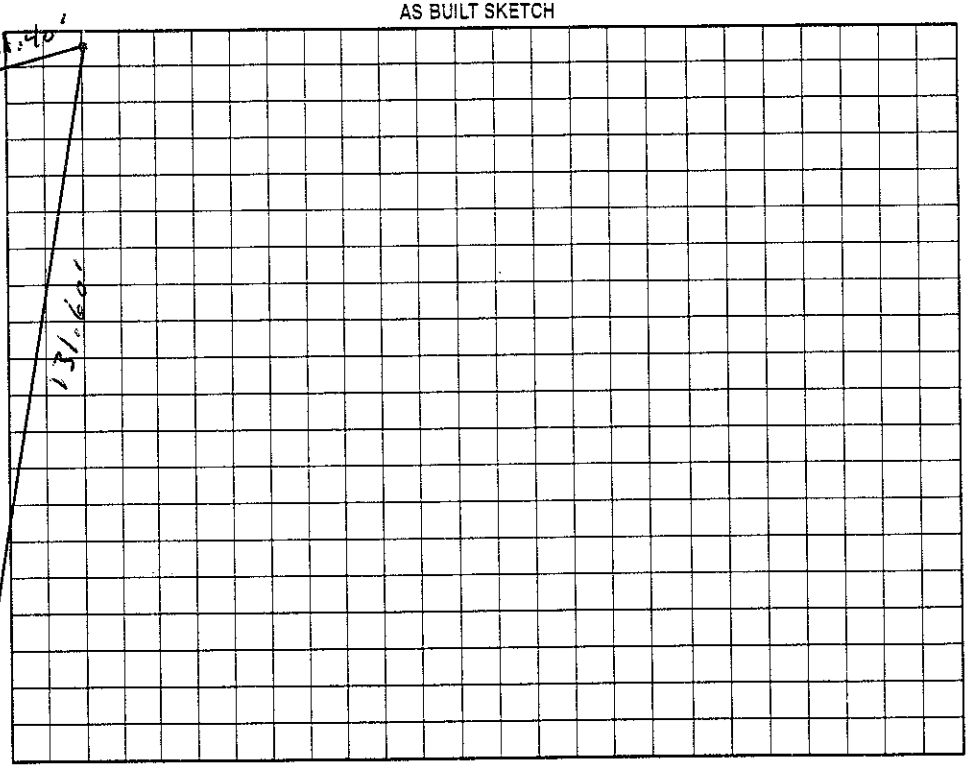

Permit can be suspended or revoked if any false information is supplied toward securing the permit/any unauthorized changes are made to the site/any unauthorized changes are made in the installation of the system. Improvement Permit with plat valid without expiration. Improvement Permit with site plan valid for sixty months. Authorization to Construct is valid for a period equal to that of Improvement Permit – not to exceed sixty months.

Signed: date 5/05/02 Installed by: Bangor Septic Service

Improvement Permit by: RS date 5/30/02 Operation Permit by: Wesley Sparks RS. date 10/9/02

Authorization to Construct by: RS date 5/30/02 Existing System Inspection by: date

HEALTH DEPT. COPY: WHITE OWNER COPY (FINAL): YELLOW OWNER COPY (INITIAL): PINK