IREDELL COUNTY HEALTH DEPARTMENT

STATESVILLE 704-878-5305 MOORESVILLE 704-664-5281

IMPROVEMENT PERMIT / AUTHORIZATION TO CONSTRUCT / OPERATION PERMIT / EXISTING SYSTEM INSPECTION

PERMIT # 16378 PIN # 4614942072 DATE 9-28-2010

OWNER or APPLICANT Kenneth Bealer Homes PHONE: Business 704 662-6400 Home: Len Bealer 704 363-8900

OWNER or APPLICANT ADDRESS P.O. Box 3398 Mooresville, NC 28117

LOCATION / DIRECTIONS BSR to Tuskamma Trail TL Syllabub on left at Syllabub

SUBDIVISION Thunderhill Park BLOCK / SECTION LOT # 4 LOT AREA 1.037 DESIGN FLOW 360gpd L.T.A.R. .25

Septic Tank 1000 Gallons: STB 312 Date 1-4-11

Pump Tank Gallons: P T Date

Pump Make Model Serial #

Nitrification Field No Fields 1 No Lines 3 Linear Feet 360'

Trench Width 36" Max. Trench Bottom Depth 36" Gravel Depth N/A

☒ New System ☐ Repair ☐ Expansion System Type I II III IV V VI

System Description: Gravity - 25% Reduction

Repair System Description: Pump / Grav. 25% Reduct

Maintenance Agreement Required ☐ YES ☒ NO

☒ GRAVITY ☐ PRESSURE

☒ Residence No. Bedrooms 3

☐ Business No. Persons

☐ Other No. Employees

☐ Slab ☒ Crawl Space


☐ Basement w/plumbing ☐ Basement w/o plumbing

Water Supply: ☒ Private ☐ Public ☐ Community


Comments / Conditions: Keep Drainlines at least 15Ft from Road Cut, 10Ft from PL & 10Ft from House

Comments / Conditions: Installed ADS 36" Plastic Chambers

INITIAL SITE SKETCH

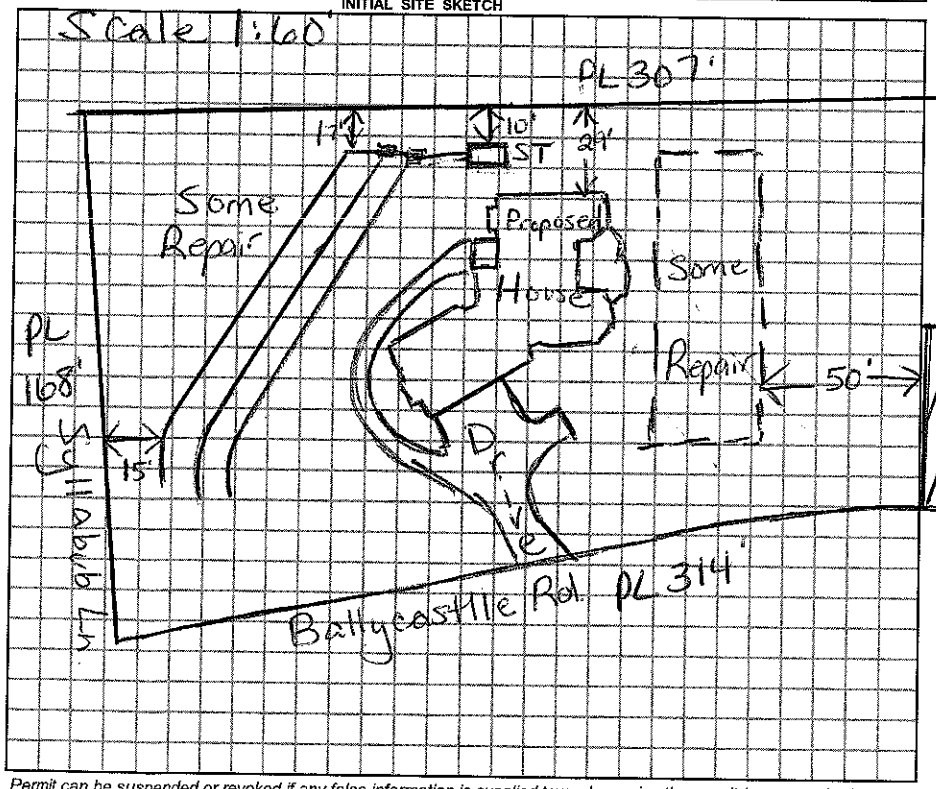

AS BUILT SKETCH

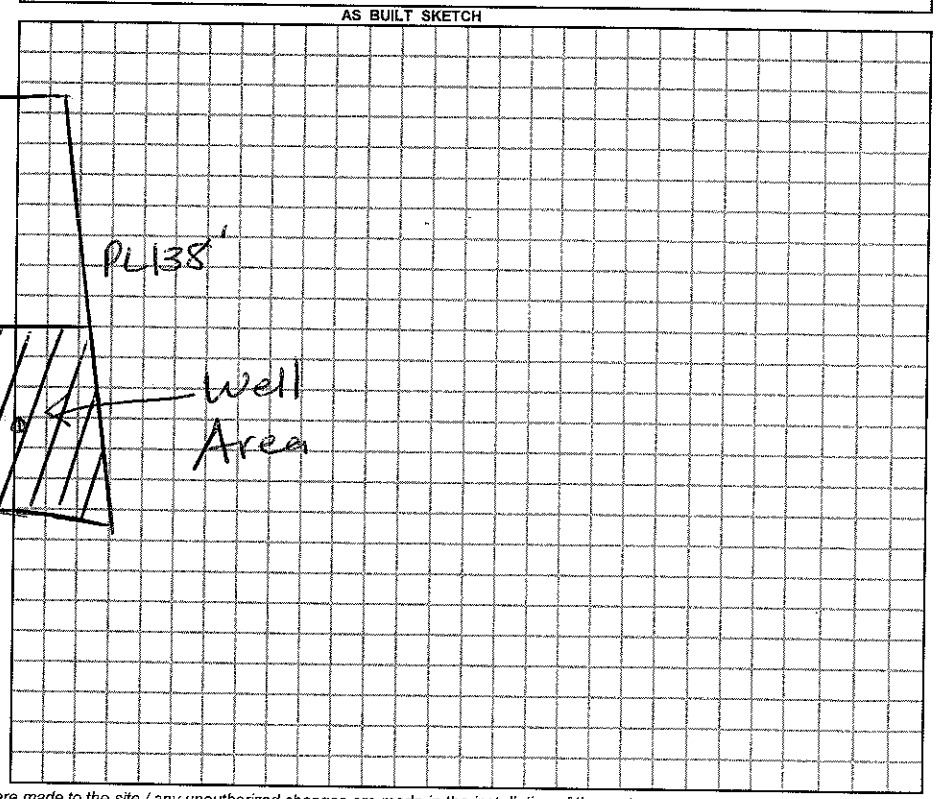

Permit can be suspended or revoked if any false information is supplied toward securing the permit / any unauthorized changes are made to the site / any unauthorized changes are made in the installation of the system.

☐ *IMPROVEMENT PERMIT w / plat valid without expiration.* ☐ *IMPROVEMENT PERMIT w / site plan valid for 60 mos.* ☐ *AUTHORIZATION TO CONSTRUCT valid for period equal to IMPROVEMENT PERMIT-not to exceed 60 mo.*

Owner / Applicant Signature: X Kenneth Bealer Homes, Inc By: Date 9/29/2010

Improvement Permit by: Date 9/28/2010

Authorization to Construct by: Date 9/28/2010

YOU SHOULD CONTACT A LOCATOR SERVICE PRIOR TO ANY EXCAVATION.

Installed by: RS

Operation Permit by: Date: 4/15/2011

Existing System Inspected by: Date:

WHITE COPY Environmental Health YELLOW COPY (Final) Owner / Applicant PINK COPY (Initial) Owner / Applicant