gm

IREDELL COUNTY HEALTH DEPARTMENT

STATESVILLE 704-878-5305 MOORESVILLE 704-664-5281

IMPROVEMENT PERMIT / AUTHORIZATION TO CONSTRUCT / OPERATION PERMIT / EXISTING SYSTEM INSPECTION

PERMIT # 175986 PIN # 4614954934 DATE 12/5/12

OWNER or APPLICANT STEVE TOTH/PERRY SARLES PHONE: Business Home: 828 414 0001

OWNER or APPLICANT ADDRESS 132 LUCENT LN, MOORESVILLE NC 28117

LOCATION / DIRECTIONS BRAWLEY SCHOOL - TR TUSCAROLA - TR LUCENT - 4TH ON RT

SUBDIVISION CLT BLOCK / SECTION C LOT # 250 LOT AREA .71AC DESIGN FLOW L.T.A.R.

Septic Tank EXISTING Gallons: STB Date

Pump Tank Gallons: P T Date

Pump Make Model Serial #

Nitrification Field No Fields 1 No Lines 1 Linear Feet 50' X 12'

Trench Width 12' Max. Trench Bottom Depth EXISTING Gravel Depth EXISTING

☑ New System ☐ Repair ☐ Expansion System Type I II III IV V VI

System Description: GRAVITY BED 12' X 50'

Repair System Description:

Maintenance Agreement Required ☐ YES ☑ NO

☑ GRAVITY ☐ PRESSURE

☑ Residence No. Bedrooms 3

☐ Business No. Persons 0

☐ Other No. Employees

☐ Slab ☑ Crawl Space

☐ Basement w/plumbing ☐ Basement w/o plumbing


Water Supply: ☑ Private ☐ Public ☐ Community

Comments / Conditions

1" = 50'

Comments / Conditions

SITE SKETCH

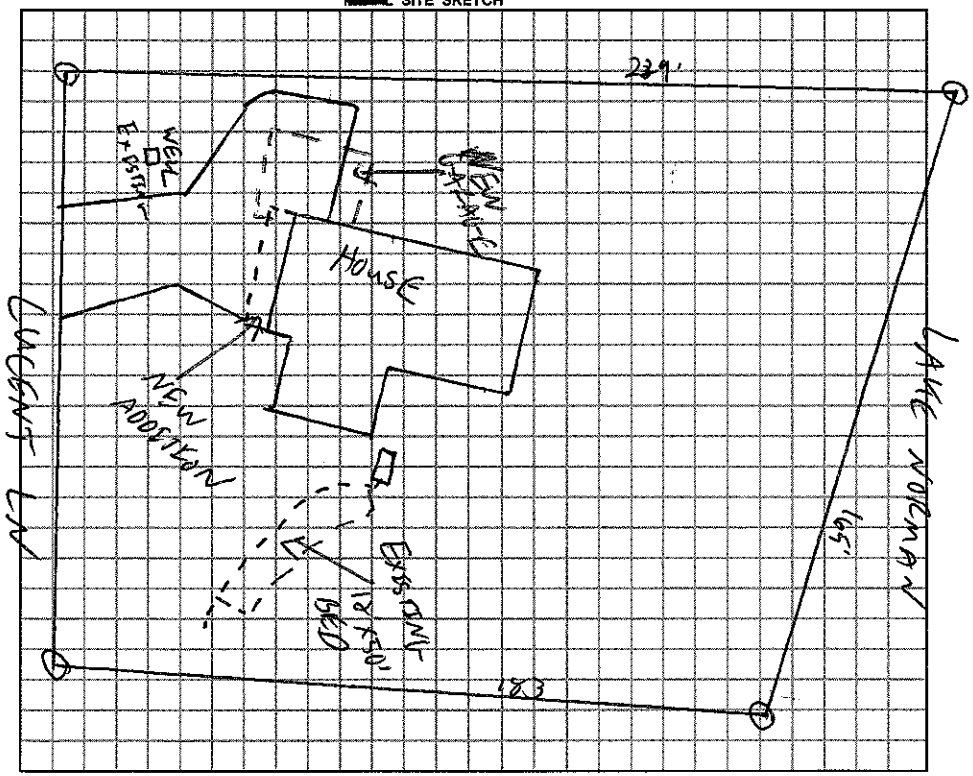

AS BUILT SKETCH

Permit can be suspended or revoked if any false information is supplied toward securing the permit / any unauthorized changes are made to the site / any unauthorized changes are made in the installation of the system.

☐ *IMPROVEMENT PERMIT w / plat valid without expiration.* ☐ *IMPROVEMENT PERMIT w / site plan valid for 60 mos.* ☐ *AUTHORIZATION TO CONSTRUCT valid for period equal to IMPROVEMENT PERMIT-not to exceed 60 mo.*

Owner / Applicant Signature: Date 12-7-12 Installed by:

Improvement Permit by: C. REHS Date 12/5/12 Operation Permit by: Date:

Authorization to Construct by: C. REHS Date 12/5/12 Existing System Inspected by: C. REHS Date: 12/6/12

YOU SHOULD CONTACT A LOCATOR SERVICE PRIOR TO ANY EXCAVATION.

WHITE COPY Environmental Health YELLOW COPY (Final) Owner / Applicant PINK COPY (Initial) Owner / Applicant