IREDELL COUNTY HEALTH DEPARTMENT

Statesville Office (704) 878-5305 Mooresville Office (704) 660-3625 PERMIT # 208793 V

IMPROVEMENT PERMIT / AUTHORIZATION TO CONSTRUCT / OPERATION PERMIT / EXISTING SYSTEM

PIN # 4614-95-4934

APPLICANT: PERRY SARLES APPLICANT ADDRESS: 132 LUCENT LN MOORESVILLE NC 28117

SITE ADDRESS: 132 LUCENT LN PHONE: ALT. PHONE:

SITE DIRECTIONS: BRAWLEY SCH RD, TR ON TUSKARORA TRL, TR ON LUCENT LN, 4TH HOUSE ON R

SUBDIVISION: CL&T SECTION: 6 LOT # 250 LOT AREA: 0.74 AC DESIGN FLOW: L.T.A.R.:

Septic Tank EXISTING (gal) STB Date
Pump Tank (gal) PT Date
Pump Make Model Serial #
Nitrification Fields 1 # Lines EXISTING Linear Ft: 78'
Trench Width Max. Trench Bottom Depth EXISTING Gravel Depth EXISTING

☐ New System ☐ Repair ☐ Expansion System Type: I II III IV V VI
System Description: GRAVEL BED (EXISTING)
Repair System Description:
Maintenance Agreement Required: ☐ YES ☑ NO
☑ GRAVITY ☐ PRESSURE

☑ Residence No. Bedrooms
☐ Business No. Persons
☐ Other No. Employees
☐ Slab ☑ Crawl Space
☐ Basement w/plumbing ☐ Basement w/o plumbing


Water Supply: ☑ Private ☐ Public ☐ Community

Comments / Conditions:

- Septic System Appeared to be functioning at time of inspection 3-30-15
- This permit is for the addition/expansion of a deck only, no increase in wastewater flow.

INITIAL SITE SKETCH

AS BUILT SKETCH

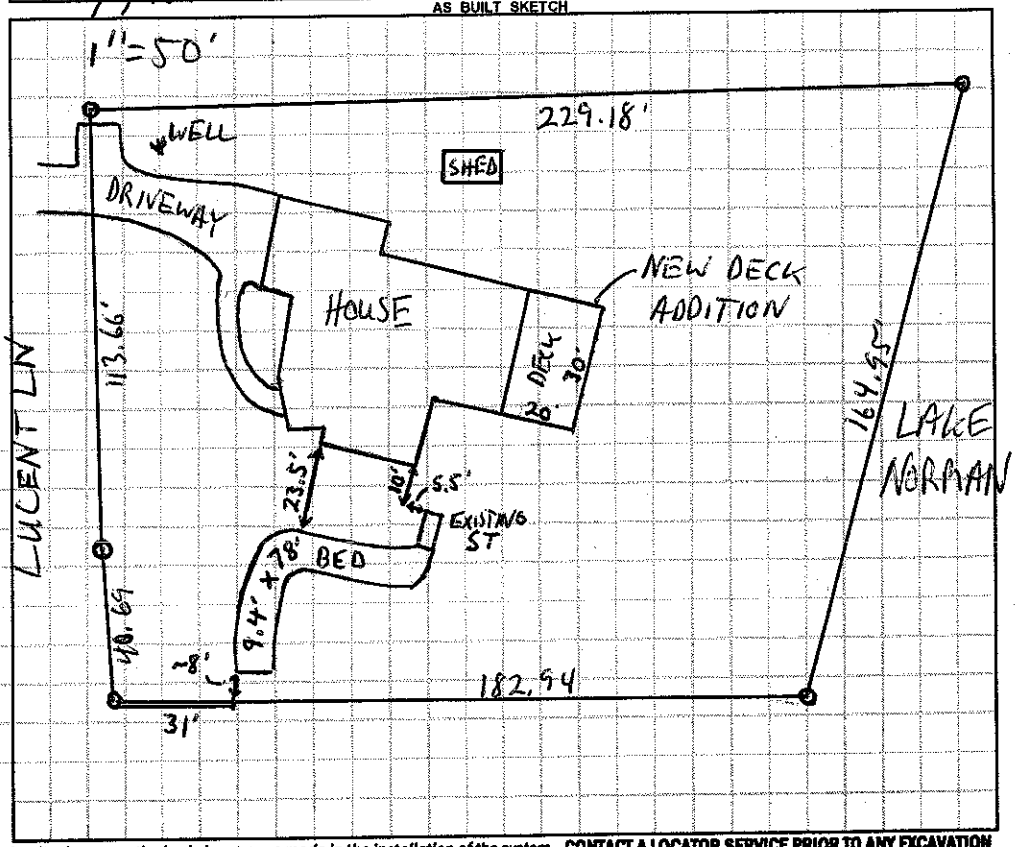

Permit can be suspended or revoked if any false information is supplied toward securing the permit / any unauthorized changes are made to the site / any unauthorized changes are made in the installation of the system. **CONTACT A LOCATOR SERVICE PRIOR TO ANY EXCAVATION**

☐ **IMPROVEMENT PERMIT** *with plat valid without expiration.* ☐ **IMPROVEMENT PERMIT** *with site plan valid for 60 mos.* ☐ **AUTHORIZATION TO CONSTRUCT** *valid for period equal to IMPROVEMENT PERMIT--not to exceed 60 mo.*

Owner / Applicant Signature: Perry Sarles Date: 4/6/15 Installed by:

IMPROVEMENT PERMIT by: Date: OPERATION PERMIT by: Date:

AUTHORIZATION TO CONSTRUCT by: Date: Existing System Inspected by: AC & Plat Date: 4-1-15

Health Dept. Copy - WHITE Applicant (Final Approval) - YELLOW Applicant (Conditional Approval) - PINK