1:00

IREDELL COUNTY HEALTH DEPARTMENT - *ENVIRONMENTAL HEALTH* ☐ STATESVILLE OFFICE 704-878-5305 ☒ MOORESVILLE OFFICE 704-664-5281

IMPROVEMENT PERMIT / AUTHORIZATION TO CONSTRUCT / OPERATION PERMIT / EXISTING SYSTEM INSPECTION

PERMIT # 11713 PIN # 4614-95-5265 DATE 5-3-12

OWNER NATHAN CRUTCHFIELD APPLICANT: SAME PHONE: Home/Cell # 704-245-4753 Business #

SITE ADDRESS 000 TUSK. TRAIL OWNER / APPLICANT ADDRESS

SITE DIRECTIONS BSR, TUSK. TRAIL, ON R PAST LUCENT

SUBDIVISION ROCK SPRING PARK BLOCK / SECTION LOT # 1 LOT AREA .79 AC DESIGN FLOW 480 L.T.A.R. .3

Septic Tank 1000 Gallons: STB 794 Date 6-2-12 ☒ New System ☐ Repair ☐ Expansion System Type I II (III) IV V VI

Pump Tank Gallons: P T Date System Description: GRAVITY 25%

Pump Make Model Serial # Repair System Description: PANEL BLOCK

No. Nitrification Fields: 1 No. Lines 5 Linear Feet 400' Maintenance Agreement Required ☐ YES ☒ NO

Trench Width 36" Max. Trench Bottom Depth 36" Gravel Depth — ☒ GRAVITY ☐ PRESSURE

☒ Residence No. Bedrooms 4 ☐ Business No. Persons ☐ Other No. Employees ☒ Slab ☒ Crawl Space ☐ Basement w/plumbing ☐ Basement w/o plumbing


Water Supply: ☒ Private ☐ Public ☐ Community

Comments / Conditions

① Pool Inside Building Envelope Must Be 15' From Septic

Note: 4" from back of House to Drainfield & ST

INITIAL SITE SKETCH

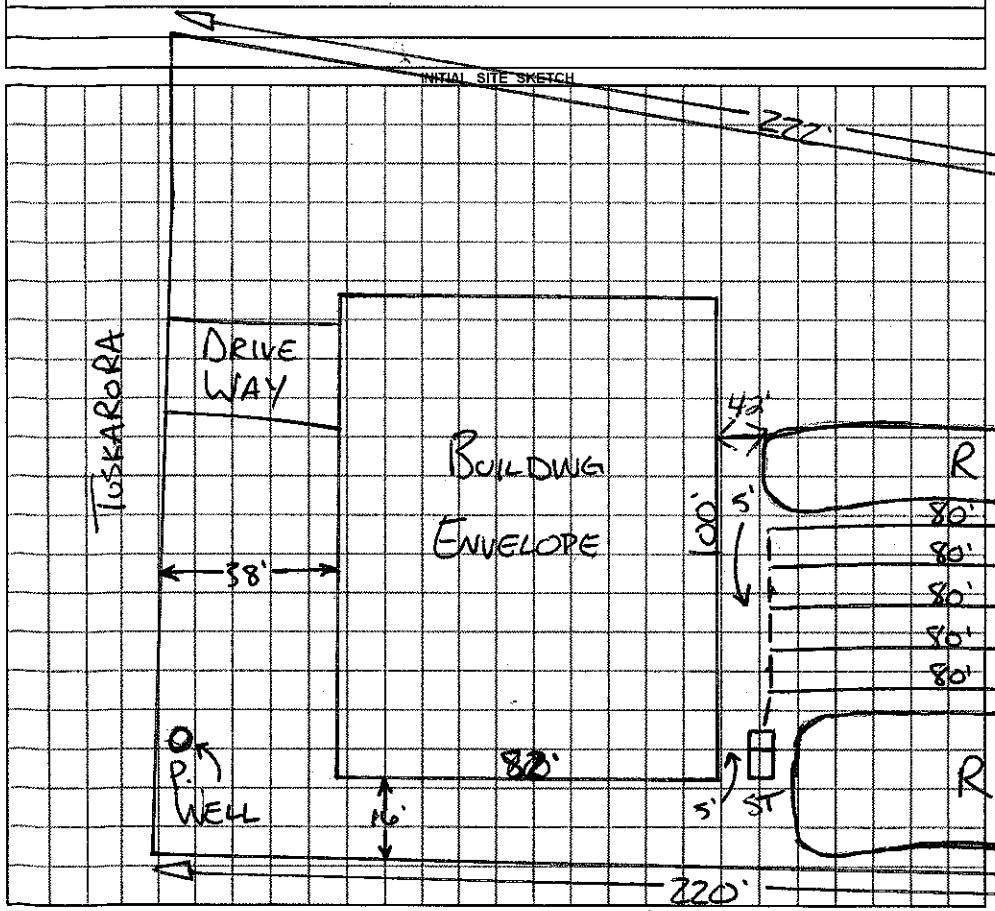

AS BUILT SKETCH

1"=40'

Installed Infiltrator Quick 4 Serial Distribution

The proposed / existing GARAGE W/ 1 BEDROOM addition does not appear to impact the existing septic system.

**NOTE: 1BR IN GARAGE, 3BR IN MAIN HOUSE

R.S.

Date: 7-11-13

ICHD-Environmental Health Division

GARAGE TO FIT IN BUILDING ENVELOPE SHOWN

Permit can be suspended or revoked if any false information is supplied toward securing the permit / any unauthorized changes are made to the site / any unauthorized changes are made in the installation of the system.

☐ *IMPROVEMENT PERMIT* with plat valid without expiration. ☒ *IMPROVEMENT PERMIT* with plat valid without expiration. site plan valid 60 mo. ☒ *AUTHORIZATION TO CONSTRUCT* valid for period equal to IMPROVEMENT PERMIT--not to exceed 60 mo.

Owner / Applicant Signature: Date 5-4-12 Installed by: Groundbreakers

IMPROVEMENT PERMIT by: REHS Date 5-3-12 OPERATION PERMIT by: REHS Date 7/26/12

AUTHORIZATION TO CONSTRUCT by: REHS Date 5-4-12 Existing System Inspected by: REHS Date

YOU SHOULD CONTACT A LOCATOR SERVICE PRIOR TO ANY EXCAVATION

White Copy -- Environmental Health YELLOW COPY (Final) Owner / Applicant PINK COPY (Initial) Owner / Applicant