DELL COUNTY HEALTH DEPARTMENT

Statesville Office (704) 878-5305 Mooresville Office (704) 660-3625

...OVEMENT PERMIT / AUTHORIZATION TO CONSTRUCT / OPERATION PERMIT / EXISTING SYSTEM

PERMIT # 202055

PIN # 4614-95-6348

APPLICANT: LKN LAND LLC

APPLICANT ADDRESS: 454 BSR Mooresville, NC

SITE ADDRESS: 302 TUSKARORA TRAIL Mooresville, NC 28117

PHONE: 704-578-4951 ALT. PHONE:

SITE DIRECTIONS: BSR, TR TUSKARORA, ON R

SUBDIVISION: ROCK SPRING PARK

SECTION: LOT # 2 LOT AREA: .732 AC

DESIGN FLOW: 480 L.T.A.R.: .3 (.35R)

Septic Tank	1000 (gal)	STB	1617	Date	9/24/15
Pump Tank	— (gal)	PT	—	Date	—
Pump Make	—	Model	—	Serial #	—
# Nitrification Fields	1	# Lines	5	Linear Ft:	400'
Trench Width	36"	Max. Trench Bottom Depth	24"	Gravel Depth	—

☑ New System ☐ Repair ☐ Expansion System Type: I II (III) IV V VI

System Description: 25% REDUCTION

Repair System Description: PANEL BLOCK

Maintenance Agreement Required: ☐ YES ☑ NO

☑ GRAVITY ☐ PRESSURE

☑ Residence No. Bedrooms 4

☐ Business No. Persons 8

☐ Other No. Employees —

☐ Slab ☑ Crawl Space

☐ Basement w/plumbing ☐ Basement w/o plumbing

Water Supply: ☑ Private ☐ Public ☐ Community

Comments / Conditions: Recommend pumping septic tank every 3-5 years.

INITIAL SITE SKETCH

SEE PLAN FROM THE OAKS GROUP

AS BUILT SKETCH

Not installed as shown.

Permit can be suspended or revoked if any false information is supplied toward securing the permit / any unauthorized changes are made to the site / any unauthorized changes are made in the installation of the system. **CONTACT A LOCATOR SERVICE PRIOR TO ANY EXCAVATION**

☐ **IMPROVEMENT PERMIT** *with plat valid without expiration.*

☒ **IMPROVEMENT PERMIT** *with site plan valid for 60 mos.*

☑ **AUTHORIZATION TO CONSTRUCT** *valid for period equal to IMPROVEMENT PERMIT--not to exceed 60 mo.*

Owner / Applicant Signature: Kathleen Saunders Date: 4-19-16

IMPROVEMENT PERMIT by: APPROVED APR 15 2016 Date:

AUTHORIZATION TO CONSTRUCT by: APPROVED APR 15 2016 Date:

Installed by: Piedmont Backhoe


OPERATION PERMIT by: Date: 9/30/16

Existing System Inspected by: Date:

Health Dept. Copy - WHITE Applicant (Final Approval) - YELLOW Applicant (Conditional Approval) - PINK

PRELIMINARY PLAT
NOT FOR RECORDATION,
CONVEYANCES, OR SALES.

APPROVED APR 15 2016

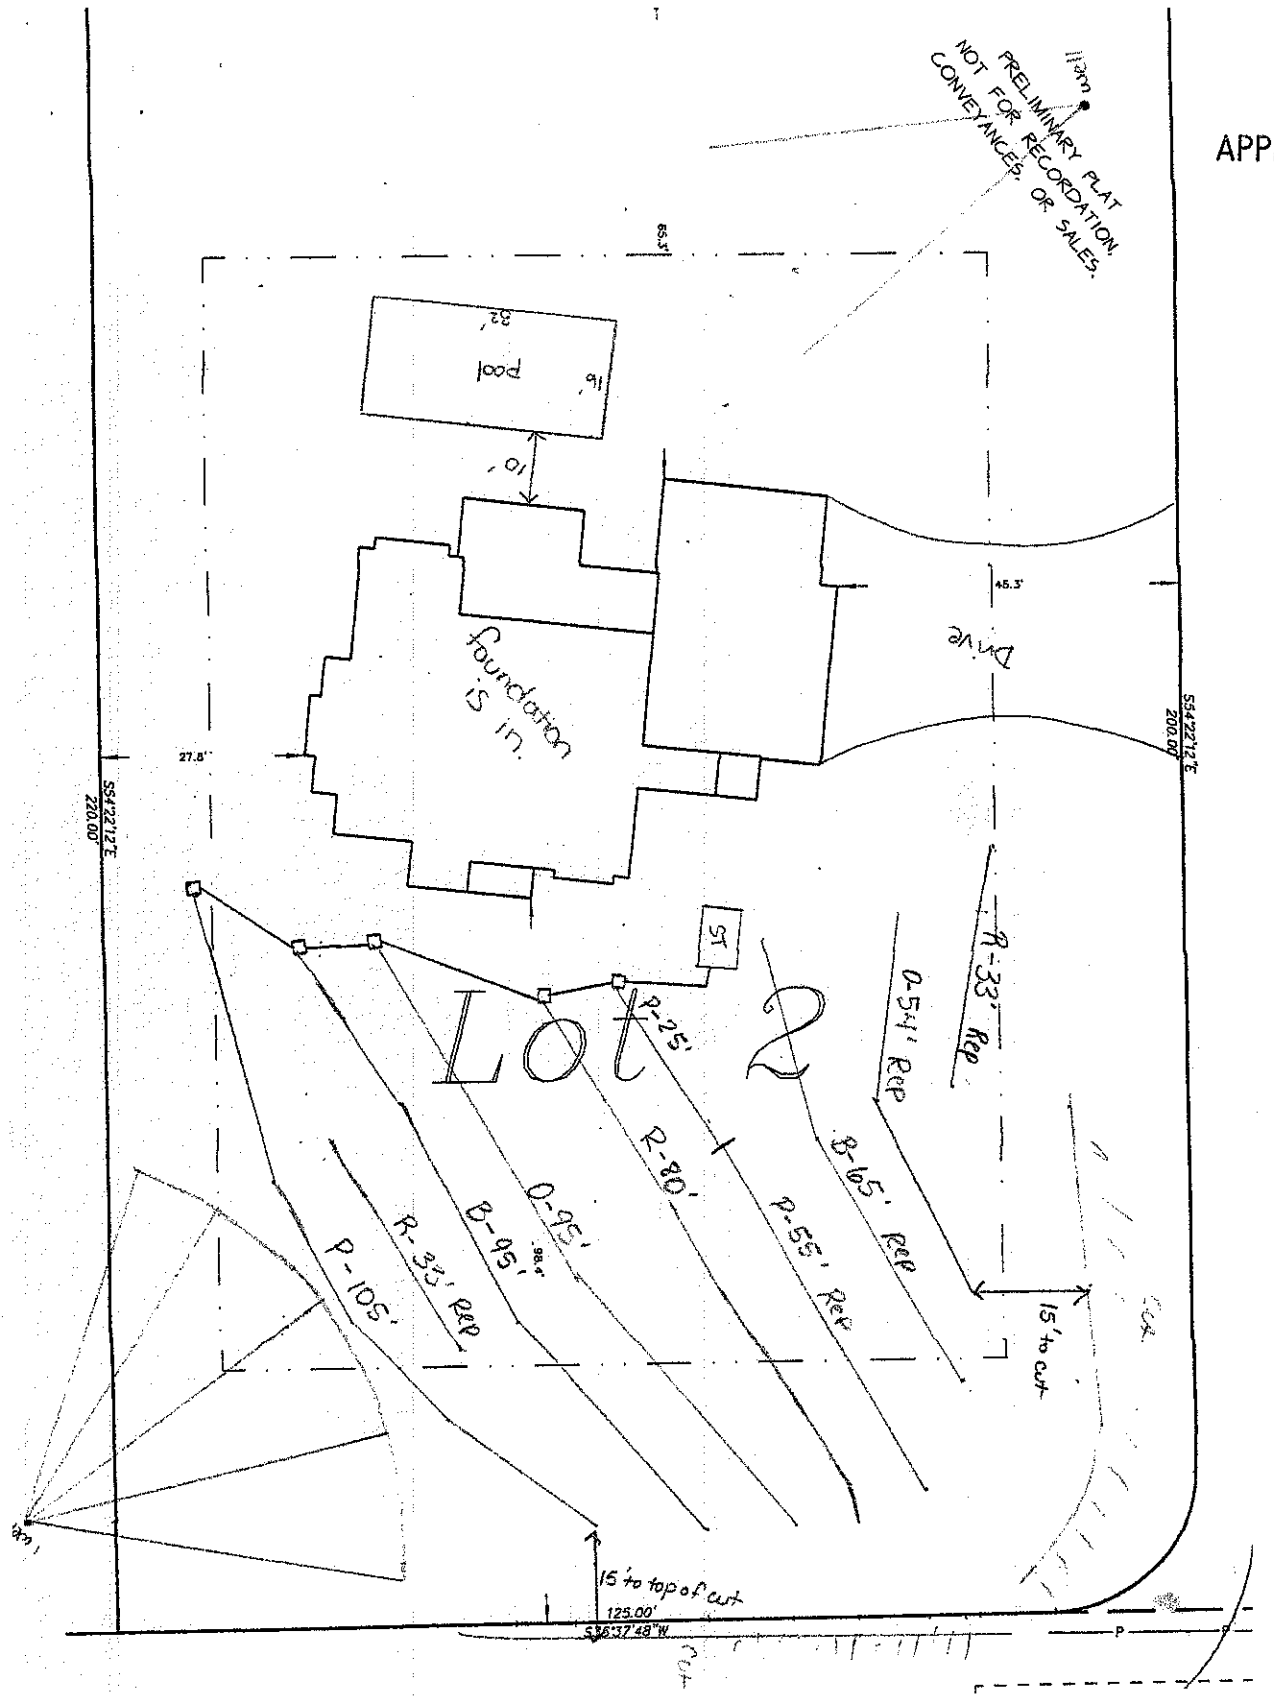

1"=20'

N