IREDELL COUNTY HEALTH DEPARTMENT

Statesville Office (704) 878-5305 Mooresville Office (704) 660-3625 PERMIT # 176146

IMPROVEMENT PERMIT / AUTHORIZATION TO CONSTRUCT / OPERATION PERMIT / EXISTING SYSTEM

PIN # 4614958655

APPLICANT: Kenneth Bealer Homes APPLICANT ADDRESS: Po Box 3398 Mville 28117

SITE ADDRESS: 000 Tuskarora Tr. PHONE: 704-662-6400 ALT. PHONE:

SITE DIRECTIONS: RSR, Tusk. on R


SUBDIVISION: Rock Spring Park SECTION: LOT # 4 LOT AREA: .911 AC DESIGN FLOW: 480 L.T.A.R.: .3

Septic Tank	1000 (gal)	STB	1012	Date	10-30-12	☒ New System	☐ Repair	☐ Expansion	System Type: I II (III) IV V VI	☒ Residence	No. Bedrooms 4	Water Supply
Pump Tank	(gal)	PT		Date		System Description:		25% Reduction		☐ Business	No. Persons	☒ Private
Pump Make		Model		Serial #		Repair System Description:		Drip		☐ Other	No. Employees	☐ Public
# Nitrification Fields	1	# Lines	4	Linear Ft:	400'	Maintenance Agreement Required:	☐ YES	☒ NO		☒ Slab	☐ Crawl Space	☐ Community
Trench Width	36"	Max. Trench Bottom Depth	36"	Gravel Depth			☒ GRAVITY	☐ PRESSURE		☐ Basement w/plumbing	☐ Basement w/o plumbing	


Comments / Conditions:

Installed Quick 4, essentially as Drawn (ST moved due to waterline)

INITIAL SITE SKETCH

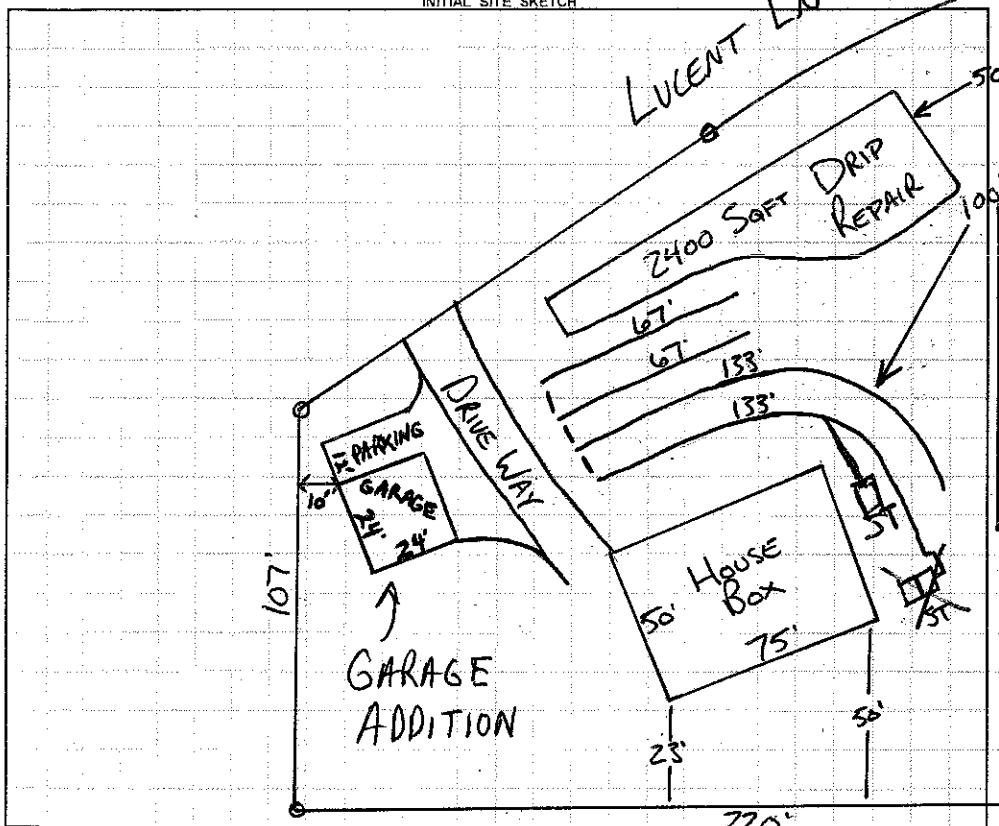

AS BUILT SKETCH

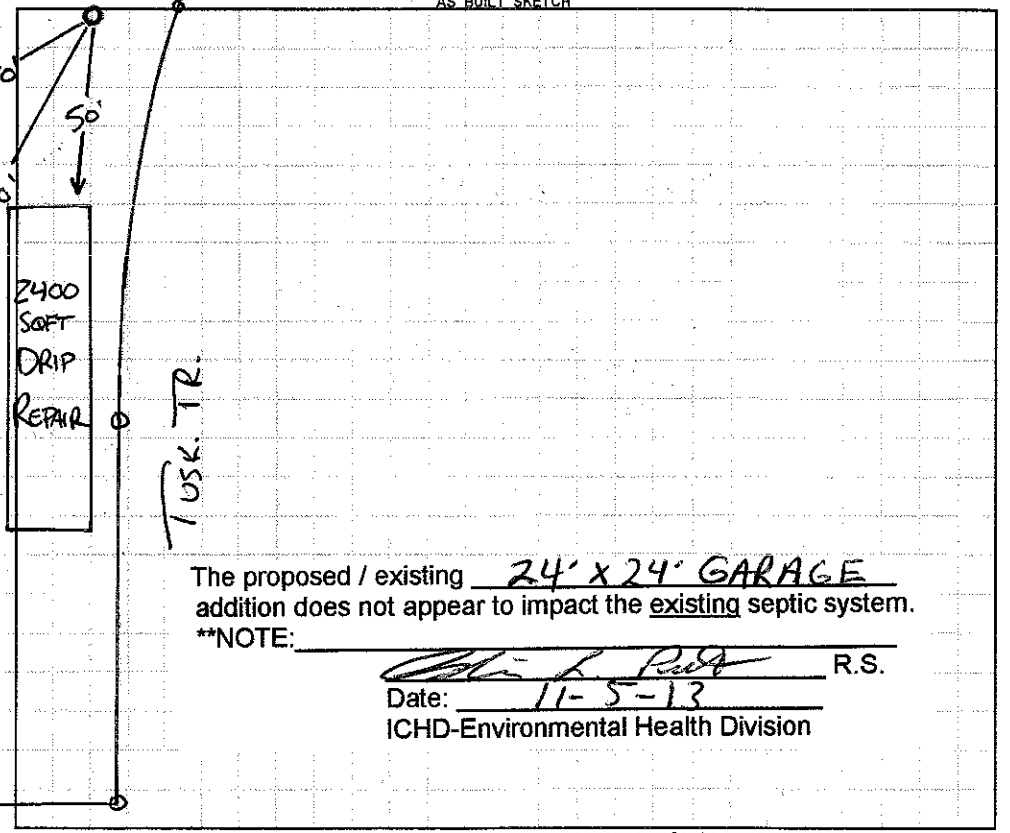

The proposed / existing 24' x 24' GARAGE addition does not appear to impact the existing septic system.

**NOTE:

R.S.

Date: 11-5-13

ICHD-Environmental Health Division

Permit can be suspended or revoked if any false information is supplied toward securing the permit / any unauthorized changes are made to the site / any unauthorized changes are made in the installation of the system. **CONTACT A LOCATOR SERVICE PRIOR TO ANY EXCAVATION**

☐ **IMPROVEMENT PERMIT** *with plat valid without expiration.* ☒ **IMPROVEMENT PERMIT** *with site plan valid for 60 mos.* ☒ **AUTHORIZATION TO CONSTRUCT** *valid for period equal to IMPROVEMENT PERMIT--not to exceed 60 mo.*

Owner / Applicant Signature: Kenneth Bealer Date: 11/18/13 Installed by: Steve Gordon RS

IMPROVEMENT PERMIT by: Date: 1-11-13 OPERATION PERMIT by: Maria H. Dotson RS Date: 6/20/13

AUTHORIZATION TO CONSTRUCT by: Date: 1-18-13 Existing System Inspected by: Date:

Health Dept. Copy - WHITE Applicant (Final Approval) - YELLOW Applicant (Conditional Approval) - PINK