
Date Issued MARCH 2ND 1984 Serial No. 6992 ICAR (S) Permit No. 15672

T. C. No. 001-382-61

Map Date

MECKLENBURG COUNTY
DEPARTMENT OF ENVIRONMENTAL HEALTH
INSTALLATION, CONSTUCTION, ALTERATION, AND/OR REPAIR PERMIT
(Individual Septic Tank System with Subsurface, Soil Absorption, Effluent Discharge)

Permission is hereby given to X Install or Construct ___ Alter or Repair the individual septic tank wastewater treatment system with subsurface, soil absorption, effluent discharge as specified herein at the described location. This permit is granted based upon the information supplied in application 15672, dated 2-7-84, and this permit shall be void and of no effect if the information provided in the application is not true or is erroneous. All work shall be completed on or before APRIL 1ST 1984, after which date this permit shall be null and void

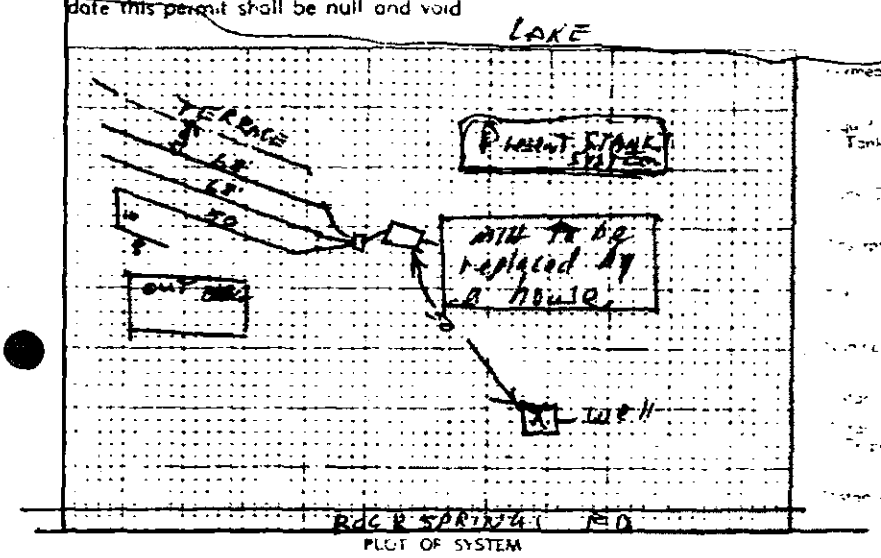

PLOT OF SYSTEM

Permeability Rate PS IIA

Liquid Capacity of Tank 1500 gal

Type of Construction Precast Concrete

Type of Material and Installation Line

Total Length 200 LIN FT

Number of Lines Three

Width of Trench 5 FT

Distance from Property Line 10 FT

Distance from Well 50 FT

NAME OF OWNER WALLACE, JACK

LOCATION OF PROPERTY 16424 ROCK SPRINGS ROAD

The system shall meet all of the construction requirements as set forth in the Regulations of the Mecklenburg County Health Commission which are in effect on the date of the granting of this permit. A certificate of approval must be issued by the Environmental Health Director before any system can be covered up or otherwise rendered uninspectable or can be used. The issuance of this permit does not in any way guarantee that the system anticipated to be constructed will operate properly, or relieve any person now or hereafter owning, controlling or using such system from any liability resulting from the failure of the system to operate properly.

Comments: Three trenches to be 68 FT X 3 FT X 12 inches stone - hay or straw cover - grade bldg - plumb w/in line with DUT Box -

W. B. Kinney
Division or Section Head

Ralph Hille
Environmentalist

* If this permit is for the installation or construction of a new system, it must be signed by the division or a section head of the Department of Environmental Health in order to be valid. Only the signature of the Environmentalist is required where an existing system is being altered or repaired.

EHD-5-76

ENVIRONMENTAL HEALTH DEPARTMENT'S COPY


Date Issued 6-6-79 **Serial No. 2831** ICAR(S) Permit No. 15672

T C No. 001-382-61

Map Date ____

MECKLENBURG COUNTY
DEPARTMENT OF ENVIRONMENTAL HEALTH
INSTALLATION, CONSTUCTION, ALTERATION, AND/OR REPAIR PERMIT
(Individual Septic Tank System with Subsurface, Soil Absorption, Effluent Discharge)

Permission is hereby given to ___ Install or Construct, ✓ Alter or Repair the individual septic tank wastewater treatment system with subsurface, soil absorption, effluent discharge as specified herein at the described location. This permit is granted based upon the information supplied in application 15672, dated 6-1-79 and this permit shall be void and of no effect if the information provided in the application is not true or is erroneous. All work shall be completed on or before 6-16-79, after which date this permit shall be null and void.

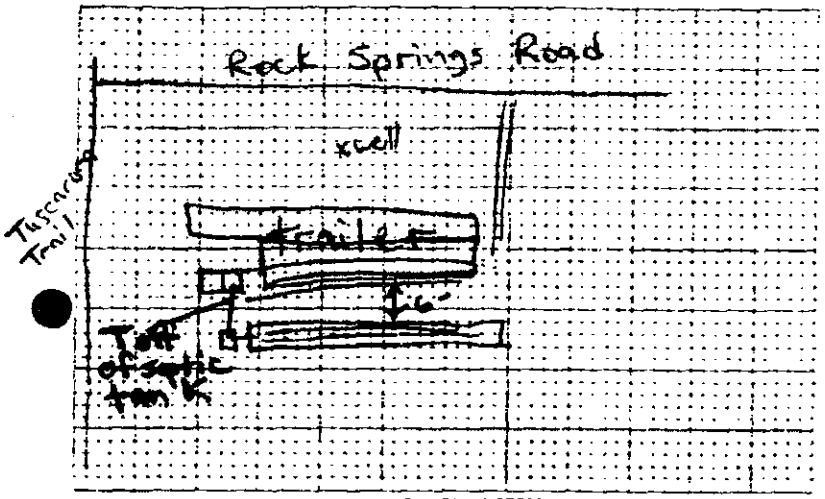

PLOT OF SYSTEM

Permeability Rate ____

Liquid Capacity of Tank ____

Tank Construction ____

Absorption and or Nitrification Lines

Total Line Length 150'

Number of Lines 2

Distance from House >5'

Distance from Property Line 10'

Distance from Well >50'

NAME OF OWNER Wallace & Jack Hurdle

LOCATION OF PROPERTY Rock Springs Road

The system shall meet all of the construction requirements as set forth in the Regulations of the Mecklenburg County Health Commission which are in effect on the date of the granting of this permit. A certificate of approval must be issued by the Environmental Health Director before any system can be covered up or otherwise rendered uninspectable or can be used.

THE ISSUANCE OF THIS PERMIT DOES NOT IN ANY WAY GUARANTEE THAT THE SYSTEM AS INSTALLED OR CONSTRUCTED WILL OPERATE PROPERLY OR RELIEVE ANY PERSON, FIRM OR CORPORATION CONTROLLING OR OWNING SUCH SYSTEM FROM ANY LIABILITY RESULTING FROM THE FAILURE OF THE SYSTEM TO OPERATE PROPERLY.

Comments

6' x 38' x 34" of stone

Division or Section Head ____

Environmentalist Michael A. Sexton

* If this permit is for the installation or construction of a new system, it must be signed by the division or a section head of the Department of Environmental Health in order to be valid. Only the signature of the Environmentalist is required where an existing system is being altered or repaired.

EHD-5-76

Environmental Health Department's Copy

Date Received 6/1/79

RECEIVED
JUN 1 1979
ENVIRONMENTAL HEALTH

CAR (S) Application No 15672

T C. No. 001-522-61


Map Date 5/23/78

MECKLENBURG COUNTY
DEPARTMENT OF ENVIRONMENTAL HEALTH

Application for an
Installation, Construction, Alteration, and/or Repair Permit
(Individual Septic Tank System with Subsurface, Soil Absorption, Effluent Discharge)

The owner of that property described hereinafter hereby applies to the Mecklenburg County Department of Environmental Health for a permit to:

1) ___ Install or Construct 2) X Alter or Repair an individual septic tank wastewater treatment system with a subsurface, soil absorption, effluent discharge.

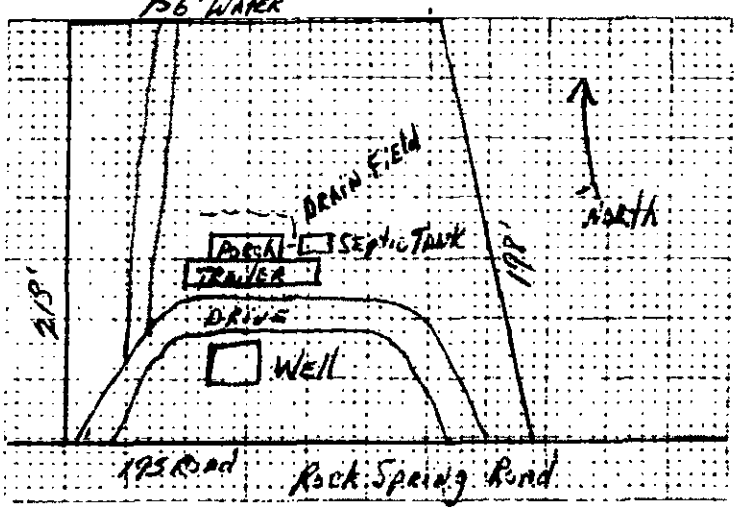

3) PLOT PLAN (ACCURATELY DIMENSIONED)

4) Mobile Home X Yes ___ No
Residence X Yes ___ No
4 No of Bedrooms 2
5 Business Use — Max No Employees ___
6 Washing Machine X Yes ___ No
7 Garbage Disposal ___ Yes X No
8 Dishwasher ___ Yes X No
9 Water Supply
A Individual Well X
B Governmental System ___
C Community System
1 Well Source ___
2 Governmental source ___
10 Sewage System
House located within 200 feet of public sewer ___ Yes X No
House located within 200 feet of community sewer ___ Yes X No
11 FmA Case No ___
12 VA Case No ___

13) NAME OF OWNER Wallace (LAST) Jack (FIRST) Huddle (MIDDLE)

14) ADDRESS OF OWNER Rt 6 Box 469 Mooresville, N.C. 28115

15) PHONE NO Home 663-5967 Office 375-4249

16) LOCATION OF SYSTEM Rock Springs Rd (STREET OR COUNTY ROAD)

17) SUBDIVISION Sec 4 & 6 Lakeshore Lot No 247 Block No. ___

Map Book No M-17 Page No. 622

18) DEED REFERENCE — DEED BOOK 3954 AT PAGE 119

19) HAS A SOIL INVESTIGATION BEEN RUN? YES NO DATE RUN ___

20) PTR NUMBER (See Instructions) ___

The undersigned person hereby agrees that he has read the foregoing application and that the contents of same are true. It is understood that any permit applied for herein shall be void and of no effect if any of the above facts are not true.

DATE OF APPLICATION ___

OWNER Jack Huddle Wallace

EHD-5-76

ENVIRONMENTAL HEALTH DEPARTMENT'S COPY