IREDELL COUNTY HEALTH DEPARTMENT

Statesville Office (704) 878-5305 Mooresville Office (704) 660-3625 PERMIT # 214147

IMPROVEMENT PERMIT / AUTHORIZATION TO CONSTRUCT / OPERATION PERMIT / EXISTING SYSTEM

PIN # 4614959358

APPLICANT: Beth Yarbrough / Kemp Const. APPLICANT ADDRESS: 291 Tuskarora Trail Mooresville, NC 28117

SITE ADDRESS: 291 Tuskarora Trail Mooresville, NC 28117 PHONE: ALT. PHONE: 704 883-4485

SITE DIRECTIONS: Brawley School Rd TR Tuskarora trail ~ 1 mile on left just past Bear Creek

SUBDIVISION: C & T SECTION: 6 LOT # 1726 LOT AREA: .698 Acre DESIGN FLOW: 360 gpd L.T.A.R.:

Exist

Septic Tank 1000 (gal) STB Date
Pump Tank (gal) PT Date
Pump Make Model Serial #
Nitrification Fields 1 # Lines 4 Linear Ft: 400+
Trench Width 36" Max. Trench Bottom Depth Gravel Depth 12"

☐ New System ☐ Repair ☐ Expansion System Type: I (II) III IV V VI
System Description: Exist. Gravity - Conventional
Repair System Description: Modified Conventional
Maintenance Agreement Required: ☐ YES ☒ NO
☒ GRAVITY ☐ PRESSURE


☒ Residence No. Bedrooms 3
☐ Business No. Persons 6
☐ Other No. Employees
☐ Slab ☒ Crawl Space
☐ Basement w/plumbing ☐ Basement w/o plumbing

Water Supply: ☐ Private ☐ Public ☐ Community

Comments / Conditions: ~~A~~ Must keep ~~last~~ Garage Addition at least 5ft from Septic & 25ft from well.

The proposed Garage addition does not appear to impact the existing Septic System

INITIAL SITE SKETCH

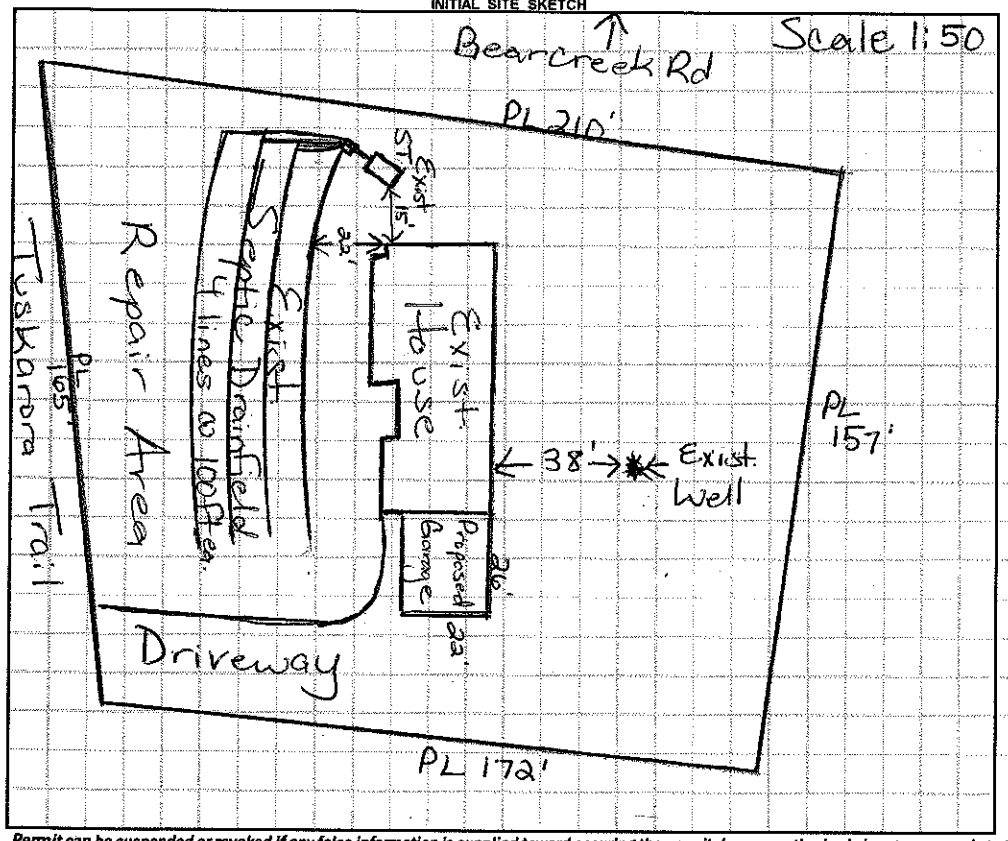

AS BUILT SKETCH

Permit can be suspended or revoked if any false information is supplied toward securing the permit / any unauthorized changes are made to the site / any unauthorized changes are made in the installation of the system. **CONTACT A LOCATOR SERVICE PRIOR TO ANY EXCAVATION**

☐ **IMPROVEMENT PERMIT** *with plat valid without expiration.* ☐ **IMPROVEMENT PERMIT** *with site plan valid for 60 mos.* ☐ **AUTHORIZATION TO CONSTRUCT** *valid for period equal to IMPROVEMENT PERMIT--not to exceed 60 mo.*

Owner / Applicant Signature: Date: 12/1/15 Installed by:

IMPROVEMENT PERMIT by: Date: OPERATION PERMIT by: Date:

AUTHORIZATION TO CONSTRUCT by: Date: Existing System Inspected by: Marie Dotson R.S. Date: 11/9/15

Health Dept. Copy - WHITE Applicant (Final Approval) - YELLOW Applicant (Conditional Approval) - PINK