IREDELL COUNTY HEALTH DEPARTMENT

STATESVILLE 704-878-5305 MOORESVILLE 704-664-5281

IMPROVEMENT PERMIT / AUTHORIZATION TO CONSTRUCT / OPERATION PERMIT / EXISTING SYSTEM INSPECTION

PERMIT # _____ PIN # 4614 97 4775 DATE 8/31/09

OWNER or APPLICANT FRED VERMEULEN PHONE: Business 704-533-0465 Home: _____

OWNER or APPLICANT ADDRESS 203 BALMORAL DR. MOORESVILLE, NC 28117

LOCATION / DIRECTIONS 1100, TR TUSCARORA TR BALMORAL TO END, 203 ON L

SUBDIVISION MECKLENBURG CLT BLOCK / SECTION 6 LOT # 229 LOT AREA _____ DESIGN FLOW _____ L.T.A.R. _____

Septic Tank EXISTING Gallons: STB _____ Date _____

Pump Tank EXISTING Gallons: P T _____ Date _____

Pump Make _____ Model _____ Serial # _____

Nitrification Field No Fields 1 No Lines 5 Linear Feet 350

Trench Width 1.5' Max. Trench Bottom Depth 3' Gravel Depth 17"

☐ New System ☐ Repair ☐ Expansion System Type I II (III) IV V VI

System Description: _____

Repair System Description: EXISTING SYSTEM

Maintenance Agreement Required ☐ YES ☐ NO

☐ GRAVITY ☐ PRESSURE

☒ Residence No. Bedrooms 3

☐ Business No. Persons _____

☐ Other No. Employees _____

☐ Slab ☒ Crawl Space

☐ Basement w/plumbing ☐ Basement w/o plumbing


Water Supply: ☒ Private ☐ Public ☐ Community

Comments / Conditions

INITIAL SITE SKETCH

Comments / Conditions

AS BUILT SKETCH

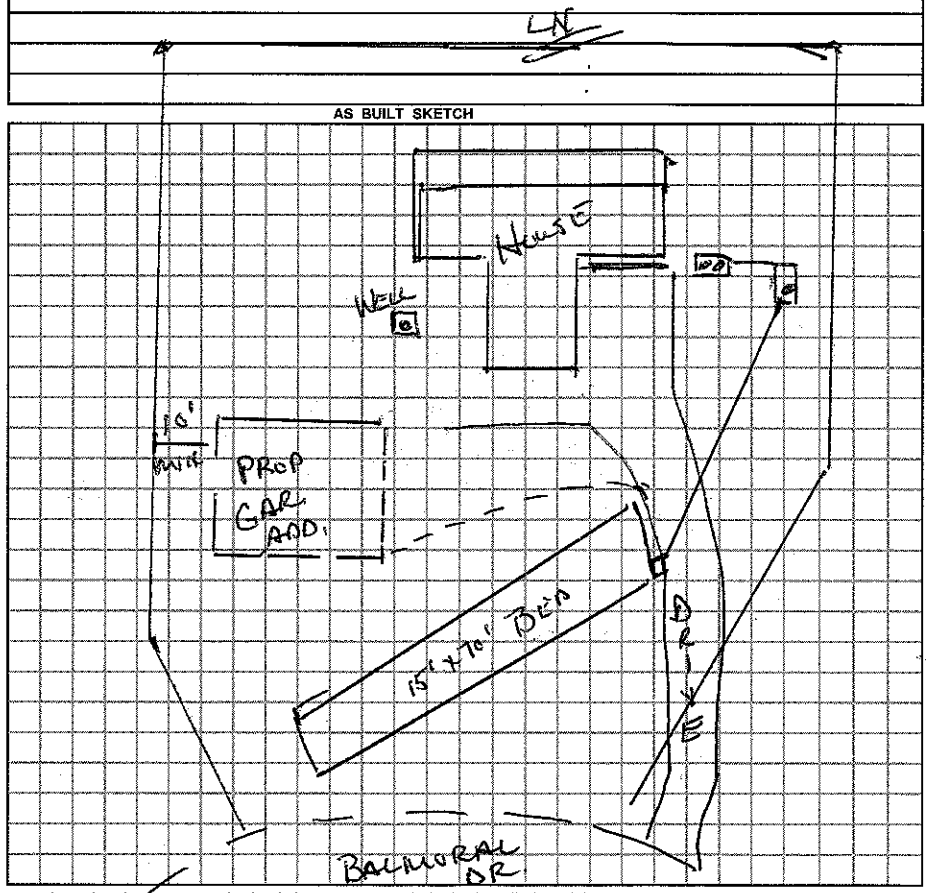

Permit can be suspended or revoked if any false information is supplied toward securing the permit / any unauthorized changes are made to the site / any unauthorized changes are made in the installation of the system.

☐ *IMPROVEMENT PERMIT w / plat valid without expiration.* ☐ *IMPROVEMENT PERMIT w / site plan valid for 60 mos.* ☐ *AUTHORIZATION TO CONSTRUCT valid for period equal to IMPROVEMENT PERMIT-not to exceed 60 mo.*

Owner / Applicant Signature: _____ Date _____

Improvement Permit by: _____ Date _____

Authorization to Construct by: _____ Date _____

YOU SHOULD CONTACT A LOCATOR SERVICE PRIOR TO ANY EXCAVATION.

Installed by: _____

Operation Permit by: _____ Date: _____

Existing System Inspected by: Wesley Sparks R.S. Date: 8/31/09

WHITE COPY Environmental Health YELLOW COPY (Final) Owner / Applicant PINK COPY (Initial) Owner / Applicant