$550 Meck Neck

IREDELL COUNTY HEALTH DEPARTMENT

STATESVILLE 704-878-5305 MOORESVILLE 704-664-5281

IMPROVEMENT PERMIT / AUTHORIZATION TO CONSTRUCT / OPERATION PERMIT / EXISTING SYSTEM INSPECTION

PERMIT# 41379 PIN# 4614975073 DATE 3/29/07

OWNER OR APPLICANT ABJ Constr. Inc PHONE: Business Home

ADDRESS 134 Brawley Sch. Rd Mooresville, 28115

LOCATION B.S.R. RT on Tuskaroora Trail, RT on Belmoral, LT Claiborne, Property on Right

SUBDIVISION ~~CLP~~ MECK NECK BLOCK / SECTION 6 LOT 234 LOT AREA .69 Ac. SITE CLASS. PS: DESIGN FLOW 480 L.T.A.R. .30

Existing 3 BR System

Septic Tank: 1000 Gallons; STB 794 Date 3/8/07
Pump Tank: 1000 Gallons; PT 283 Date 3/22/07
Pump Make: Goulds Model USED-511 HT Serial No.
Nitrification Field: No Fields 1 Square Feet 300ft² Linear Feet +100'
No Lines +1@100' Trench Width 36" Max Trench Bottom Depth 36" Gravel Depth — ☐ Gravity ☒ Pressure

☐ New System ☐ Repair ☒ Expansion System Type: I II III IV V VI
System Description: Pressure → 25% Reduction
Repair System Description: Low Pressure Panel
Maintenance Agreement Required: ☐ Yes ☒ No

☒ House/Mod. Home ☐ Mobile Home ☐ Business ☐ Other
No. Bedrooms 4 No. Persons No. Employees


Water Supply: ☒ Individual ☐ Public ☐ Community

☐ Slab ☒ Crawl Space ☐ Basement w/plumbing ☐ Basement wo/plumbing

Comments:/Conditions: 3 Bedroom, Type III B (pressure monitored to 25% Reduction) system already existing. Setting New Septic & pump tanks, and a new manifold with 4 hole distribution & 3' lines @ 100' each in ground - adding one more @ 100' - 9' on center

Comments:/Conditions: Supply line from P.T. to P.M. must be sleeved in ductile iron, OR, burried minimum of 30 inches under driveway plus 5ft on each side

INITIAL SITE SKETCH (1" = 50')

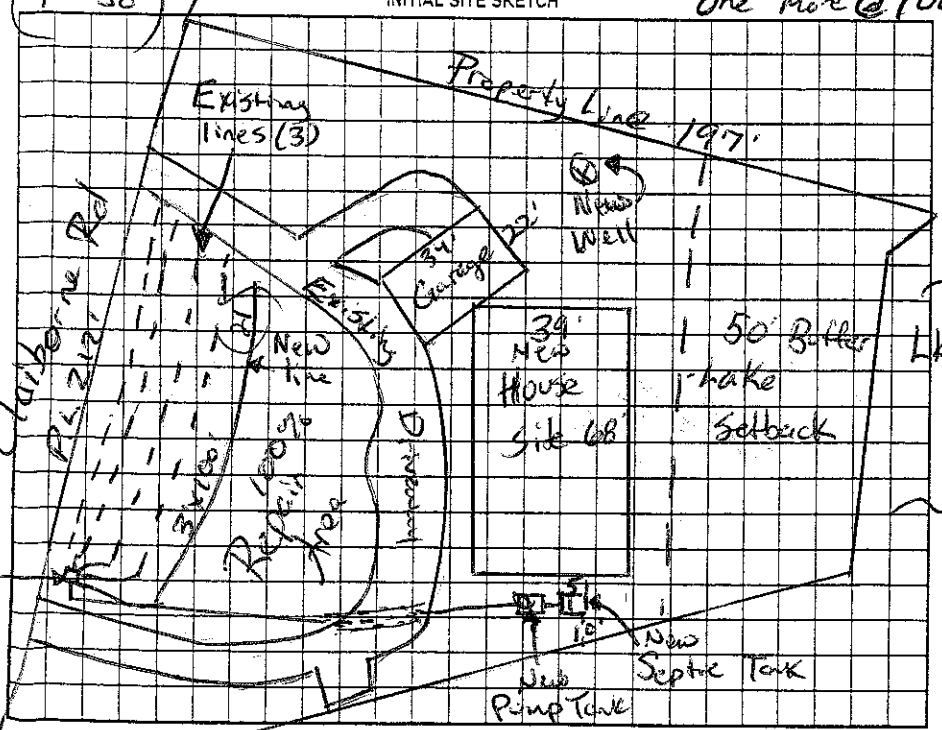

AS BUILT SKETCH

Permit can be suspended or revoked if any false information is supplied toward securing the permit/any unauthorized changes are made to the site/any unauthorized changes are made in the installation of the system. Improvement Permit with plat valid without expiration ☐ Improvement Permit with site plan valid for sixty months ☒ Authorization to Construct is valid for a period equal to that of Improvement Permit – not to exceed sixty months.

Signed: ABJ By [signature] date

Improvement Permit by: [signature] date 3/29/07

Authorization to Construct by: Wesley Sparks R.S. date 8/22/07

Installed by: FJ Equipment

Operation Permit by: [signature] date 7-9-08

Existing System Inspection by: date

HEALTH DEPT. COPY: WHITE OWNER COPY (FINAL): YELLOW OWNER COPY (INITIAL): PINK