# ...NTY HEALTH DEPARTMENT Authorization to Construct (3:30)

STATESVILLE 704-878-5305 MOORESVILLE 704-664-528

## ...NT PERMIT / ~~CERTIFICATE OF COMPLETION~~ / OPERATION PERMIT / EXISTING SYSTEM INSPEC...

PROPERTY DESCRIPTION NO. 066002 DATE 12/1/97 TAX MAP NO. 4614991923 Watershed: X Yes No

OWNER OR CONTRACTOR Herbert Speugh Jr. PHONE: Business Home 391-8619

ADDRESS 2308 Tryon St. # 1400 Charlotte, NC. 28203-215

LOCATION Stonemarker Rd. West; Stonemarker Tr Blenney TR Stonemarker ~ 1 mile on (L) 554 Stonemarker Rd

SUBDIVISION CL+T BLOCK / SECTION 6 LOT 153 LOT AREA ~1.12Ac SITE CLASS. P DESIGN FLOW 360 L.T.A.R. .3

Septic Tank: 1000 Gallons; STB 821 Date 8/7/98

Pump Tank: 1000 Gallons; PT 40 Date 3/30/98

Pump Make: _____ Model _____ Serial No. _____

Nitrification Field: No Fields 1 Square Feet 600* Linear Feet 200*

No Lines 4 Trench Width 36" Max Trench Bottom Depth 36" Gravel Depth SAND

X New System ☐ Repair System Type: I, II, (III) IV, V, VI

System Description: Presbleu - 16"PPBS

Repair System Description: SAME

Maintenance Agreement Required: ☐ Yes X No

X House/Mod. Home No. Bedrooms 3

☐ Mobile Home No. Bathrooms 4.5

☐ Business No. Employees ____

☐ Other _____


☐ Slab X Crawl Space ☐ Basement w/plumbing ☐ Basement wo/plumbing

Water Supply: X Individual ☐ Community ☐ Public


Comments:

Comments:

### INITIAL SITE SKETCH

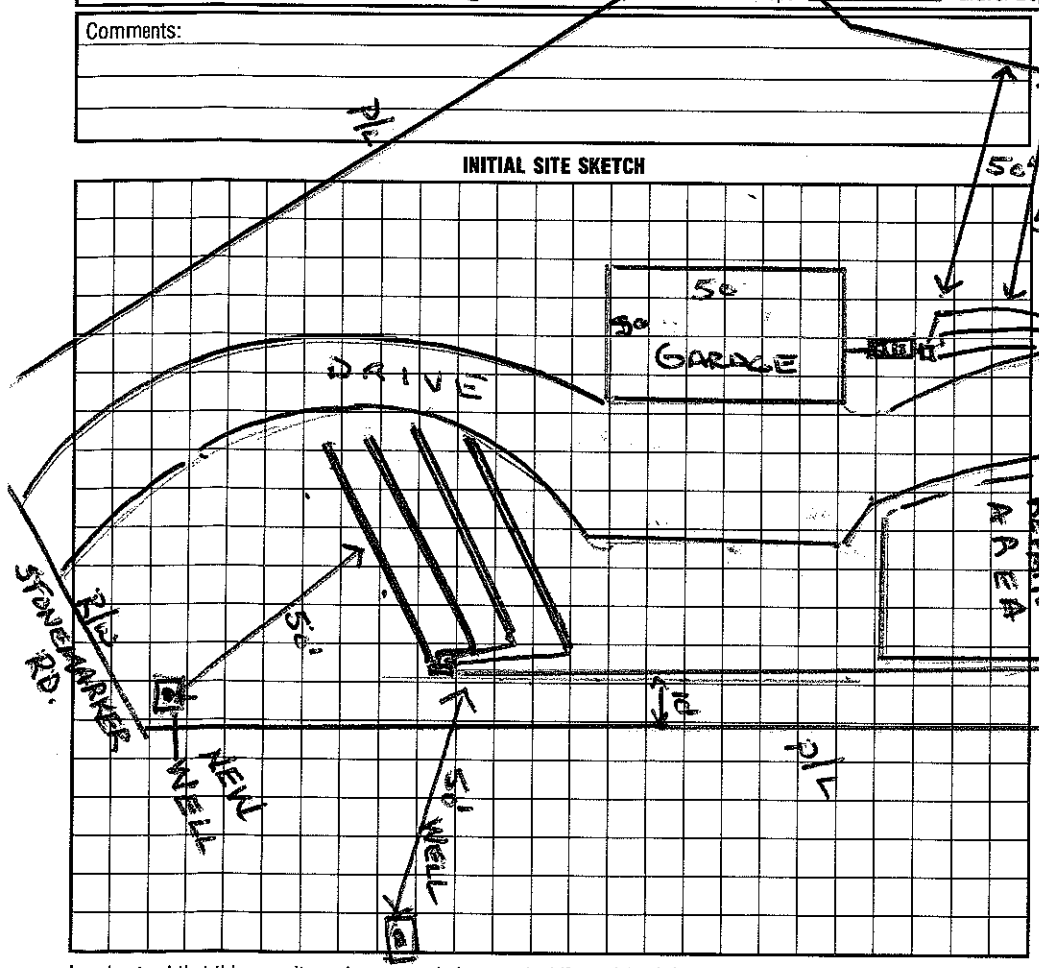


### AS BUILT SKETCH

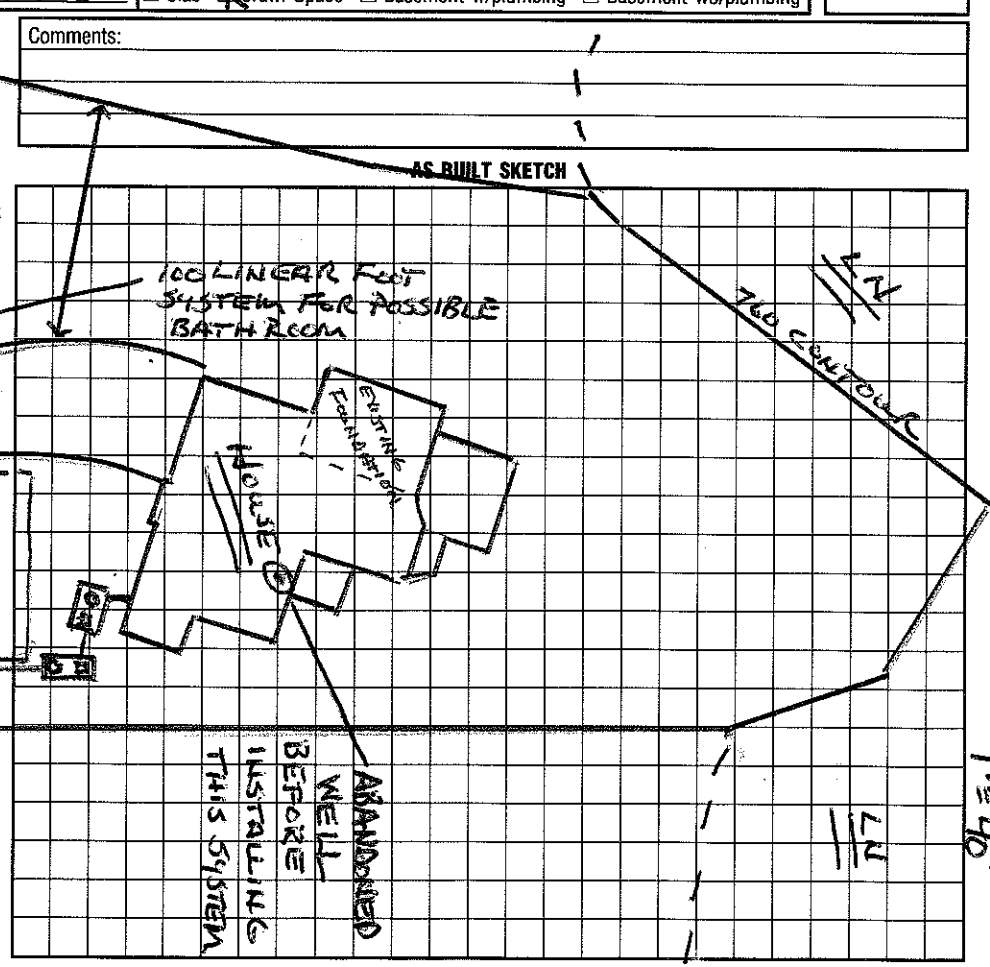


I understand that this permit can be suspended or revoked if any false information is supplied toward securing the permit/any unauthorized changes are made to the site/any unauthorized changes are made in the installation of the system. Improvement Permit is valid for 60 months from date of issuance.

Signed: X Joyce Elkins

Improvement Permit by: Wesley Sparks RS. date 12/1/97

Existing System Inspection by: Wesley Sparks RS. date 12/1/97

Installed by: G & M Enterprises

Certificate of Completion by: Wesley Sparks RS. date 4/15/99

Operation Permit by: Wesley Sparks RS date 4/15/99

HEALTH DEPT. COPY: WHITE INSPECTION COPY (FINAL): GREEN OWNER COPY (FINAL): YELLOW INSPECTION COPY (INITIAL): PINK OWNER COPY (INITIAL): GOLD