CRESCENT LAND & TIMBER

IREDELL COUNTY HEALTH DEPARTMENT

STATESVILLE 704-878-5305 MOORESVILLE 704-664-5281

IMPROVEMENT PERMIT / AUTHORIZATION TO CONSTRUCT / OPERATION PERMIT / EXISTING SYSTEM INSPECTION

PERMIT# 25282 PIN# 20-1-A-156 4614 99 4961 DATE 4/26/99

OWNER OR CONTRACTOR ART BECKER PHONE: Business _____ Home _____

ADDRESS 250 S HOUSTON BRANCH RD - CHARLOTTE NC 28270

LOCATION BRAWLEY SCHOOL - TR STONEMARKER - TL BLAKNEY - TR STONEMARKER - ON LT

SUBDIVISION STONEMARKER BLOCK / SECTION 6 LOT 156 LOT AREA _____ SITE CLASS. PS DESIGN FLOW 480 L.T.A.R. .3 gpd/ft2

LT

Septic Tank: 1000 Gallons; STB 794 Date 4/2/00
Pump Tank: 1000 Gallons; PT 27 Date 3/20/00
Pump Make: _____ Model _____ Serial No. _____
Nitrification Field: No Fields 1 Square Feet 540 Linear Feet 270
No Lines 3 Trench Width 36" Max Trench Bottom Depth 36" Gravel Depth N/A

☒ New System ☐ Repair System Type: I, II, III, IV, V, VI
System Description: PUMP PANEL
Repair System Description: SAME
Maintenance Agreement Required: ☒ Yes ☐ No


☒ House/Mod. Home No. Bedrooms 4
☐ Mobile Home No. Bathrooms 4
☐ Business No. Employees _____
☐ Other _____
☐ Slab ☐ Crawl Space ☒ Basement w/plumbing ☐ Basement wo/plumbing

Water Supply: ☒ Individual ☐ Public ☐ Community


Comments/Conditions: 6

Comments/Conditions:

INITIAL SITE SKETCH 1"=60'

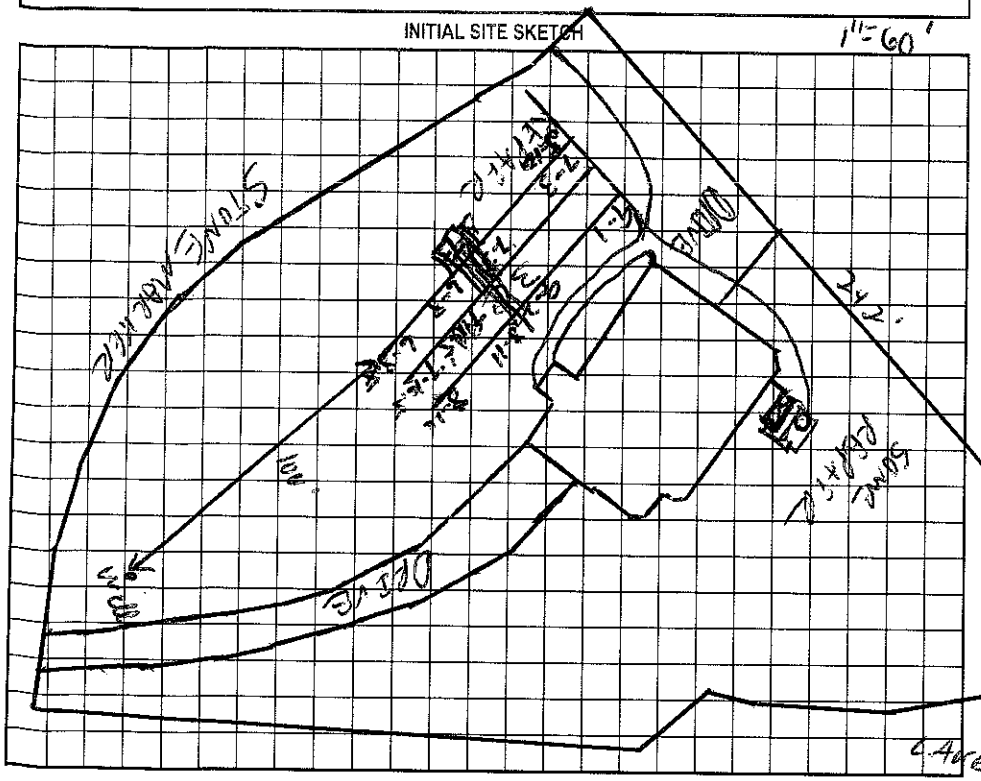

AS BUILT SKETCH

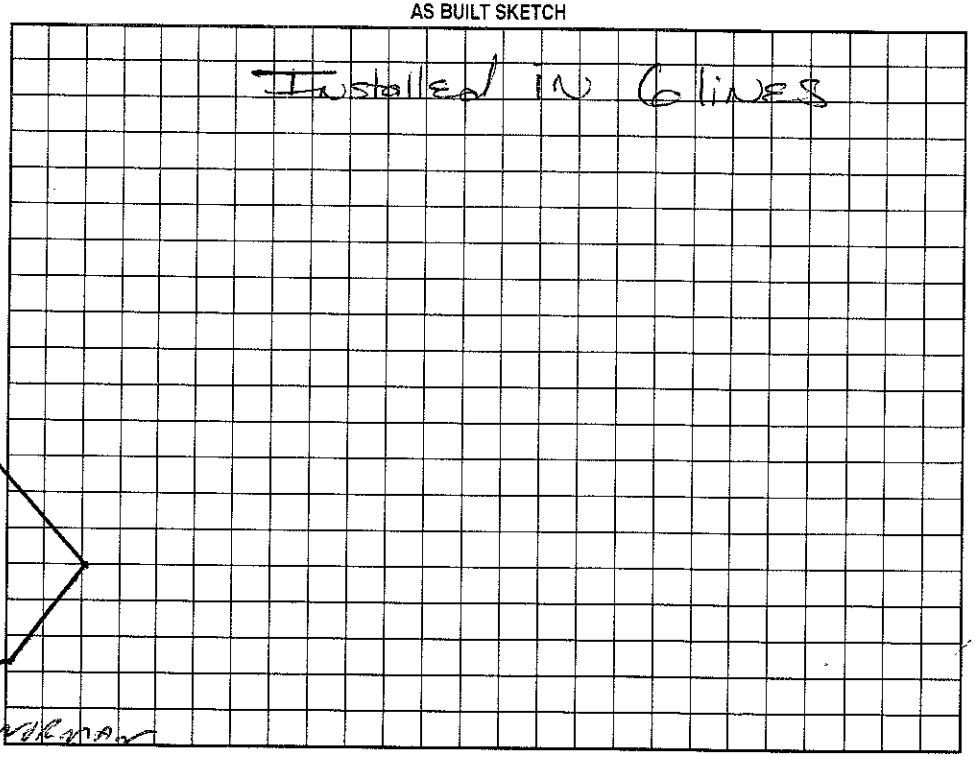

Permit can be suspended or revoked if any false information is supplied toward securing the permit/any unauthorized changes are made to the site/any unauthorized changes are made in the installation of the system. Improvement Permit with plat valid without expiration. Improvement Permit with site plan valid for sixty months. Authorization to Construct is valid for a period equal to that of Improvement Permit – not to exceed sixty months.

Signed: _____ date 5/3/99 Installed by: R+H Inc.

Improvement Permit by: _____ RS date 4/26/99 Operation Permit by: _____ RS date 11/8/2000

Authorization to Construct by: _____ RS date 4/26/99 Existing System Inspection by: _____ date _____

HEALTH DEPT. COPY: WHITE OWNER COPY (FINAL): YELLOW OWNER COPY (INITIAL): PINK