IREDELL COUNTY HEALTH DEPARTMENT

Statesville Office (704) 878-5305 Mooresville Office (704) 660-3625 PERMIT # 209937

IMPROVEMENT PERMIT / AUTHORIZATION TO CONSTRUCT / OPERATION PERMIT / EXISTING SYSTEM

PIN # 4615805214

APPLICANT: Wendell Overby APPLICANT ADDRESS: P.O. Box 832 Mooresville NC 28115

SITE ADDRESS: 538 Stonemarker Rd Mooresville, NC PHONE (704) 239-2001 ALT. PHONE:

SITE DIRECTIONS: Brawley School Rd TR Stonemarker around point lot on right

SUBDIVISION: Cluff SECTION: 6 LOT # 149 LOT AREA: .66 Ac. DESIGN FLOW: 360gpd L.T.A.R.:

Septic Tank 1000 (gal) STB Date

Pump Tank (gal) PT Date

Pump Make Model Serial #

Nitrification Fields 1 # Lines Existing Linear Ft:

Trench Width Exist Max. Trench Bottom Depth Exist Gravel Depth

☐ New System ☒ Repair ☐ Expansion System Type: I (II) III IV V VI

System Description: ST Only

Repair System Description:

Maintenance Agreement Required: ☐ YES ☒ NO ☒ GRAVITY ☐ PRESSURE

☒ Residence No. Bedrooms

☐ Business No. Persons

☐ Other No. Employees

☒ Slab ☐ Crawl Space

☐ Basement w/plumbing ☐ Basement w/o plumbing

Water Supply

☒ Private

☐ Public

☐ Community

Comments / Conditions: ★ Existing Gravel/Cinder Bed Drainfield. ★ Replace ST only hook to existing Drainfield.

INITIAL SITE SKETCH

See attached/approved plan by Soil & Forestry Services of the Carolinas (dated 9-14-15)

AS BUILT SKETCH

Permit can be suspended or revoked if any false information is supplied toward securing the permit / any unauthorized changes are made to the site / any unauthorized changes are made in the installation of the system. **CONTACT A LOCATOR SERVICE PRIOR TO ANY EXCAVATION**


☐ **IMPROVEMENT PERMIT** *with plat valid without expiration.* ☐ **IMPROVEMENT PERMIT** *with site plan valid for 60 mos.* ☐ **AUTHORIZATION TO CONSTRUCT** *valid for period equal to IMPROVEMENT PERMIT--not to exceed 60 mo.*

Owner / Applicant Signature: Date: 10-7-15 Installed by: ENT

IMPROVEMENT PERMIT by: Marie Dotson RS Date: 9/25/15 OPERATION PERMIT by: Date: 10-22-15

AUTHORIZATION TO CONSTRUCT by: Marie Dotson RS Date: 9/25/15 Existing System Inspected by: Date:

Health Dept. Copy - WHITE Applicant (Final Approval) - YELLOW Applicant (Conditional Approval) - PINK

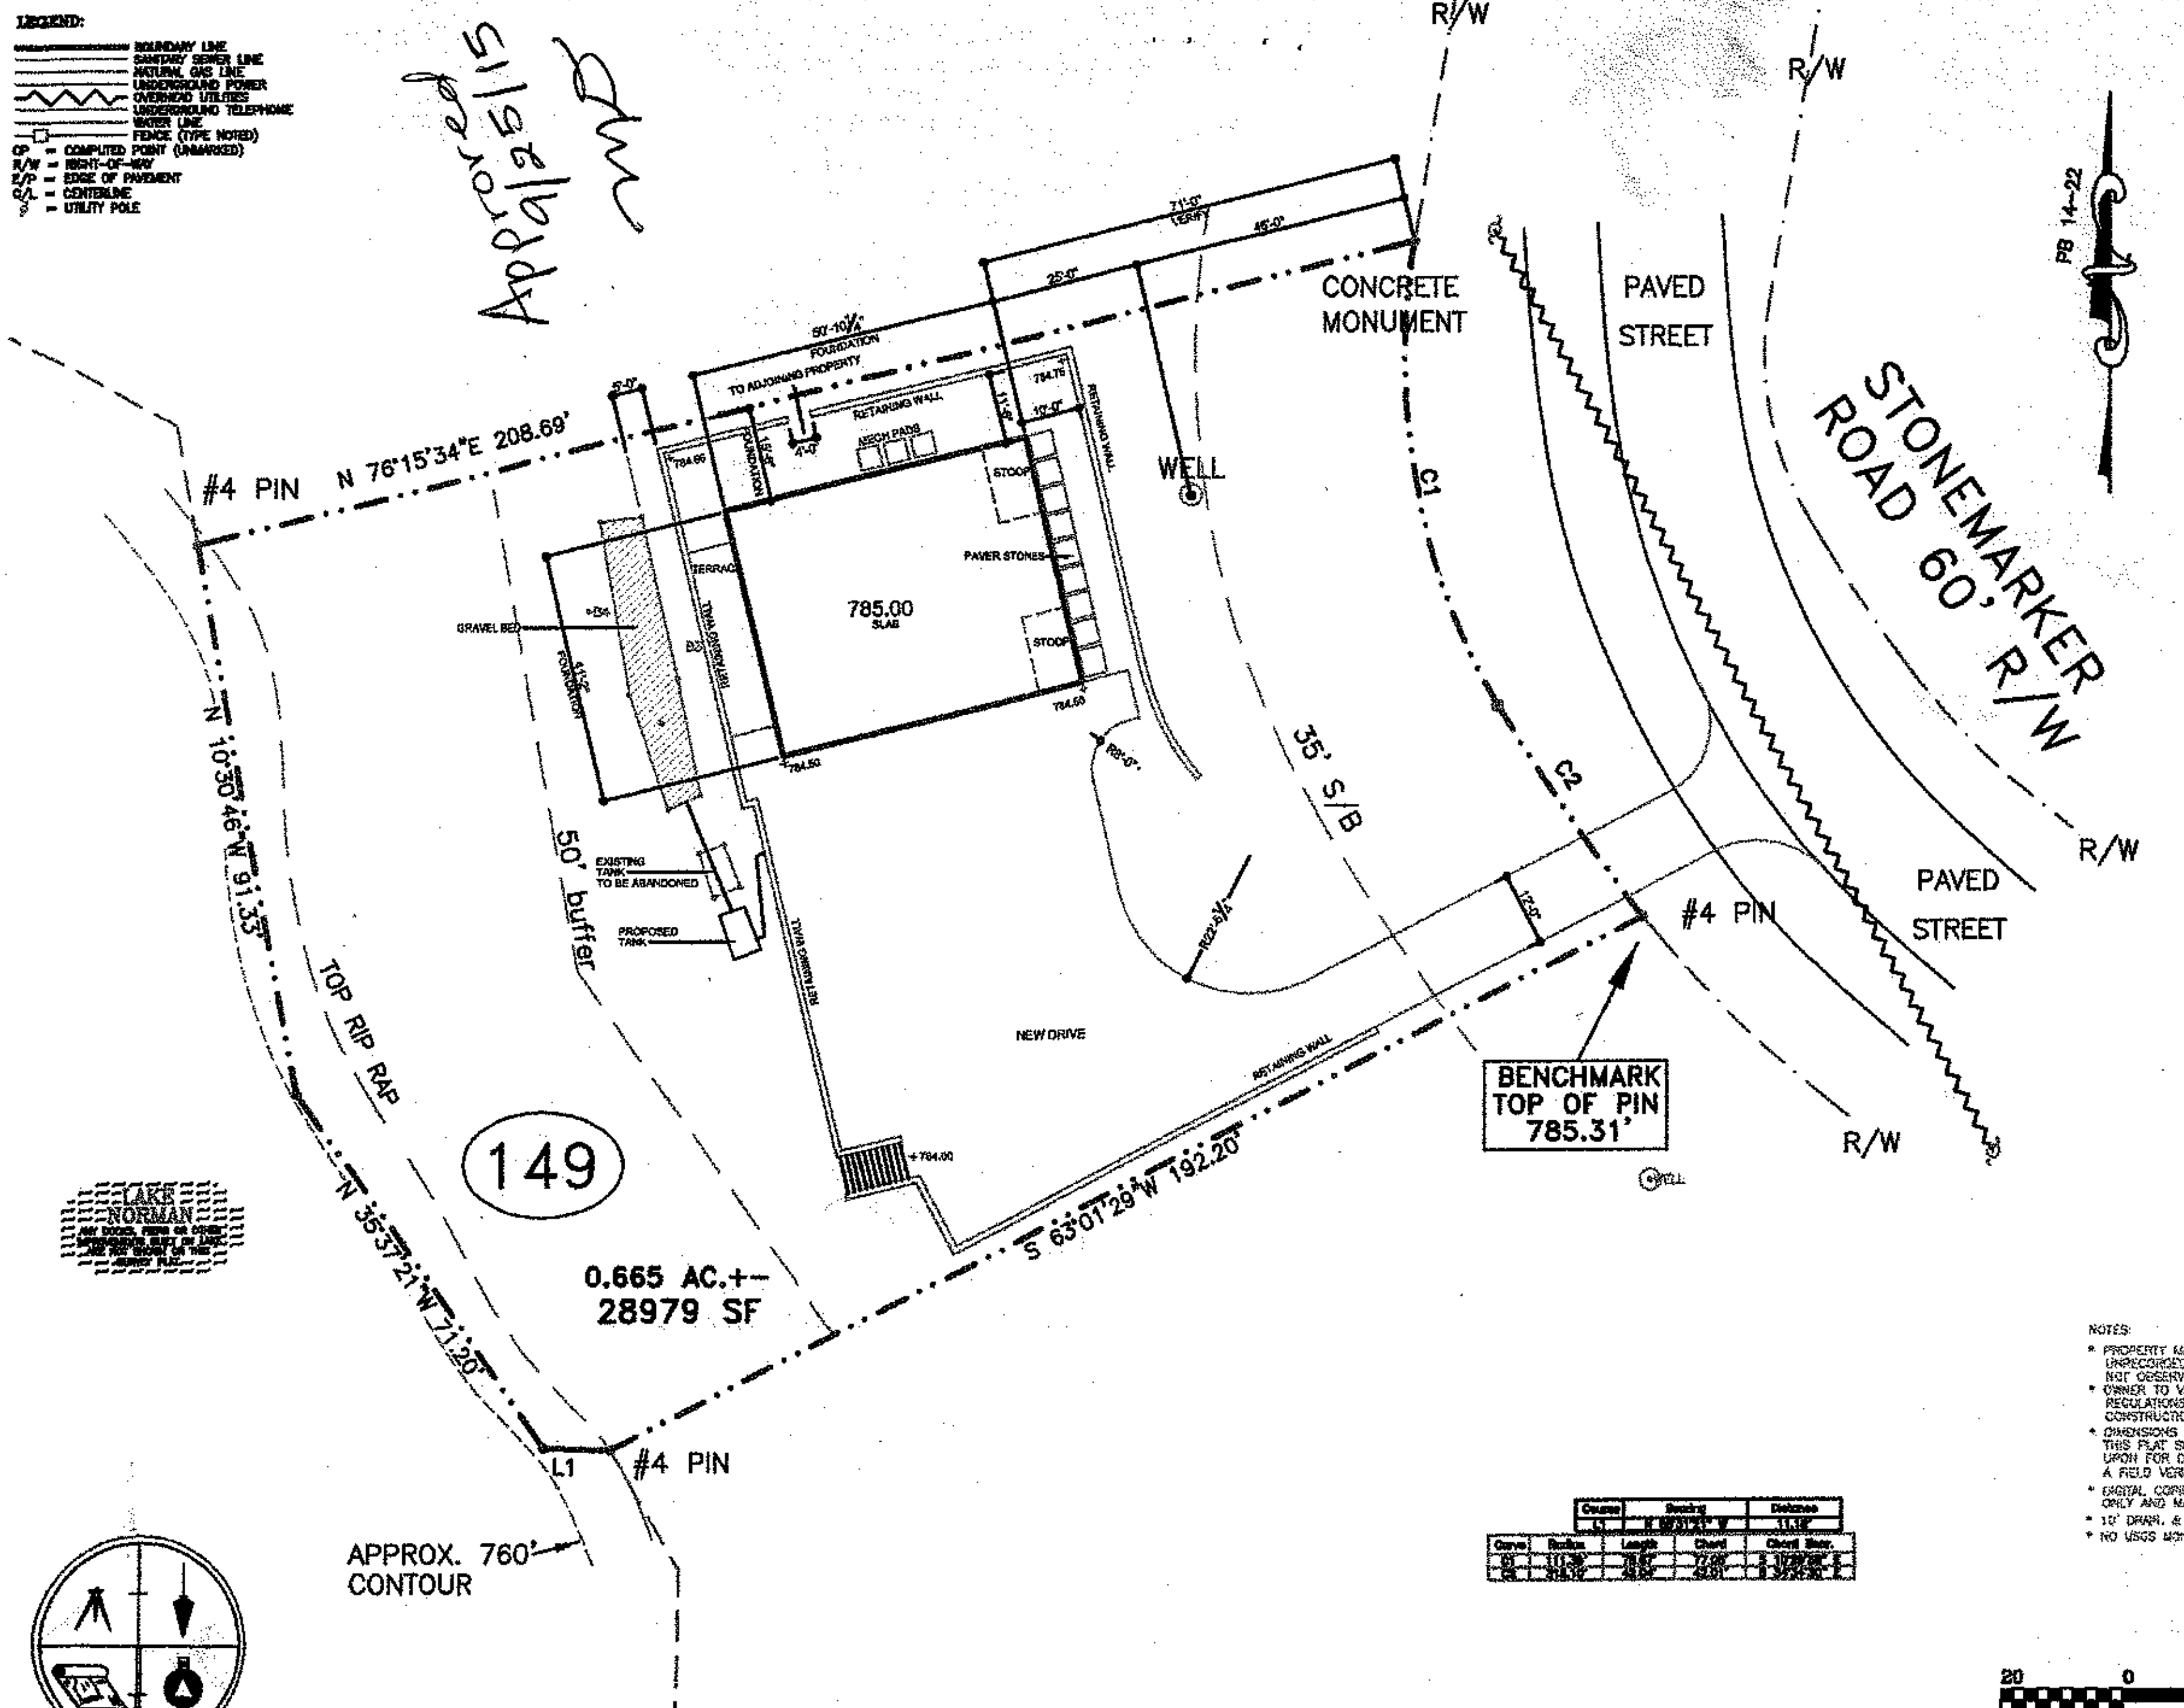

PHYSICAL SURVEY FOR

LOT #149

CRESCENT LAND & TI[...]

KLEIN TRUST PROPERTY

@ 538 STONEMARKER RD, MOORESV[...]

DATE: 1-14-15	DB: 1064 PG:
SCALE: 1" = 20'	DB: PG:
	PB: 14 PG:

DAVIDSON TOWNSHIP

IREDELL COUNTY, NC

DEDMON SURVEYS

CHUCK POOVEY, PLS #3762
ROBERT DEDMON, PLS #3699

3704 NC HIGHWAY #16 BUSINESS [...]
P.O. BOX 484 - DENVER, NC 2[...]
PHONE: 704/483/4608
FAX: 704/483/2170

SEAL L-3762

VICINITY MAP

Course	Bearing	Distance
L1	N 58°31'21" W	11.18'

Curve	Radius	Length	Chord	Chord Bear.
C1	111.38'	78.87'	77.05'	S 10°29'09" E
C2	214.10'	43.64'	43.61'	S 32°24'30" E

NOTES:

- PROPERTY MAY BE SUBJECT TO RECORDED OR UNRECORDED RIGHTS OF WAYS OR EASEMENTS NOT OBSERVED
- OWNER TO VERIFY ALL SETBACKS AND ZONING REGULATIONS PRIOR TO ANY PLANNING OR CONSTRUCTION.
- DIMENSIONS OF ALL IMPROVEMENTS SHOWN ON THIS PLAT SHOULD NOT BE SCALED OR RELIED UPON FOR DESIGN OR CONSTRUCTION WITHOUT A FIELD VERIFICATION OF ALL DIMENSIONS.
- DIGITAL COPIES OF THIS FILE ARE FOR REFERENCE ONLY AND MAY NOT BE USED FOR DESIGN WORK.
- 10' DRAIN. & UTILITY EASEMENT MAY EXIST ALONG EACH LOT LINE.
- NO USGS MONUMENT FOUND WITHIN 2000' OF SUBJECT PROPERTY.

20 0 20 40 60

GRAPHIC SCALE - FEET

- A PORTION OF THIS PROPERTY IS LOCATED IN A 100 YEAR FLOOD PLAIN AS DESIGNATED BY FIRM PANEL # 3710461600E EFFECTIVE DATE: 3-16-2008

NOTE: NOT ALL UTILITIES ARE IDENTIFIED ON THIS MAP! ONLY THOSE MARKED AT TIME OF FIELD SURVEY ARE NOTED. CONTRACTOR/ENGINEER/ESTIMATOR SHOULD VERIFY LOCATION, SIZE & TYPE BY A FIELD VISIT. CONTRACTOR MUST HAVE ALL UNDERGROUND UTILITIES MARKED PRIOR TO ANY CONSTRUCTION. SURVEYOR IS NOT RESPONSIBLE FOR UNDERGROUND UTILITIES NOT SHOWN ON SURVEY.