IREDELL COUNTY HEALTH DEPARTMENT

Statesville Office (704) 878-5305 Mooresville Office (704) 660-3625 PERMIT # 181473

IMPROVEMENT PERMIT / AUTHORIZATION TO CONSTRUCT / OPERATION PERMIT / EXISTING SYSTEM

PIN # 4615-80-5717

APPLICANT: Ron Dennis APPLICANT ADDRESS: 2408 Hartmill Ct. Charlotte 28226

SITE ADDRESS: 114 Catesby Ln. PHONE: 704-902-2057 ~~ALT. PHONE:~~ → Ronnie Broome

SITE DIRECTIONS: BSR, TR Stonemarker, TR Catesby


SUBDIVISION: CLET SECTION: 6 LOT # 145 LOT AREA: .683 AC DESIGN FLOW: 480 L.T.A.R.:

Septic Tank	Ex. 1500 (gal)	STB		Date		☐ New System	☐ Repair	☐ Expansion	System Type: I II (III) IV V VI	☒ Residence	No. Bedrooms 4
Pump Tank	(gal)	PT		Date		System Description:		Panel Block		☐ Business	No. Persons
Pump Make	Model			Serial #		Repair System Description:				☐ Other	No. Employees
# Nitrification Fields	1	# Lines	2@75'	Linear Ft:	150'	Maintenance Agreement Required:	☐ YES	☒ NO		☐ Slab	☐ Crawl Space
Trench Width		Max. Trench Bottom Depth		Gravel Depth			☒ GRAVITY	☐ PRESSURE		☒ Basement w/plumbing	☐ Basement w/o plumbing


Water Supply: ☒ Private ☐ Public ☐ Community

Comments / Conditions:

INITIAL SITE SKETCH

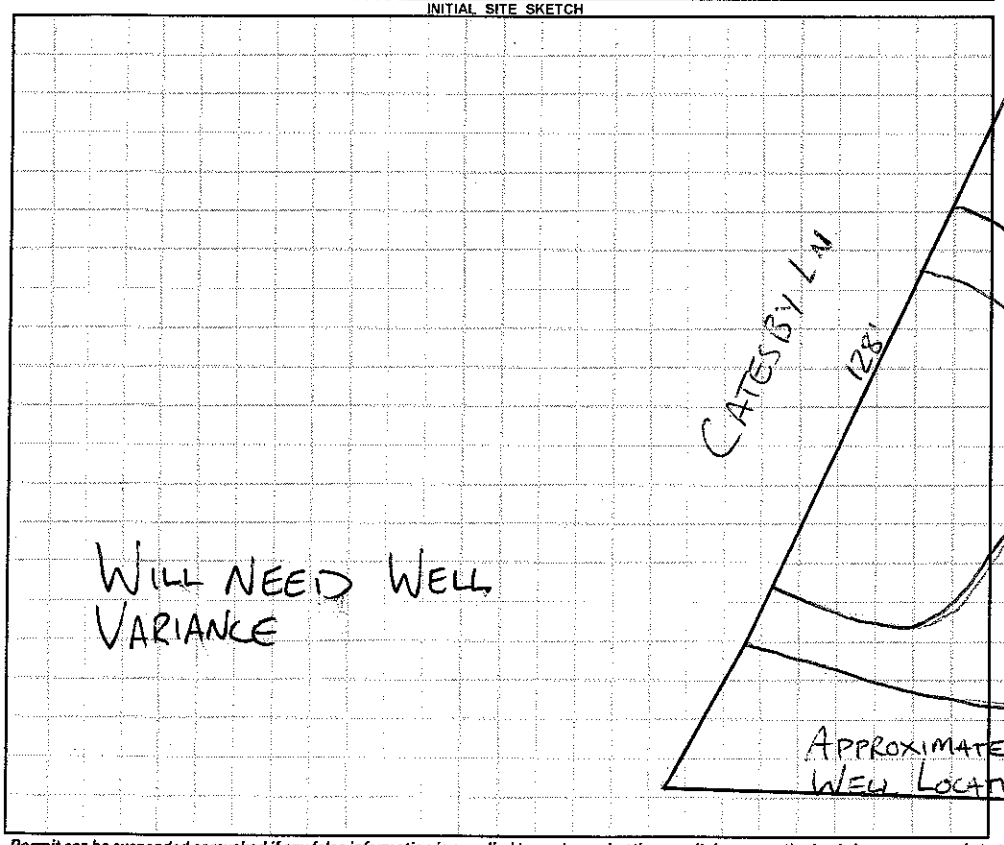

AS BUILT SKETCH

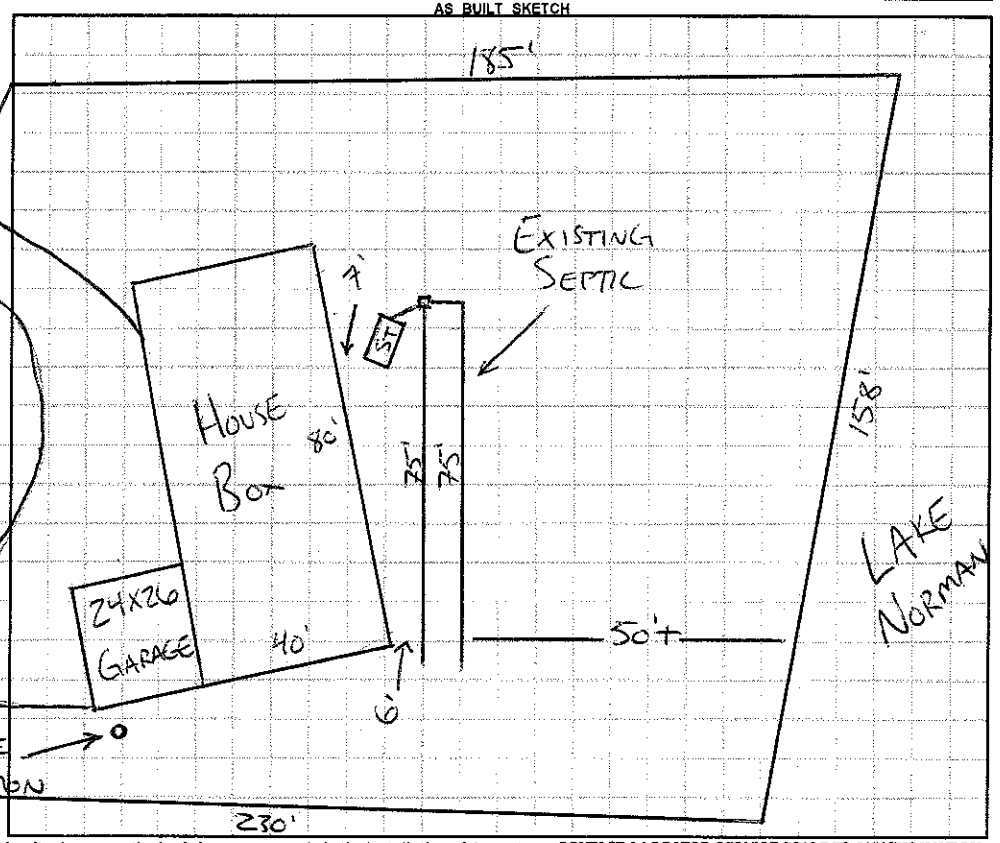

Permit can be suspended or revoked if any false information is supplied toward securing the permit / any unauthorized changes are made to the site / any unauthorized changes are made in the installation of the system. **CONTACT A LOCATOR SERVICE PRIOR TO ANY EXCAVATION**

☐ **IMPROVEMENT PERMIT** *with plat valid without expiration.* ☐ **IMPROVEMENT PERMIT** *with site plan valid for 60 mos.* ☐ **AUTHORIZATION TO CONSTRUCT** *valid for period equal to IMPROVEMENT PERMIT--not to exceed 60 mo.*

Owner / Applicant Signature: Ronnie Broome Date: 11/21/13 Installed by:

IMPROVEMENT PERMIT by: Date: OPERATION PERMIT by: Date:

AUTHORIZATION TO CONSTRUCT by: Date: Existing System Inspected by: BA Date: 11-19-13

Health Dept. Copy - WHITE Applicant (Final Approval) - YELLOW Applicant (Conditional Approval) - PINK