10:00

IREDELL COUNTY HEALTH DEPARTMENT

STATESVILLE 704-878-5305 MOORESVILLE 704-664-5281

IMPROVEMENT PERMIT / AUTHORIZATION TO CONSTRUCT / OPERATION PERMIT / EXISTING SYSTEM INSPECTION

PERMIT # REPAIR PIN # 4615-80-8518 DATE 6-17-09

OWNER or APPLICANT FRANK GREISS PHONE: Business Home:

OWNER or APPLICANT ADDRESS 518 STONEMARKER RD

LOCATION / DIRECTIONS BSR, TR STONEMARKER, 518

SUBDIVISION CL+T BLOCK / SECTION 6 LOT # 143 LOT AREA .71AC DESIGN FLOW 360 L.T.A.R.

Septic Tank 1000 Gallons: STB 760 Date 5-12-09
Pump Tank Gallons: P T Date
Pump Make Model Serial #
Nitrification Field No Fields No Lines Linear Feet
Trench Width EXISTING Max. Trench Bottom Depth Gravel Depth


☐ New System ☒ Repair ☐ Expansion System Type I (II) III IV V VI
System Description: NEW 1000 GAL TANK
Repair System Description:
Maintenance Agreement Required ☐ YES ☒ NO
☒ GRAVITY ☐ PRESSURE

☒ Residence No. Bedrooms 3
☐ Business No. Persons
☐ Other No. Employees
☐ Slab ☐ Crawl Space
☒ Basement w/plumbing ☐ Basement w/o plumbing

Water Supply: ☒ Private ☐ Public ☐ Community


Comments / Conditions
1) CRUSH & FILL OLD TANK
2) NEW TANK MUST BE 50' OFF LAKE
3) CONNECT TO EXISTING DRAIN FIELD

INITIAL SITE SKETCH

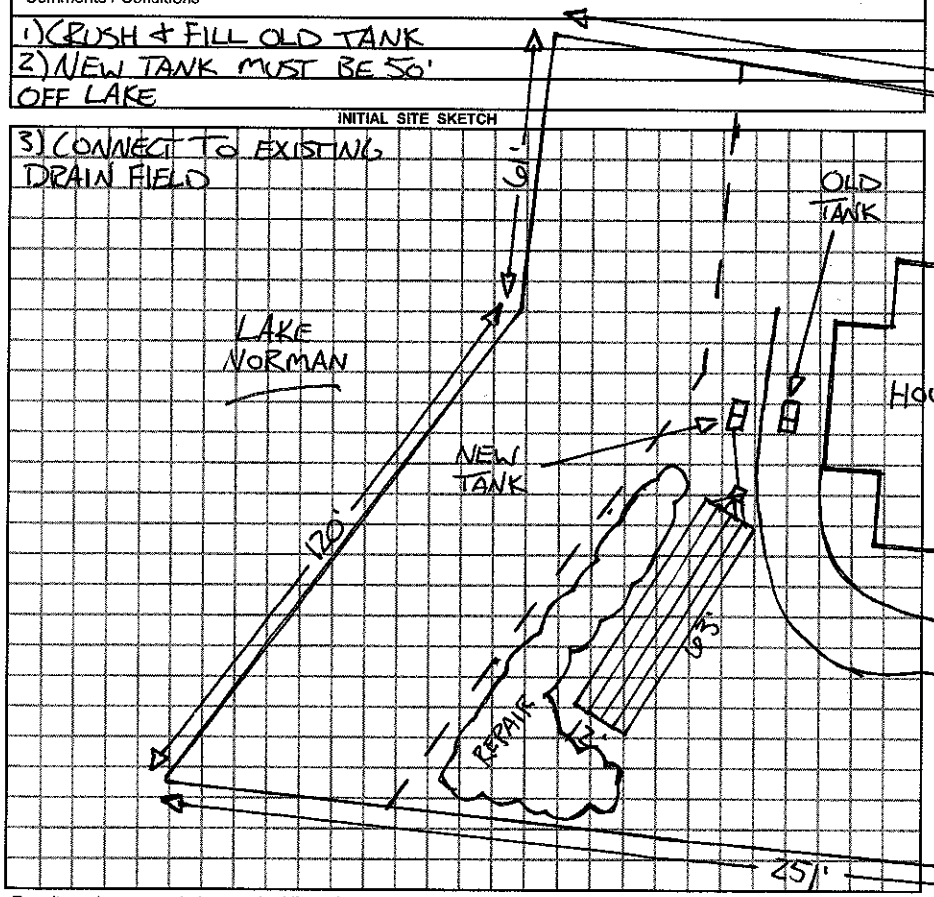

Comments / Conditions

AS BUILT SKETCH

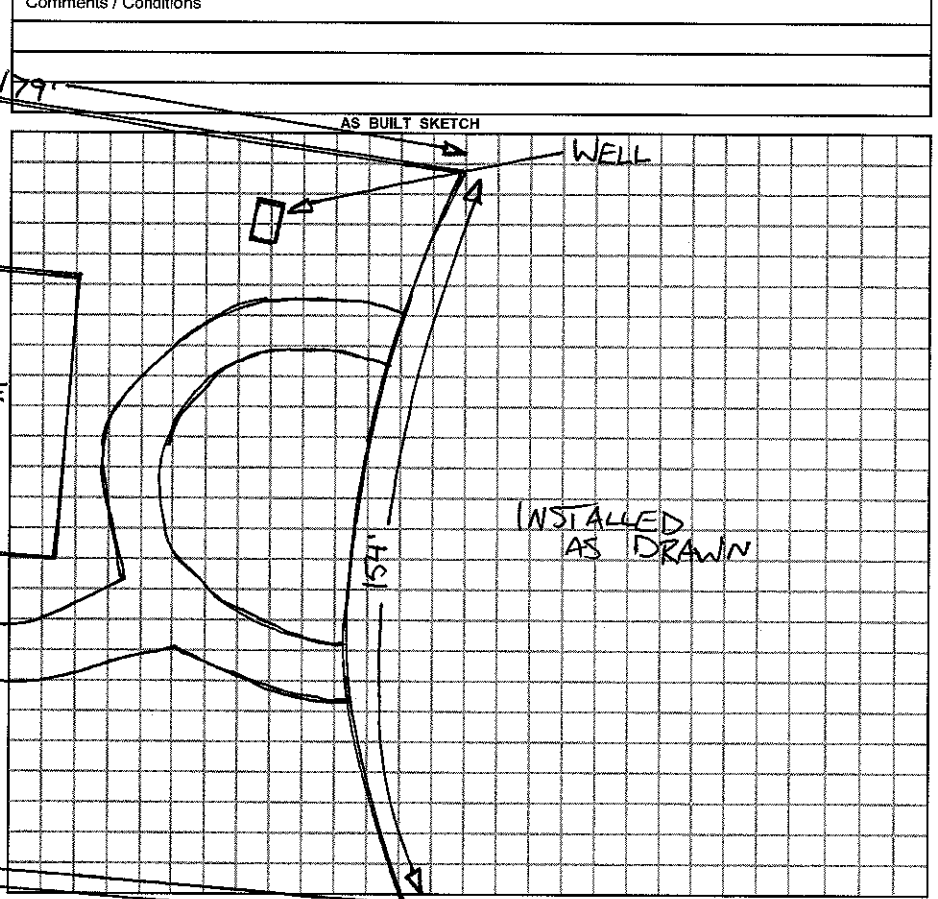

Permit can be suspended or revoked if any false information is supplied toward securing the permit / any unauthorized changes are made to the site / any unauthorized changes are made in the installation of the system.

☐ *IMPROVEMENT PERMIT w / plat valid without expiration.* ☐ *IMPROVEMENT PERMIT w / site plan valid for 60 mos.* ☒ *AUTHORIZATION TO CONSTRUCT valid for period equal to IMPROVEMENT PERMIT-not to exceed 60 mo.*

Owner / Applicant Signature: Date
Improvement Permit by: Date 6-17-09
Authorization to Construct by: Date 6-17-09

YOU SHOULD CONTACT A LOCATOR SERVICE PRIOR TO ANY EXCAVATION.

Installed by: LEATZ + A-1
Operation Permit by: Date: 6-18-09
Existing System Inspected by: Date:

WHITE COPY Environmental Health YELLOW COPY (Final) Owner / Applicant PINK COPY (Initial) Owner / Applicant