2 00

IREDELL COUNTY HEALTH DEPARTMENT

STATESVILLE 704-878-5305 MOORESVILLE 704-664-5281

IMPROVEMENT PERMIT / AUTHORIZATION TO CONSTRUCT / OPERATION PERMIT / EXISTING SYSTEM INSPECTION

PERMIT# 139748 PIN# 4615809534 DATE 2-1-07

OWNER OR APPLICANT Mark Weigel PHONE: Business 704-295-3600 Home 704-332-9214

ADDRESS 1659 Scotland Ave

LOCATION Brawley School Rd TR stonemarker on right

SUBDIVISION CL&T BLOCK / SECTION 6 LOT 142C LOT AREA .61 Ac SITE CLASS. PS DESIGN FLOW 480gpd L.T.A.R. .3 gpd / ft²

Septic Tank: 1000 Gallons: STB 317 Date 3/6/07

Pump Tank: 1000 Gallons: PT 27 Date 1/20/08

Pump Make: Gulas Model WE0 10P2HH No.

Nitrification Field: No Fields 1 Square Feet 1600 Linear Feet 270'

No Lines 4 Trench Width 24" Max Trench Bottom Depth 36"

☒ New System ☐ Repair ☐ Expansion System Type: I II III (IV) V VI

System Description: LPP Panel

Repair System Description: max. feasible Rule .1945

Maintenance Agreement Required: ☒ Yes ☐ No

☒ House/Mod. Home No. Bedrooms 4

☐ Mobile Home No. Persons 8

☐ Business No. Employees

☐ Other

Water Supply: ☒ Individual ☐ Public ☐ Community

Gravel Depth N/A ☐ Gravity ☒ Pressure ☐ Slab ☐ Crawl Space ☒ Basement w/plumbing ☐ Basement wo/plumbing


Comments:/Conditions:

Neighbor's wells

* Where supply line crosses between 50' & 25' well setback - pipe must be leakproof such as ductile iron & mechanical joints equiv. to water main stds.

1"=40'

INITIAL SITE SKETCH

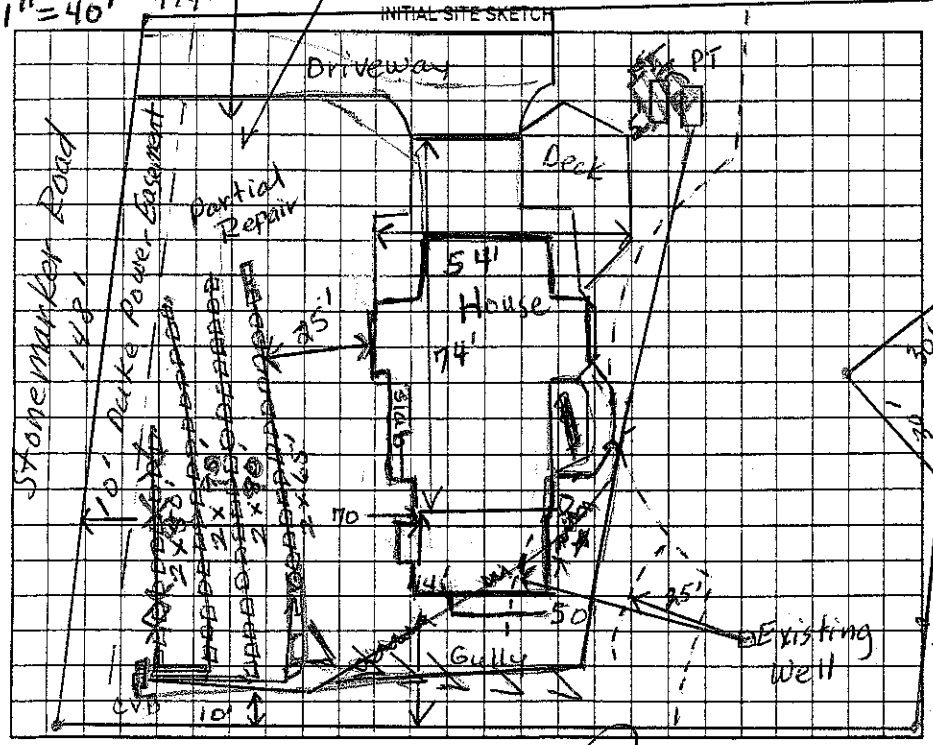

Comments:/Conditions:

AS BUILT SKETCH

System and supply lines must be 5' from building or deck posts

9/30/08 - TGH FURNISH & INST 3@90'x3' TRENCHES - AWS

3/16" Holes - 3@90'x3' - CVB

Permit can be suspended or revoked if any false information is supplied toward securing the permit/any unauthorized changes are made to the site/any unauthorized changes are made in the installation of the system. Improvement Permit with plat valid without expiration ☐ Improvement Permit with site plan valid for sixty months ☒ Authorization to Construct is valid for a period equal to that of Improvement Permit – not to exceed sixty months.

Signed: Mark S. Weigel date 2/8/07

Improvement Permit by: Judy McNilly date 2-1-07

Authorization to Construct by: Judy McNilly date 2-1-07

Installed by: PT Erwin

Operation Permit by: Wesley Sparkes R.S. date 10/22/08

Existing System Inspection by: date

HEALTH DEPT. COPY: WHITE OWNER COPY (FINAL): YELLOW OWNER COPY (INITIAL): PINK