IREDELL COUNTY HEALTH DEPARTMENT

STATESVILLE 704-878-5305 MOORESVILLE 704-664-5281

IMPROVEMENT PERMIT / AUTHORIZATION TO CONSTRUCT / OPERATION PERMIT / EXISTING SYSTEM INSPECTION

PERMIT# 18889 PIN# 2014134 DATE 4/13/98

OWNER OR CONTRACTOR RON FREEMAN PHONE: Business Home

ADDRESS 3500 PLEASANT PLAINS RD - STATESVILLE NC 28105

LOCATION BRAWLEY SCHOOL - TR STONEMARKER - ¼ MILE ON RT PAST FAWN LANE

SUBDIVISION CLT BLOCK / SECTION 6 LOT 134 LOT AREA .694C SITE CLASS PS DESIGN FLOW 360 GPD L.T.A.R. .3 GAD/FT²

Septic Tank: 1000 Gallons; STB 821 Date 2/4/98
Pump Tank: Gallons; PT Date
Pump Make: Model Serial No.
Nitrification Field: No Fields 1 Square Feet 900 Linear Feet 300
No Lines @ 5@60' Trench Width @ 36" Max Trench Bottom Depth 36" Gravel Depth N/A

☑ New System ☐ Repair System Type: I, II, III, IV, V, VI
System Description: GRAVITY CHAMBERS OR HDS
Repair System Description: PUMP PANEL
Maintenance Agreement Required: ☐ Yes ☑ No


☑ House/Mod. Home No. Bedrooms 3
☐ Mobile Home No. Bathrooms 2.5
☐ Business No. Employees
☐ Other
☐ Slab ☑ Crawl Space ☐ Basement w/plumbing ☐ Basement wo/plumbing

Water Supply: ☑ Individual ☐ Public ☐ Community

Comments:/Conditions:

Comments:/Conditions:
EZ LAY INSTALLED

INITIAL SITE SKETCH NO SCALE

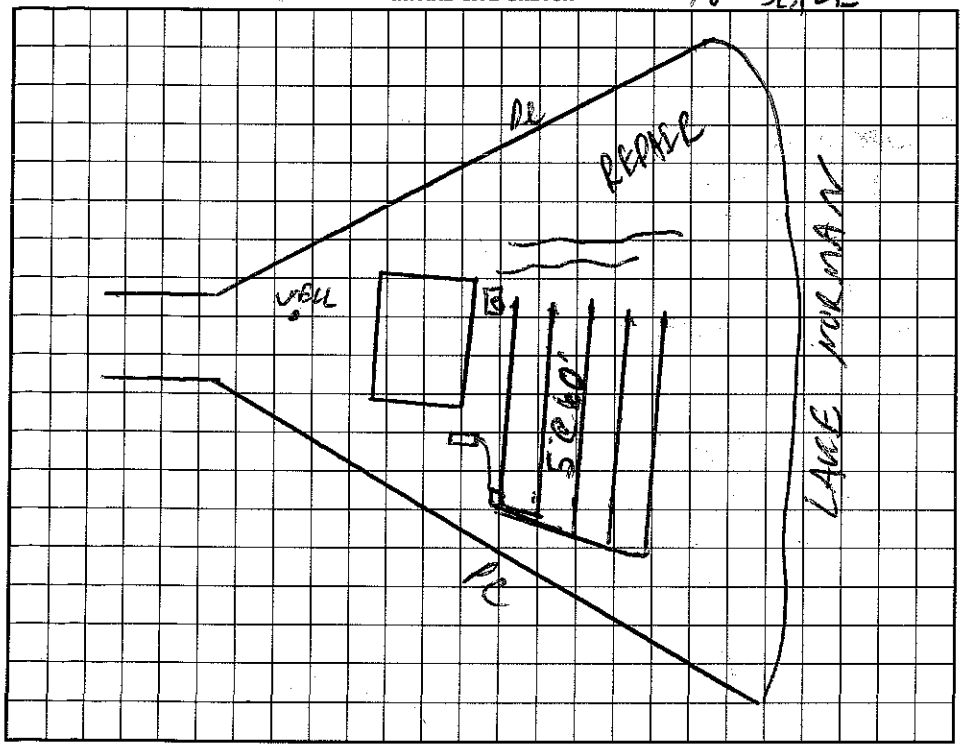

AS BUILT SKETCH

I understand that this permit can be suspended or revoked if any false information is supplied toward securing the permit/any unauthorized changes are made to the site/any unauthorized changes are made in the installation of the system. Improvement Permit with plat valid without expiration. Improvement Permit with site plan valid for sixty months. Authorization to Construct is valid for a period equal to that of Improvement Permit – not to exceed sixty months.

Signed: date

Improvement Permit by: date 4/13/98

Authorization to Construct by: date 4/13/98

Installed by: DENNIS WILLIS

Operation Permit by: date 4/27/98

Existing System Inspection by: date

HEALTH DEPT. COPY: WHITE INSPECTION COPY (FINAL): GREEN OWNER COPY (FINAL): YELLOW INSPECTION COPY (INITIAL): PINK OWNER COPY (INITIAL): GOLD