IREDELL COUNTY HEALTH DEPARTMENT - *ENVIRONMENTAL HEALTH* ☐ STATESVILLE OFFICE 704-878-5305 ☑ MOORESVILLE OFFICE 704-664-5281

IMPROVEMENT PERMIT / AUTHORIZATION TO CONSTRUCT / OPERATION PERMIT / EXISTING SYSTEM INSPECTION

PERMIT # REPAIR PIN # 4615-89-4613 DATE 4-12-12

OWNER VERCHEL HUDSON APPLICANT: SUZIE McCANN PHONE: Home/Cell # 704-451-7501 Business #

SITE ADDRESS 435 BARBER LOOP OWNER / APPLICANT ADDRESS 522 RIVER HWY MOORESVILLE 28117

SITE DIRECTIONS BSR, CHUCKWOOD, TL 1ST BARBER LOOP ON L

SUBDIVISION CL&T BLOCK / SECTION 7 LOT # 99 LOT AREA 7AC DESIGN FLOW 360 L.T.A.R.

Septic Tank 1000 Gallons: STB 186 Date 11-7-11

Pump Tank Gallons: P T Date

Pump Make Model Serial #

No. Nitrification Fields: No. Lines Lineal Feet

Trench Width EXISTING Max. Trench Bottom Depth Gravel Depth 10"

☐ New System ☑ Repair ☐ Expansion System Type I II III IV V VI

System Description: TANK

Repair System Description:

Maintenance Agreement Required ☐ YES ☑ NO

☑ GRAVITY ☐ PRESSURE

☑ Residence No. Bedrooms 3

☐ Business No. Persons

☐ Other No. Employees

☐ Slab ☐ Crawl Space

☑ Basement w/plumbing ☐ Basement w/o plumbing

Water Supply

☑ Private


☐ Public

☐ Community


Comments / Conditions * GUTTER DRAINS NEED TO BE REROUTED AROUND SYSTEM

STROUP TANK

INITIAL SITE SKETCH

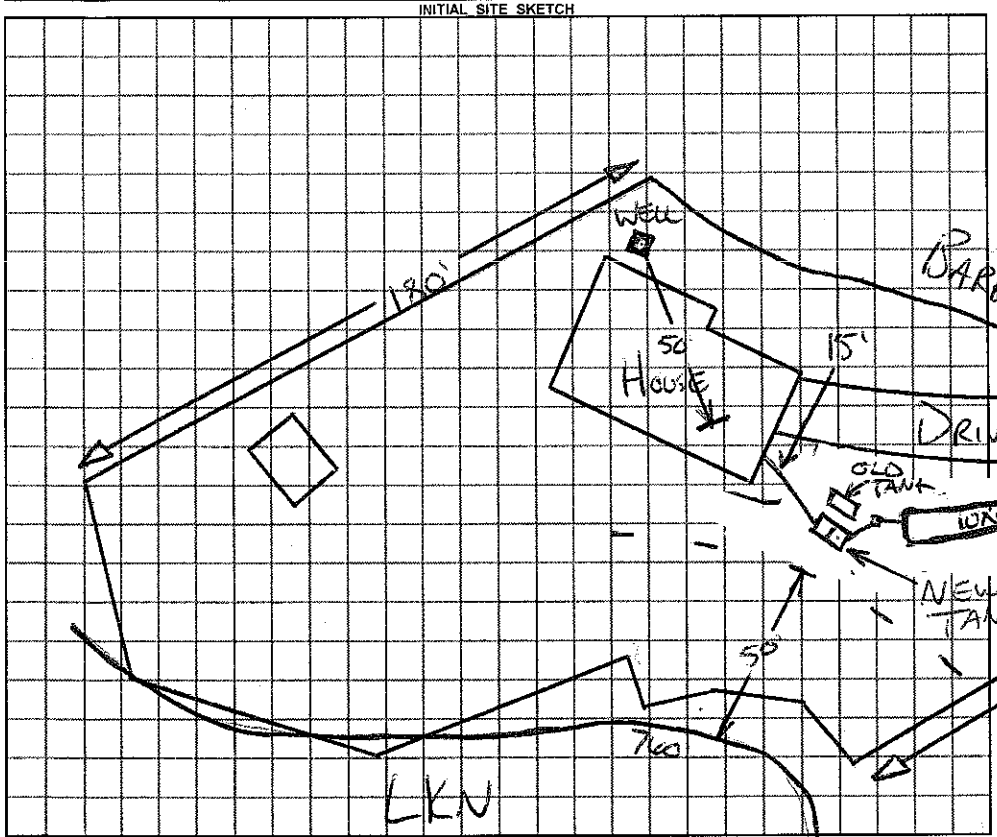

AS BUILT SKETCH

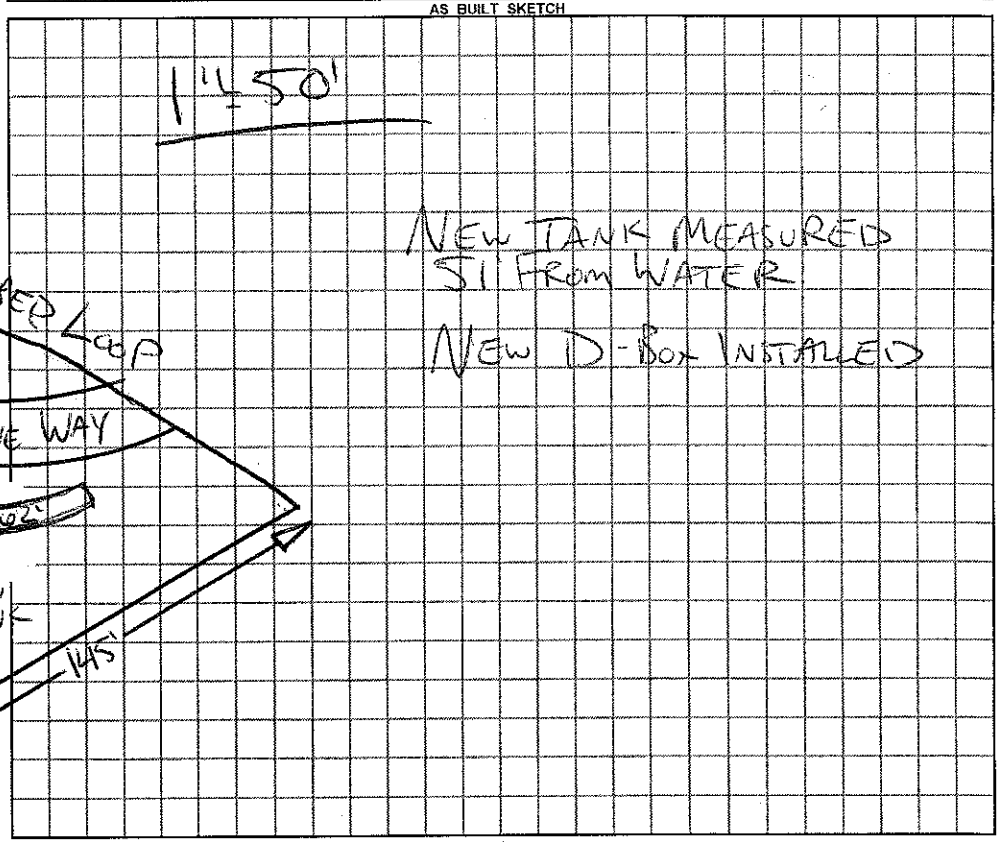

Permit can be suspended or revoked if any false information is supplied toward securing the permit / any unauthorized changes are made to the site / any unauthorized changes are made in the installation of the system.

☐ ***IMPROVEMENT PERMIT*** with plat valid without expiration. ☐ ***IMPROVEMENT PERMIT*** with ~~plat valid without expiration.~~ ***site plan valid 60 mo.*** ☑ ***AUTHORIZATION TO CONSTRUCT*** valid for period equal to IMPROVEMENT PERMIT--not to exceed 60 mo.

Owner / Applicant Signature: Suzie McCann Date 4-12-12 Installed by:

IMPROVEMENT PERMIT by: REHS Date 4-12-12 OPERATION PERMIT by: REHS Date 5-22-12

AUTHORIZATION TO CONSTRUCT by: REHS Date 4-12-12 Existing System Inspected by: REHS Date

YOU SHOULD CONTACT A LOCATOR SERVICE PRIOR TO ANY EXCAVATION

White Copy – Environmental Health YELLOW COPY (Final) Owner / Applicant PINK COPY (Initial) Owner / Applicant