IREDELL COUNTY HEALTH DEPARTMENT

STATESVILLE 704-878-5305 MOORESVILLE 704-664-5281

IMPROVEMENT PERMIT / AUTHORIZATION TO CONSTRUCT / OPERATION PERMIT / EXISTING SYSTEM INSPECTION

PERMIT# 108688 PIN# 4615 90 3962 DATE 9/23/02

OWNER OR CONTRACTOR Kelly Bldg. + Dev. Corp. PHONE: Business 704-664-9222 Home

ADDRESS PO Box 3081 Mooresville, NC. 28117

LOCATION 1100 TR Stonemarker TL Blenny TR Stonemarker last on (L) where old pavement begins

SUBDIVISION ~~CL+F Stonemarker~~ BLOCK / SECTION 6 LOT 137C LOT AREA ~1.70 SITE CLASS PS DESIGN FLOW 360 L.T.A.R. .3

Septic Tank: 1000 Gallons; STB 794 Date 3/14/03
Pump Tank: 1000 Gallons; PT 283 Date 4/2/03
Pump Make: Myers Model P102 Serial No.
Nitrification Field: ~~No~~ Fields 1 Square Feet * 900 Linear Feet * 300
No Lines 4@75' Trench Width 3' Max Trench Bottom Depth 36" Gravel Depth No

[X] New System [ ] Repair System Type: I, II, (III), IV, V, VI
System Description: PM → Type 3 Drainfield *
Repair System Description: 16" PP3PS
Maintenance Agreement Required: [ ] Yes [X] No


[X] House/Mod. Home No. Bedrooms 3
[ ] Mobile Home No. Bathrooms 3
[ ] Business No. Employees
[ ] Other
[ ] Slab [ ] Crawl Space [X] Basement w/plumbing [ ] Basement wo/plumbing

Water Supply: [X] Individual [ ] Public [ ] Community


Comments/Conditions: * This is a 75% reduced system.
S/T + P/T must be over 50' inside the lot from 760 contour line

Comments/Conditions: * Tanks Checked 6/9/03 MD
Lines checked 6/12/03 by WS
Pressure, elect. & alarm 6/24/03 MD

INITIAL SITE SKETCH (1"=50')

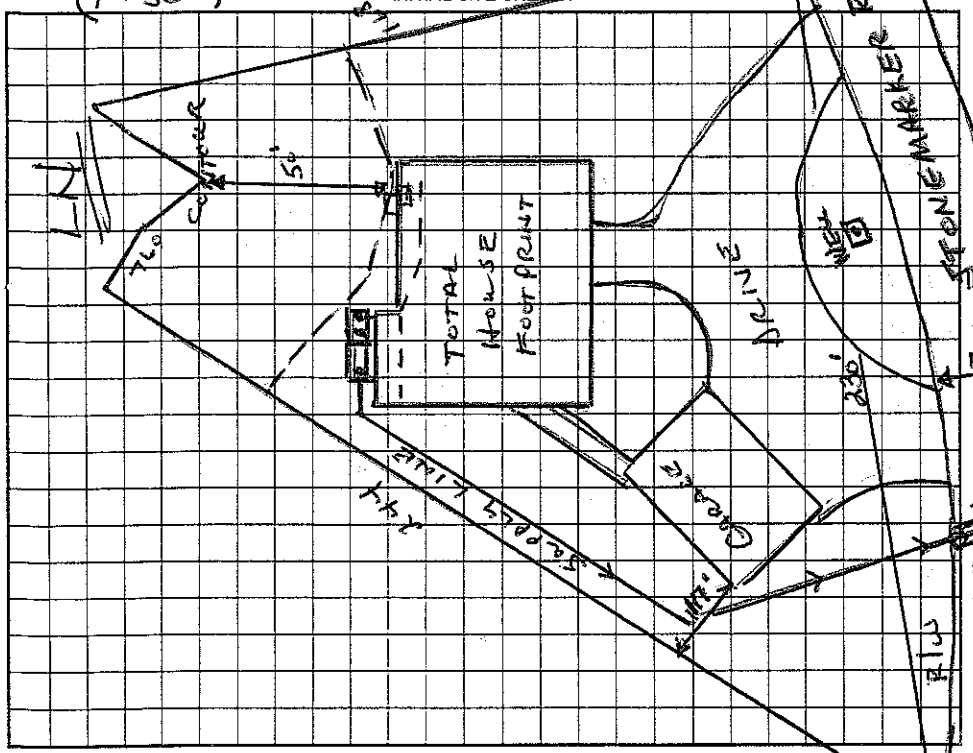

AS BUILT SKETCH

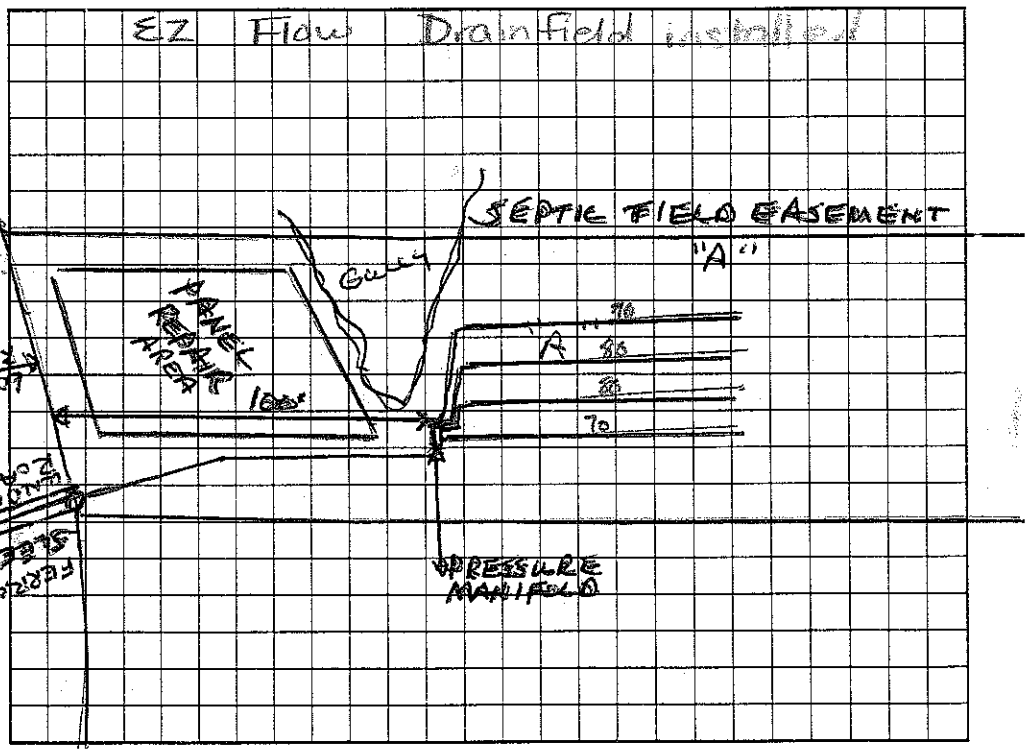

Permit can be suspended or revoked if any false information is supplied toward securing the permit/any unauthorized changes are made to the site/any unauthorized changes are made in the installation of the system. Improvement Permit with plat valid without expiration. Improvement Permit with site plan valid for sixty months. Authorization to Construct is valid for a period equal to that of Improvement Permit – not to exceed sixty months.

Signed: *Frances M Kelly, Sec/Treas KBD date

Improvement Permit by: Wesley Sparks R.S. date 9/23/02

Authorization to Construct by: Wesley Sparks R.S. date 9/23/02

Installed by: R & H

Operation Permit by: Marvin Watson R.S. date 6/24/03

Existing System Inspection by: date

HEALTH DEPT. COPY: WHITE OWNER COPY (FINAL): YELLOW OWNER COPY (INITIAL): PINK