IREDELL COUNTY HEALTH DEPARTMENT

STATESVILLE 704-878-5305 MOORESVILLE 704-664-5281

IMPROVEMENT PERMIT / AUTHORIZATION TO CONSTRUCT / OPERATION PERMIT / EXISTING SYSTEM INSPECTION

PERMIT# 073270 PIN# 4615 90 3962 DATE 5/28/98

OWNER OR CONTRACTOR Marshall Investment Group PHONE: Business 896-5552 Home

ADDRESS 19701-D Hwy 73 Cornelius, NC. 28031

LOCATION Stonemarker Rd, 1100 TR. Stonemarker TL Blarney TR Stonemarker on (L) just past where new pavement begins

SUBDIVISION STONEMARKE BLOCK / SECTION 6 LOT 137C LOT AREA ~.70 SITE CLASS. DESIGN FLOW L.T.A.R.

Septic Tank: 1000 Gallons; STB Date

Pump Tank: 1000 Gallons; PT Date

Pump Make: Model Serial No.

Nitrification Field: No Fields 1 Square Feet *900 Linear Feet *300

No Lines 4 Trench Width 36" Max Trench Bottom Depth 36" Gravel Depth SAND

[X] New System [ ] Repair System Type: I, II, (III), IV, V, VI

System Description: Pres Manifold - Ch. PLASTIC

Repair System Description: PPBS-16

Maintenance Agreement Required: [ ] Yes [X] No

[X] House/Mod. Home No. Bedrooms 3

[ ] Mobile Home No. Bathrooms 3

[ ] Business No. Employees

[ ] Other

[ ] Slab [ ] Crawl Space [X] Basement w/plumbing [ ] Basement wo/plumbing


Water Supply: [X] Individual [ ] Public [ ] Community

Comments:/Conditions: * 25% for use of Chemlawn P.lastic materials


Comments:/Conditions:

1" = 50'

INITIAL SITE SKETCH

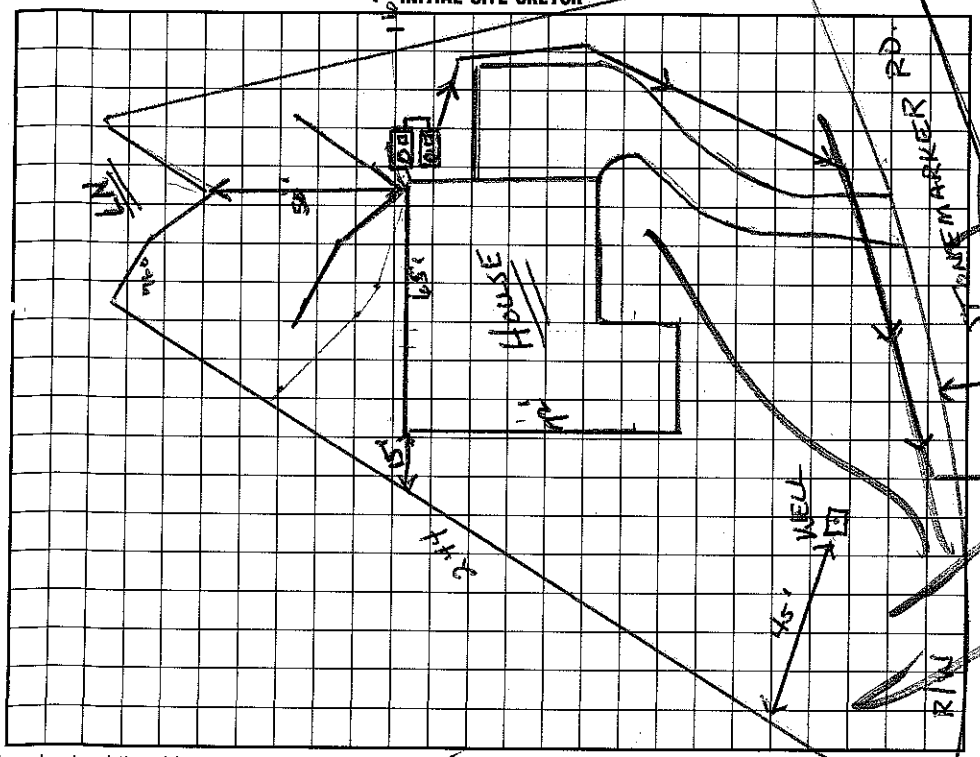

AS BUILT SKETCH

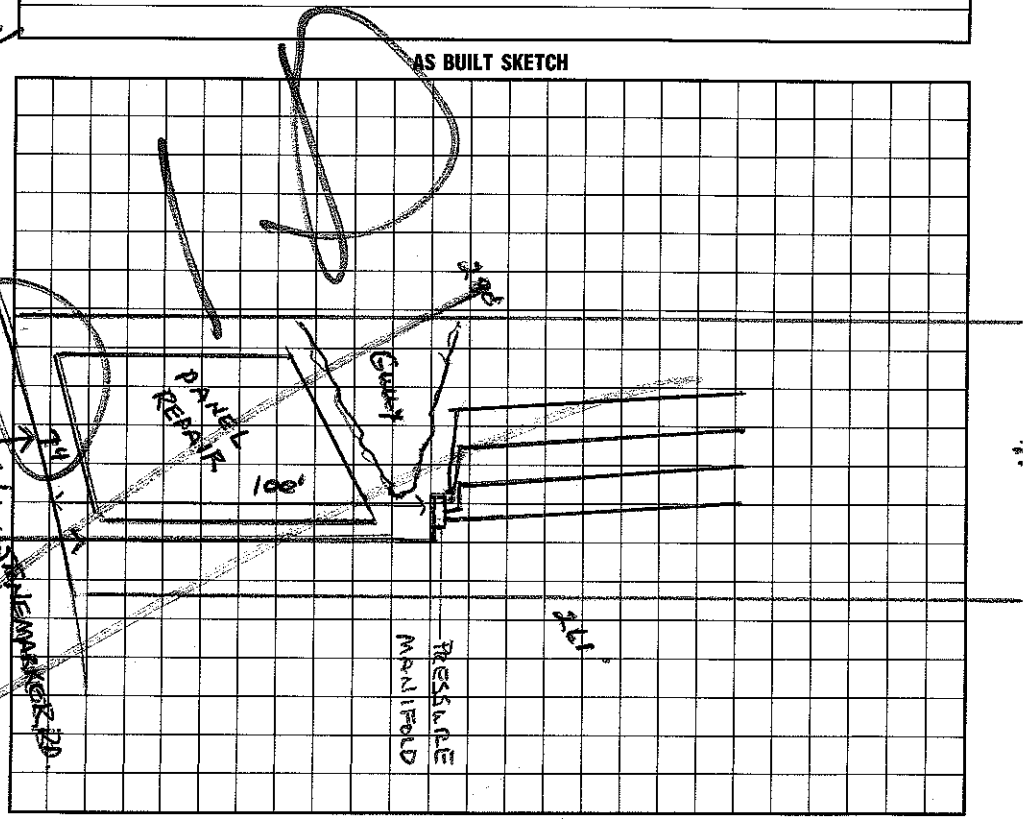

I understand that this permit can be suspended or revoked if any false information is supplied toward securing the permit/any unauthorized changes are made to the site/any unauthorized changes are made in the installation of the system. Improvement Permit with plat valid without expiration. Improvement Permit with site plan valid for sixty months. Authorization to Construct is valid for a period equal to that of Improvement Permit – not to exceed sixty months.

Signed: * Mgr. date 7/10/98

Improvement Permit by: Wesley Sparks RS. date 5/28/98

Authorization to Construct by: Wesley Sparks RS. date 5/28/98

Installed by:

Operation Permit by: date

Existing System Inspection by: date

HEALTH DEPT. COPY: WHITE INSPECTION COPY (FINAL): GREEN OWNER COPY (FINAL): YELLOW INSPECTION COPY (INITIAL): PINK OWNER COPY (INITIAL): GOLD