IREDELL COUNTY HEALTH DEPARTMENT

STATESVILLE 704-878-5305 MOORESVILLE 704-664-5281

IMPROVEMENT PERMIT / CERTIFICATE OF COMPLETION / OPERATION PERMIT / EXISTING SYSTEM INSPECTION

PROPERTY DESCRIPTION NO. 20880 DATE 6/14/95 TAX MAP NO. 2D 1A 132 C + EASMENT "A" Watershed: ☐ Yes ☐ No

OWNER OR CONTRACTOR Robert Jordan PHONE: Business 333-7547 Home

ADDRESS 4044 Buxton Ln. Denver NC. 28037

LOCATION W Stonemarker Rd. on (L) just below where new pavement begins

SUBDIVISION CL+T BLOCK / SECTION 6 LOT 137C LOT AREA ~1.55A± SITE CLASS. PS DESIGN FLOW 360 L.T.A.R. .3

Septic Tank: 1000 Gallons; STB Date

Pump Tank: 1000 Gallons; PT Date

Pump Make: Model Serial No.

Nitrification Field: No Fields 1 Square Feet 1200 Linear Feet ~~300~~ (400)

No Lines 4 Trench Width 36" Max Trench Bottom Depth 36"

☒ New System ☐ Repair System Type: I, II, (III), IV, V, VI

System Description: Pressure to INFILTRATOR

Repair System Description: Panel

Maintenance Agreement Required: ☒ Yes ☐ No

Gravel Depth N/A

☒ House/Mod. Home No. Bedrooms 3

☐ Mobile Home No. Bathrooms 2.5

☐ Business No. Employees

☐ Other


☐ Slab ☒ Crawl Space ☐ Basement w/plumbing ☒ Basement wo/plumbing

Water Supply: ☒ Individual ☐ Community ☐ Public


Comments: ~~X~~ 25% reduction for INFILTRATOR
3" Sch 80 PVC Pressure Manifold w/ 4½" Io Tops
1 to each drainline
Sch 80 on quarter under W Stonemarker Rd to R/W

Comments:

INITIAL SITE SKETCH — DRAIN FIELD

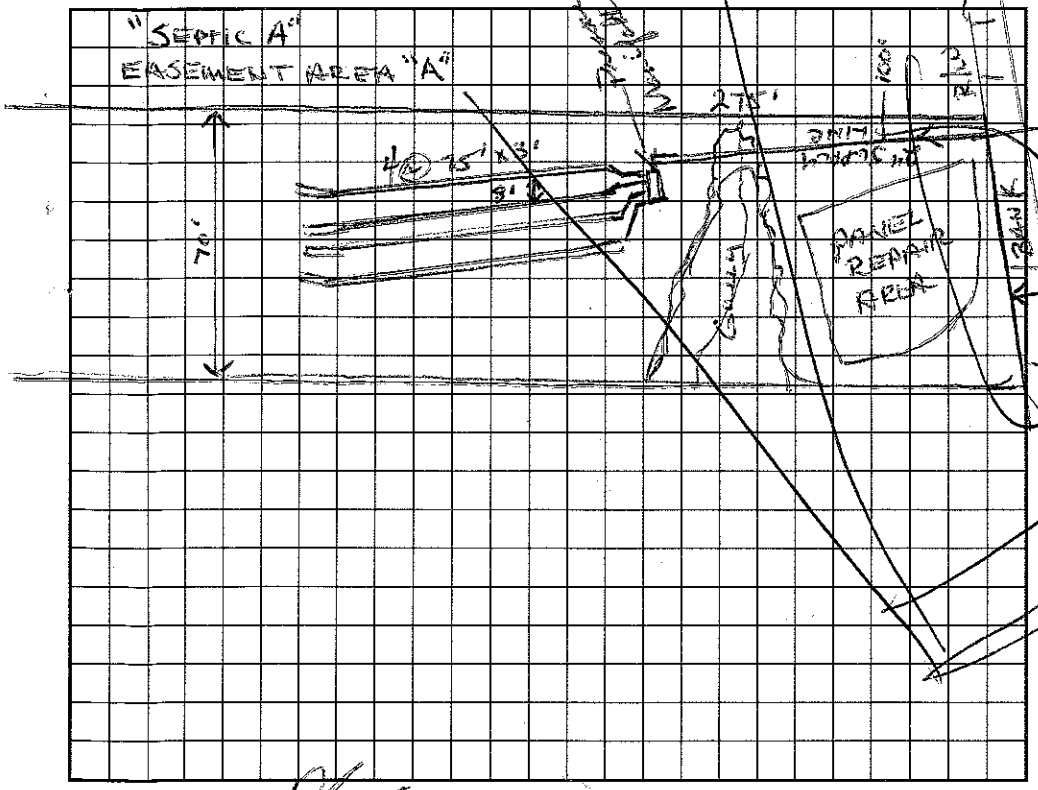

INITIAL ~~AS-BUILT SKETCH~~ HOUSE LOCATION

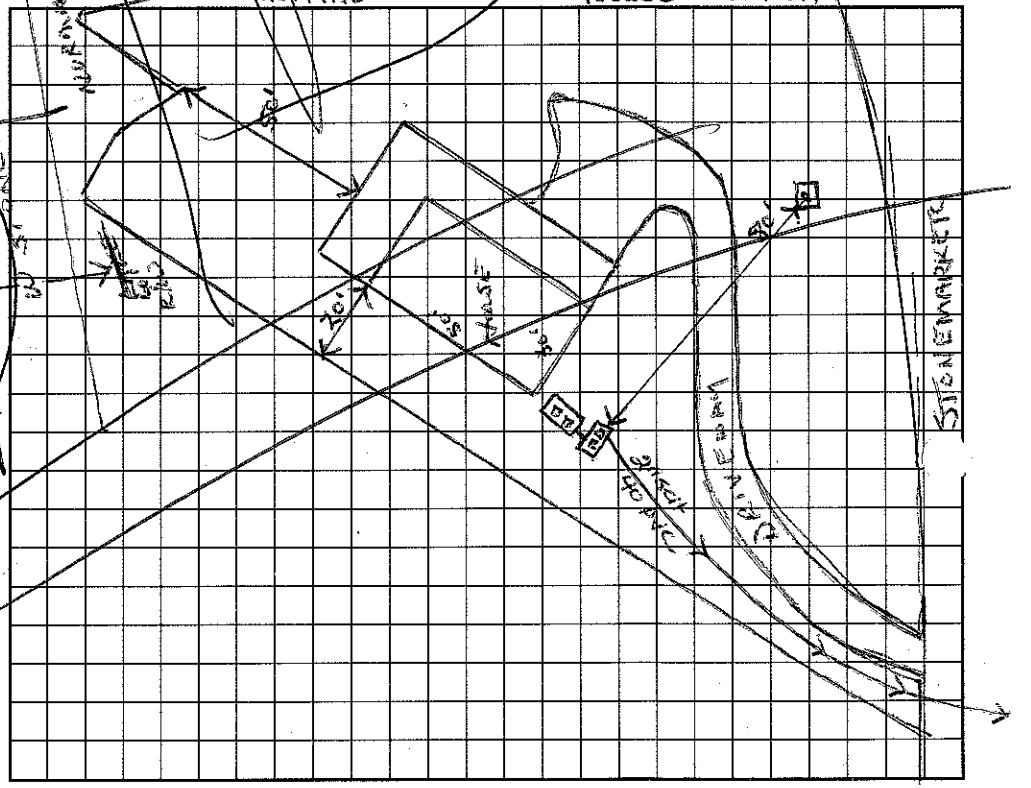

I understand that this permit can be suspended or revoked if any false information is supplied toward securing the permit/any unauthorized changes are made to the site/any unauthorized changes are made in the installation of the system. Improvement Permit is valid for 60 months from date of issuance.

Signed: X

Improvement Permit by: Wesley Sparks R.S. date 6/14/95

Existing System Inspection by: date

Installed by:

Certificate of Completion by: date

Operation Permit by: date

HEALTH DEPT. COPY: WHITE INSPECTION COPY (FINAL): GREEN OWNER COPY (FINAL): YELLOW INSPECTION COPY (INITIAL): PINK OWNER COPY (INITIAL): GOLD