IREDELL COUNTY HEALTH DEPARTMENT

Statesville Office (704) 878-5305 Mooresville Office (704) 660-3625 PERMIT # 127329

IMPROVEMENT PERMIT / AUTHORIZATION TO CONSTRUCT / OPERATION PERMIT / EXISTING SYSTEM

PIN # 4615-90-5475

APPLICANT: John C. Richards APPLICANT ADDRESS: P O Box 4613 Mooresville NC 28117

SITE ADDRESS: 483 Stonemarker PHONE: 704-804-4119 ALT. PHONE:

SITE DIRECTIONS: Brawley Sch Rd, Thru Traffic Cir, TR on Stonemarker, Approx. 1.3 miles on L


SUBDIVISION: Stonemarker SECTION: LOT # 15 LOT AREA: 0.913 ac DESIGN FLOW: 480 gpd L.T.A.R.: 0.25

Septic Tank	1000	(gal)	STB	160	Date	11-12-14	☑ New System	☐ Repair	☐ Expansion	System Type: I II (III) IV V VI	
Pump Tank		(gal)	PT		Date		System Description:	Gravity 25% Reduction			
Pump Make			Model		Serial #		Repair System Description:	LP PPBPS			
# Nitrification Fields	1		# Lines	6	Linear Ft:	480'	Maintenance Agreement Required:	☐ YES	☑ NO		
Trench Width	36"		Max. Trench Bottom Depth	36"	Gravel Depth	N/A	☑ GRAVITY	☐ PRESSURE			


☑ Residence	No. Bedrooms	4	Water Supply
☐ Business	No. Persons	8	☑ Private
☐ Other	No. Employees		☐ Public
☑ Slab	☑ Crawl Space		☐ Community
☐ Basement w/plumbing	☐ Basement w/o plumbing		

Comments / Conditions:

INITIAL SITE SKETCH

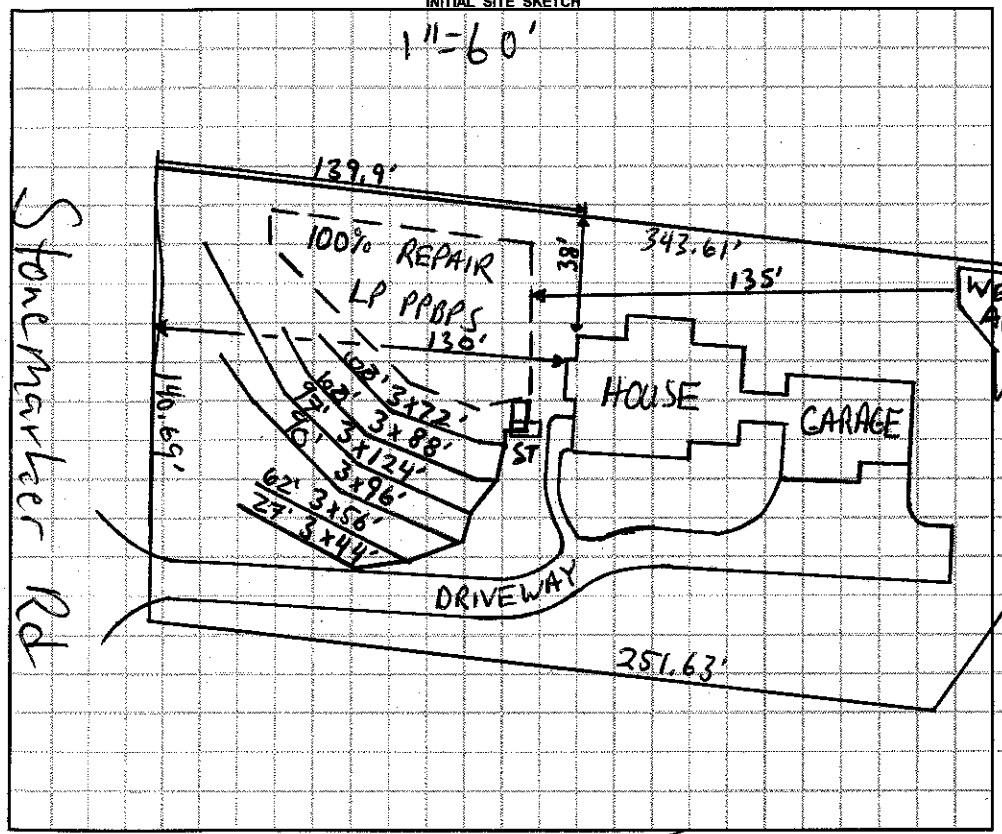

AS BUILT SKETCH

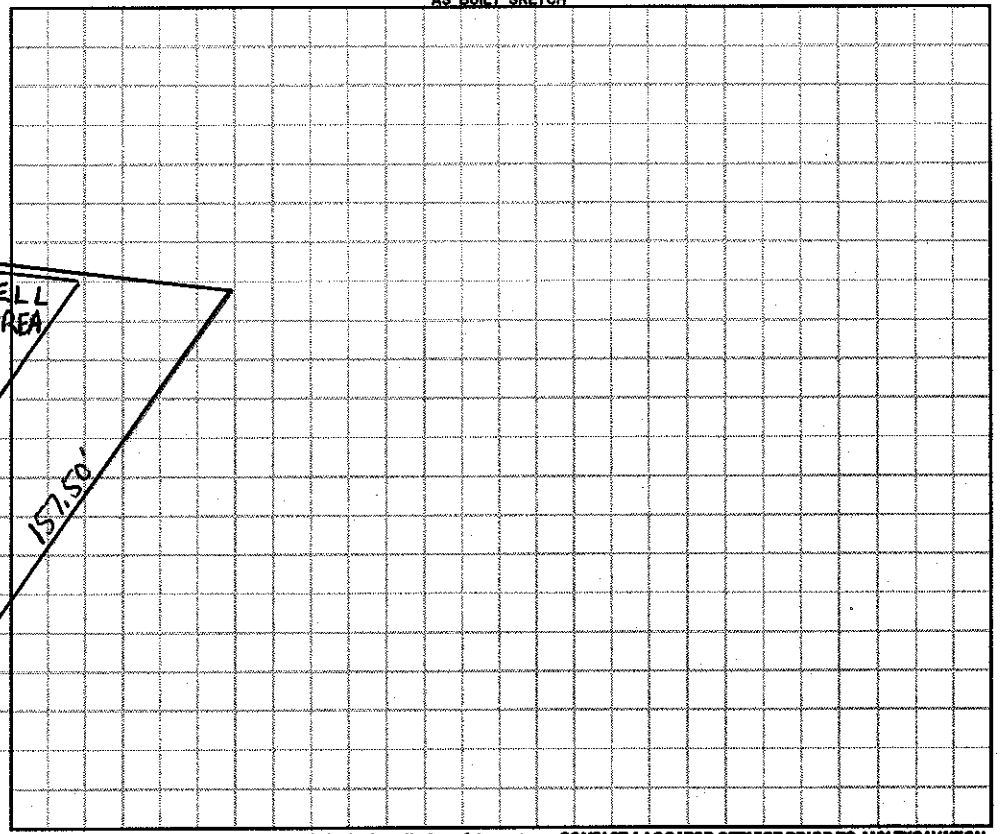

Permit can be suspended or revoked if any false information is supplied toward securing the permit / any unauthorized changes are made to the site / any unauthorized changes are made in the installation of the system. **CONTACT A LOCATOR SERVICE PRIOR TO ANY EXCAVATION**

☐ **IMPROVEMENT PERMIT** *with plat valid without expiration.* ☐ **IMPROVEMENT PERMIT** *with site plan valid for 60 mos.* ☑ **AUTHORIZATION TO CONSTRUCT** *valid for period equal to IMPROVEMENT PERMIT--not to exceed 60 mo.*

Owner / Applicant Signature: Date: 9-18-14 Installed by: K & M Grading

IMPROVEMENT PERMIT by: Date: 9-18-14 OPERATION PERMIT by: Date: 3-17-15

AUTHORIZATION TO CONSTRUCT by: Date: 9-18-14 Existing System Inspected by: Date:

Health Dept. Copy - WHITE Applicant (Final Approval) - YELLOW Applicant (Conditional Approval) - PINK