IREDELL COUNTY HEALTH DEPARTMENT

STATESVILLE 704-878-5305 MOORESVILLE 704-664-5281

IMPROVEMENT PERMIT / CERTIFICATE OF COMPLETION / OPERATION PERMIT / EXISTING SYSTEM INSPECTION

PROPERTY DESCRIPTION NO. 073617 DATE 5/8/98 TAX MAP NO. 4615 90 6282 Watershed: X Yes ☐ No

OWNER OR CONTRACTOR David T Wagner PHONE: Business _____ Home 664-1838

ADDRESS 597 Stonemarker Rd. Mooresville, NC. 28115

LOCATION Stonemarker Rd. 6m (R)

SUBDIVISION Stonemarker BLOCK / SECTION II LOT 9 LOT AREA .96 SITE CLASS. P5 DESIGN FLOW 600 L.T.A.R. .3

Septic Tank: 1500 Gallons; STB _____ Date _____

Pump Tank: _____ Gallons; PT _____ Date _____

Pump Make: _____ Model _____ Serial No. _____

Nitrification Field: No Fields ____ Square Feet 300 Linear Feet 100

No Lines 1 Trench Width 36" Max Trench Bottom Depth 36" Gravel Depth 12"

X New System ☐ Repair System Type: I (II) III, IV, V, VI

System Description: Addition

Repair System Description: _____

Maintenance Agreement Required: ☐ Yes ☐ No

X House/Mod. Home No. Bedrooms 5

☐ Mobile Home No. Bathrooms 3

☐ Business No. Employees ____

☐ Other _____


☐ Slab ☐ Crawl Space ☐ Basement w/plumbing ☐ Basement wo/plumbing

Water Supply:
X Individual
☐ Community
☐ Public


Comments: Adding one additional trenchline for 5th Bedroom

Comments:

INITIAL SITE SKETCH

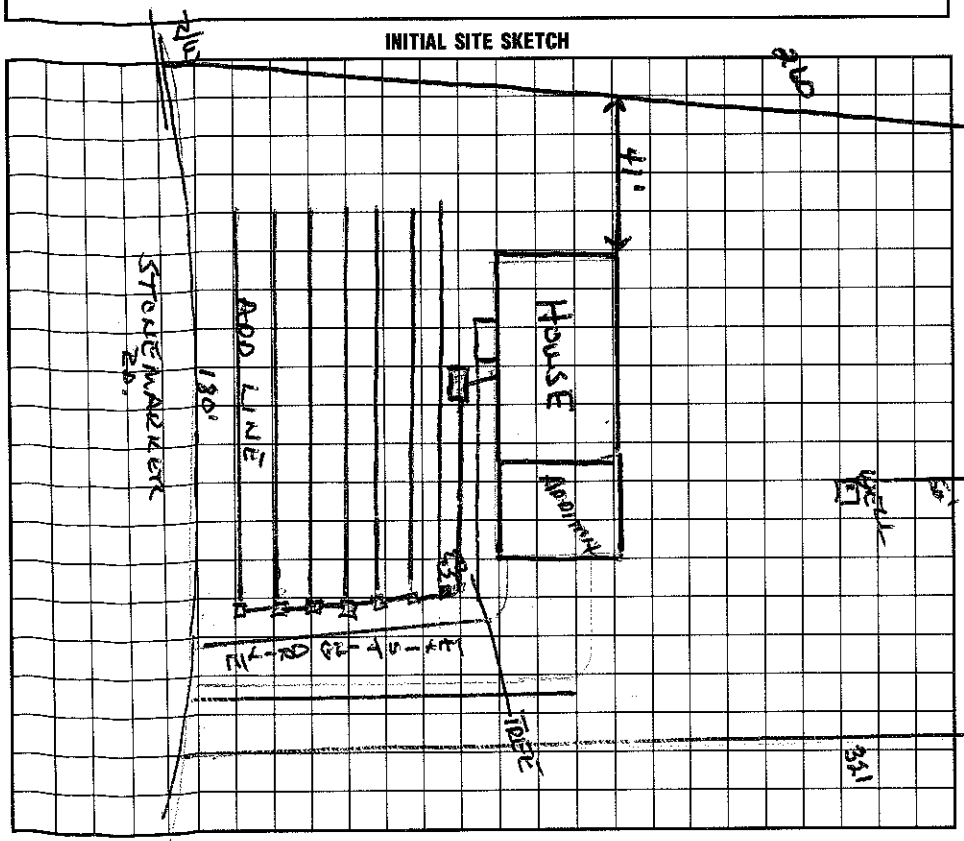

AS BUILT SKETCH

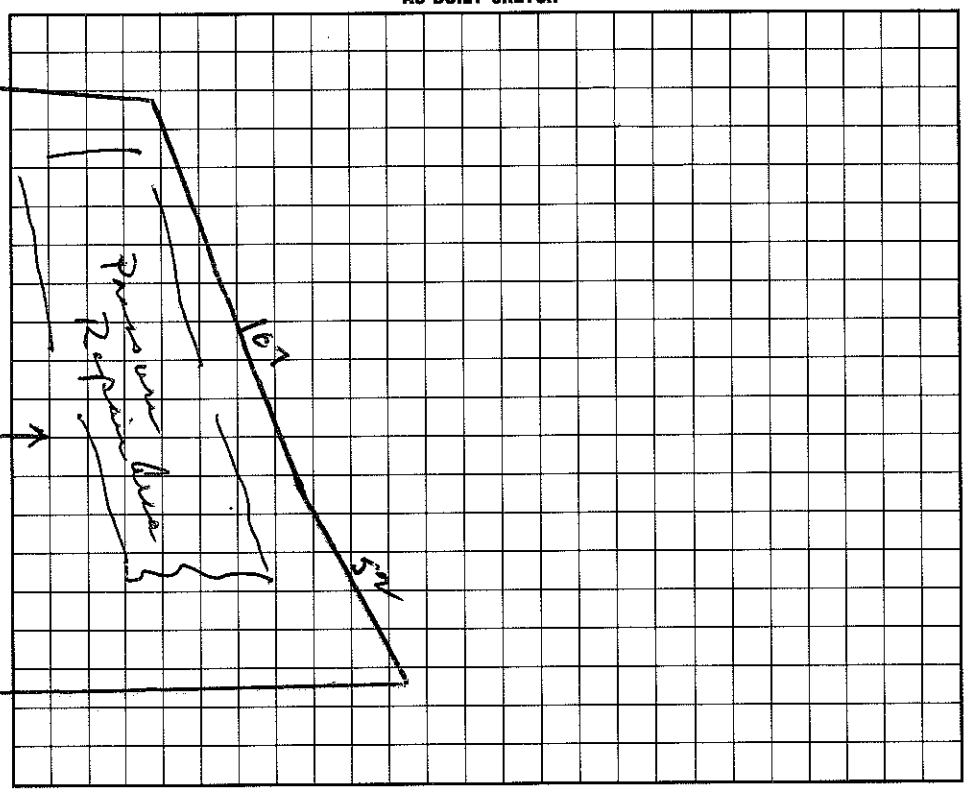

I understand that this permit can be suspended or revoked if any false information is supplied toward securing the permit/any unauthorized changes are made to the site/any unauthorized changes are made in the installation of the system. Improvement Permit is valid for 60 months from date of issuance.

Signed: X Julie A Wagner

Improvement Permit by: Wesley Spurlock R.S. date 5/8/98

Existing System Inspection by: Wesley Spurlock R.S. date 5/8/98

Installed by: RICHARD ABERNATHY

Certificate of Completion by: _____ date _____

Operation Permit by: C. [illegible] R.S. date 12/31/98

HEALTH DEPT. COPY: WHITE INSPECTION COPY (FINAL): GREEN OWNER COPY (FINAL): YELLOW INSPECTION COPY (INITIAL): PINK OWNER COPY (INITIAL): GOLD

IREDELL COUNTY HEALTH DEPARTMENT

Authorization to Construct

STATESVILLE 704-878-5305 MOORESVILLE 704-664-5281

IMPROVEMENT PERMIT / CERTIFICATE OF COMPLETION / OPERATION PERMIT / EXISTING SYSTEM INSPECTION

PROPERTY DESCRIPTION NO. Kapan DATE 3/8/96 TAX MAP NO. 20 1A 186 Watershed: ☒ Yes ☐ No

OWNER OR CONTRACTOR David Wagner PHONE: Business 343-3552 Home 664-1538

ADDRESS 587 Stonemarker West Mooresville, NC. 28115

LOCATION Dpaving Sub. TR Stonemarker, 1st (L) then (R) on West to 0587 on (R)

SUBDIVISION Stonemarker BLOCK / SECTION ____ LOT 9 LOT AREA Existing SITE CLASS. P.S DESIGN FLOW 480 L.T.A.R. .25

Septic Tank: 1500 Gallons; STB ____ Date ____

Pump Tank: ____ Gallons; PT ____ Date ____

Pump Make: ____ Model ____ Serial No. ____

Nitrification Field: No Fields ☒ 1 Square Feet 600 Linear Feet 200

No Lines 2 Trench Width 36" Max Trench Bottom Depth 36" Gravel Depth ____

☐ New System ☒ Repair System Type: I, (II), III, IV, V, VI

System Description: conv.

Repair System Description: ____

Maintenance Agreement Required: ☐ Yes ☒ No

☒ House/Mod. Home No. Bedrooms 4

☐ Mobile Home No. Bathrooms 3

☐ Business No. Employees ____

☐ Other ____

☐ Slab ☒ Crawl Space ☐ Basement w/plumbing ☐ Basement wo/plumbing


Water Supply: ☒ Individual ☐ Community ☐ Public

Comments: 2 Trench Lines - 100' each

Comments: 4 Drop boxes required - one per trench line

OK'd bottom repair line - 5/21/96 - Ams

INITIAL SITE SKETCH

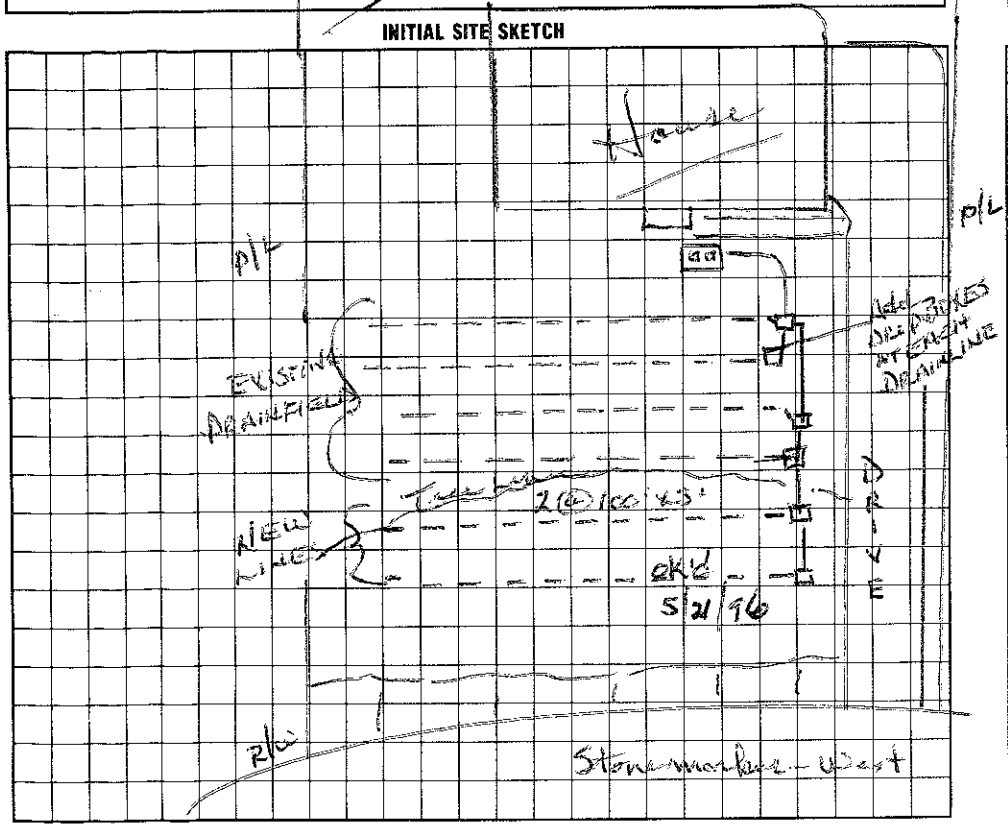

AS BUILT SKETCH

Same as initial site sketch

I understand that this permit can be suspended or revoked if any false information is supplied toward securing the permit/any unauthorized changes are made to the site/any unauthorized changes are made in the installation of the system.

Signed: ____

Improvement Permit by: ____ date ____

Inspection by: Environmental Health Specialist date 3/8/96

Installed by: Tim Ammons

Certificate of Completion by: [signature] date 5/20/96

Operation Permit by: [signature] date 5/20/96

HEALTH DEPT. COPY: WHITE INSPECTION COPY (FINAL): GREEN OWNER COPY (FINAL): YELLOW INSPECTION COPY (INITIAL): PINK OWNER COPY (INITIAL): GOLD