IREDELL COUNTY HEALTH DEPARTMENT

4615 908232

STATESVILLE 704-378-5305 MOORESVILLE 704-664-5281

IMPROVEMENT PERMIT / CERTIFICATE OF COMPLETION / OPERATION PERMIT / EXISTING SYSTEM INSPECTION

PROPERTY DESCRIPTION NO. 17221 DATE Oct. 25, '93 TAX MAP NO. 2D-1-A-185

OWNER OR CONTRACTOR David Brent Johnson PHONE: Business _____ Home _____

ADDRESS Rt 7, Box 810-D, Mooresville Watershed: ☑ Yes ☐ No L.N.

LOCATION 1100' TR 1236 Bear left then right on Stonemarker West ½ mile on Rt.

SUBDIVISION Stonemarker BLOCK / SECTION II LOT 8 LOT AREA ¾ Ac+ SITE CLASS. PS DESIGN FLOW 460gpd L.T.A.R. .4

Septic Tank: 1000 Gallons; STB 358 ACP Date 3-3-94

Pump Tank: _____ Gallons; PT _____ Date _____

Pump Make: _____ Model _____ Serial No. _____

Nitrification Field: No Fields 1 Square Feet 1200 Linear Feet 400

No Lines 4 Trench Width 36" Max Trench Bottom Depth 36" Gravel Depth 12"

☑ New System ☐ Repair System Type: I, II, III, IV, V, VI

System Description: gravity Conventional

Repair System Description: Same

Maintenance Agreement Required: ☐ Yes ☑ No

☑ House/Mod. Home No. Bedrooms 4

☐ Mobile Home No. Bathrooms 3½

☐ Business No. Employees ____

☐ Other _____


☐ Slab ☑ Crawl Space ☐ Basement w/plumbing ☐ Basement wo/plumbing

Water Supply: ☑ Individual ☐ Community ☐ Public


Comments: follow contour.

Comments:

INITIAL SITE SKETCH

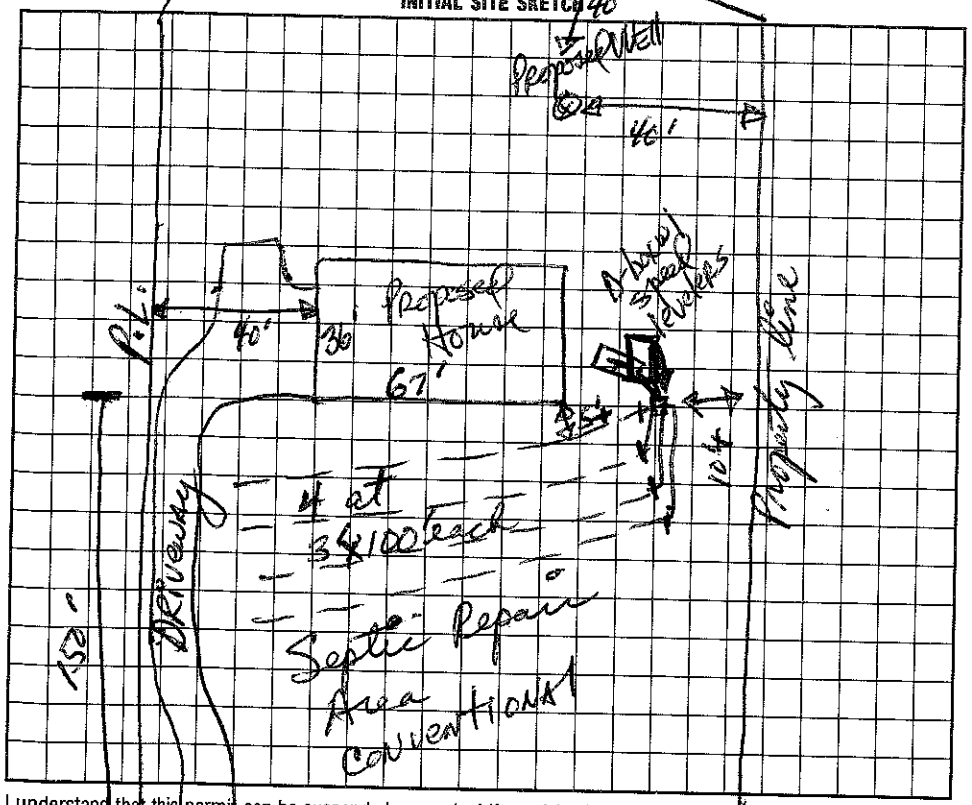

AS BUILT SKETCH

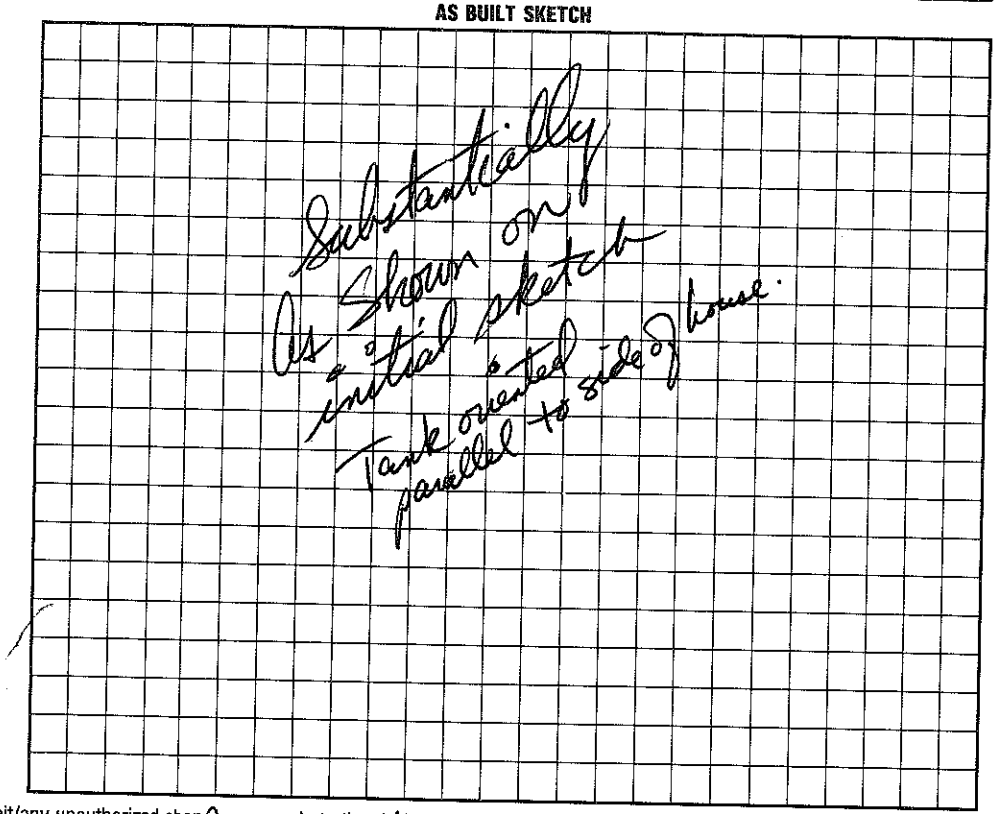

I understand that this permit can be suspended or revoked if any false information is supplied toward securing the permit/any unauthorized changes are made to the site/any unauthorized changes are made in the installation of the system. Improvement Permit is valid for 60 months from date of issuance. SR 1236

Signed: _____

Improvement Permit by: David R. Hanson, RS date 10/25/93

Existing System Inspection by: _____ date _____

Installed by: Richard Abernathy

Certificate of Completion by: David R. Hanson, RS date 4/19/94

Operation Permit by: _____ date _____

HEALTH DEPT. COPY: WHITE INSPECTION COPY (FINAL): GREEN OWNER COPY (FINAL): YELLOW INSPECTION COPY (INITIAL): PINK OWNER COPY (INITIAL): GOLD