BLDPERMIT # 89573

Paid 300.00 DT

IREDELL COUNTY HEALTH DEPARTMENT

STATESVILLE 704-878-5305 MOORESVILLE 704-664-5281

IMPROVEMENT PERMIT / AUTHORIZATION TO CONSTRUCT / OPERATION PERMIT / EXISTING SYSTEM INSPECTION

PERMIT# 25216 PIN# ~~2D-1-A-184~~ 4615909165 DATE 4-13-2000

OWNER OR CONTRACTOR Loring Homes (Bob Cashion) PHONE: Business Bob 370-7707 Home

ADDRESS

LOCATION Brawley School Rd TR Stonemarker TL Blarney TR Stonemarker lot on Rt ~ 6th lot on Rt

SUBDIVISION CL&T BLOCK / SECTION 6 LOT ~~184~~ LOT AREA .94 acre SITE CLASS. DESIGN FLOW L.T.A.R.

Septic Tank: 1000 Gallons; STB 3/2 Date 5/3/00

Pump Tank: 1600 Gallons; PT 29 Date 4/24/00

Pump Make: Goulds Model WE0-311M Serial No. S021944 77

Nitrification Field: No Fields 1 Square Feet 600' Linear Feet 200'

No Lines 4 at 50' Trench Width 36" Max Trench Bottom Depth 30"-34" Gravel Depth N/A

☒ New System ☐ Repair System Type: I, II, III, IV, V, VI

System Description: Pump (PM) Panel Blk. Well

Repair System Description: Same

Maintenance Agreement Required: ☐ Yes ☒ No

☒ House/Mod. Home No. Bedrooms 3

☐ Mobile Home No. Bathrooms 3

☐ Business No. Employees

☐ Other

☐ Slab ☐ Crawl Space ☒ Basement w/plumbing ☐ Basement wo/plumbing


Water Supply: ☒ Individual ☐ Public ☐ Community

Comments:/Conditions: Keep Septic System at least 10' from PL & 50' from any well. Keep Septic tank 15' side gradient of basement wall & drainfield 25' in gradient


Comments:/Conditions: Well must be at least 25' from house & 50' from any Septic System.

Scale 1:50

INITIAL SITE SKETCH

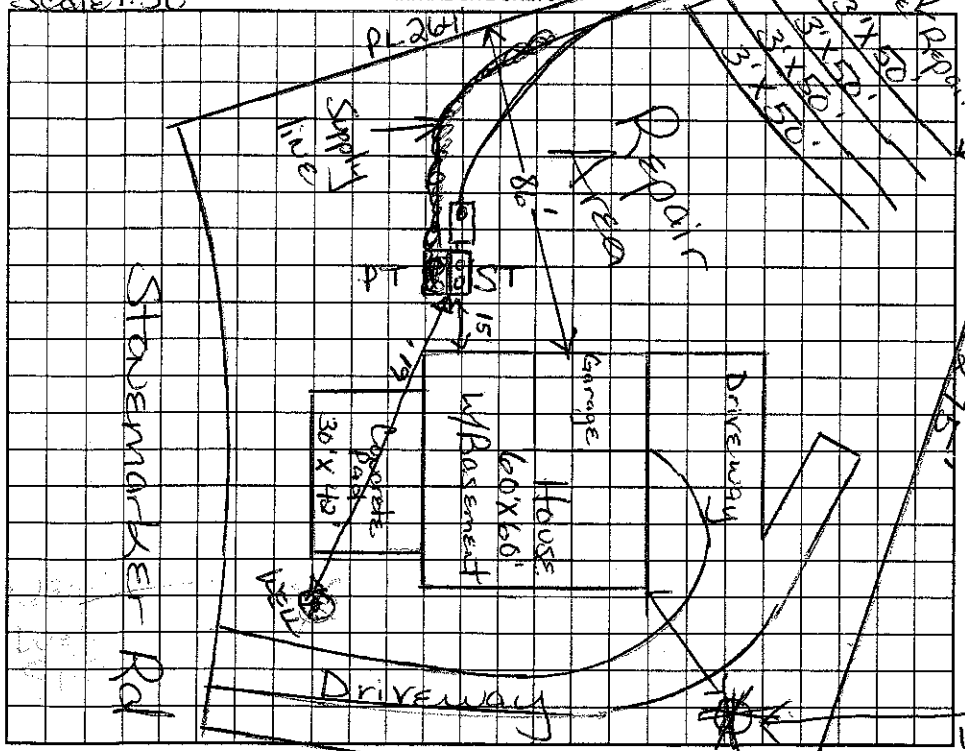

AS BUILT SKETCH

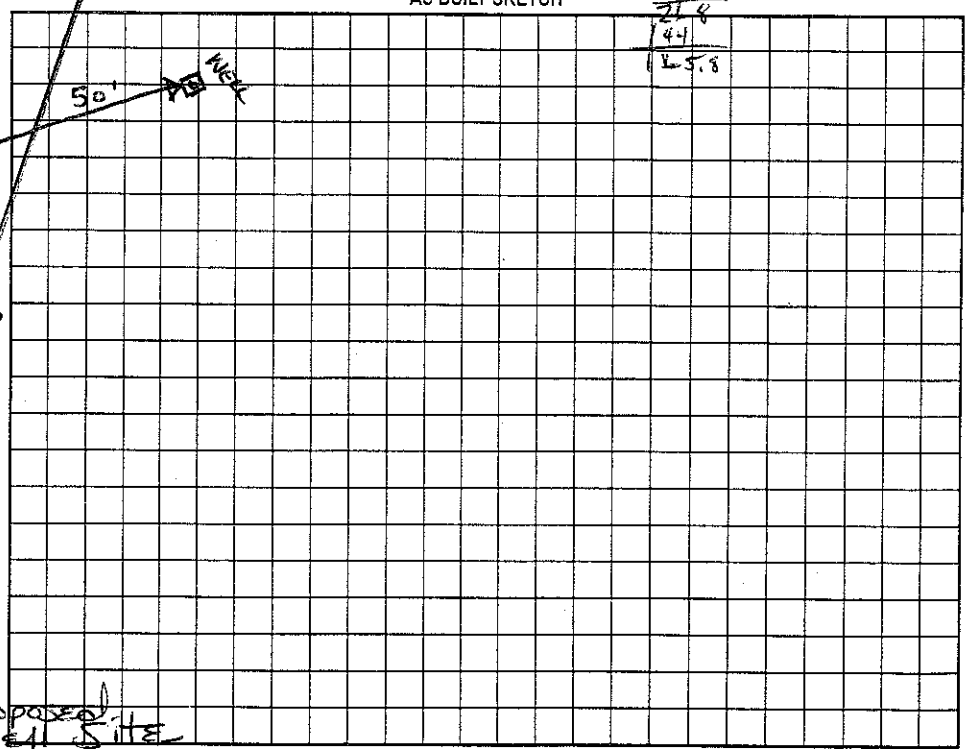

Permit can be suspended or revoked if any false information is supplied toward securing the permit/any unauthorized changes are made to the site/any unauthorized changes are made in the installation of the system. Improvement Permit with plat valid without expiration. Improvement Permit with site plan valid for sixty months. Authorization to Construct is valid for a period equal to that of Improvement Permit – not to exceed sixty months.

Signed: Jessica S. Wolfe date 4/18/00 Installed by: Bob McCarver

Improvement Permit by: Maria H. Dotson RS date 4/13/2000 Operation Permit by: Wesley Sparks RS. date 12/28/00

Authorization to Construct by: Maria H. Dotson RS date 4/13/2000 Existing System Inspection by: date

HEALTH DEPT. COPY: WHITE OWNER COPY (FINAL): YELLOW OWNER COPY (INITIAL): PINK