IREDELL COUNTY HEALTH DEPARTMENT

STATESVILLE 704-878-5305 MOORESVILLE 704-664-5281

Owns #50

IMPROVEMENT PERMIT / AUTHORIZATION TO CONSTRUCT / OPERATION PERMIT / EXISTING SYSTEM INSPECTION

PERMIT# 25068 PIN# 4615 90 9972 DATE 1/8/03

OWNER OR CONTRACTOR Jason Howard PHONE: Business 704-502-1463 Home 704-662-0897

ADDRESS 172 EASY ST. MOORESVILLE NC. 28117

LOCATION 1100 TR Stonemarker to 3rd lot on L past Clematis Pl.

SUBDIVISION Stonemarker BLOCK / SECTION 8 LOT 28 LOT AREA 1 AC SITE CLASS PS DESIGN FLOW 480 L.T.A.R. .3

Septic Tank: 1000 Gallons; STB 794 Date 1/10/03
Pump Tank: _____ Gallons; PT _____ Date _____
Pump Make: _____ Model _____ Serial No. _____
Nitrification Field: No Fields 1 Square Feet 540 Linear Feet 270
No Lines 6 Trench Width 2' Max Trench Bottom Depth 3' Gravel Depth NA

☒ New System ☐ Repair System Type: I, II, (III) IV, V, VI
System Description: GRAV - 16" PPBPS
Repair System Description: SAME TYPE
Maintenance Agreement Required: ☐ Yes ☒ No


☒ House/Mod. Home No. Bedrooms 4
☐ Mobile Home No. Bathrooms 3
☐ Business No. Employees ____
☐ Other _____
☐ Slab ☒ Crawl Space ☐ Basement w/plumbing ☐ Basement wo/plumbing

Water Supply: ☒ Individual ☐ Public ☐ Community


Comments:/Conditions:

Comments:/Conditions:

INITIAL SITE SKETCH

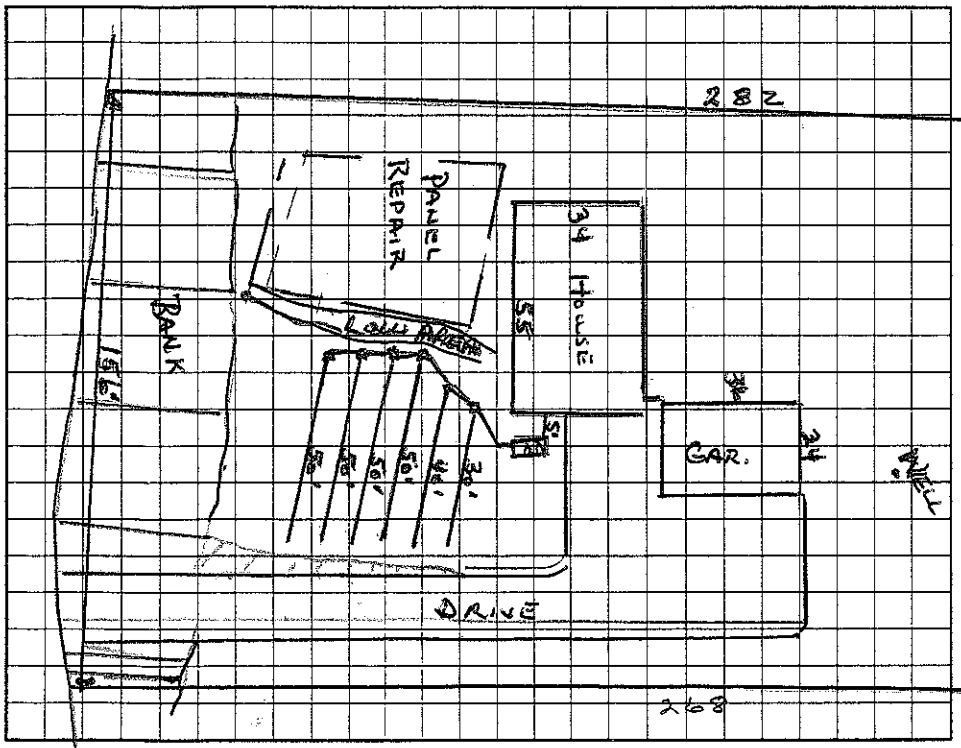

AS BUILT SKETCH

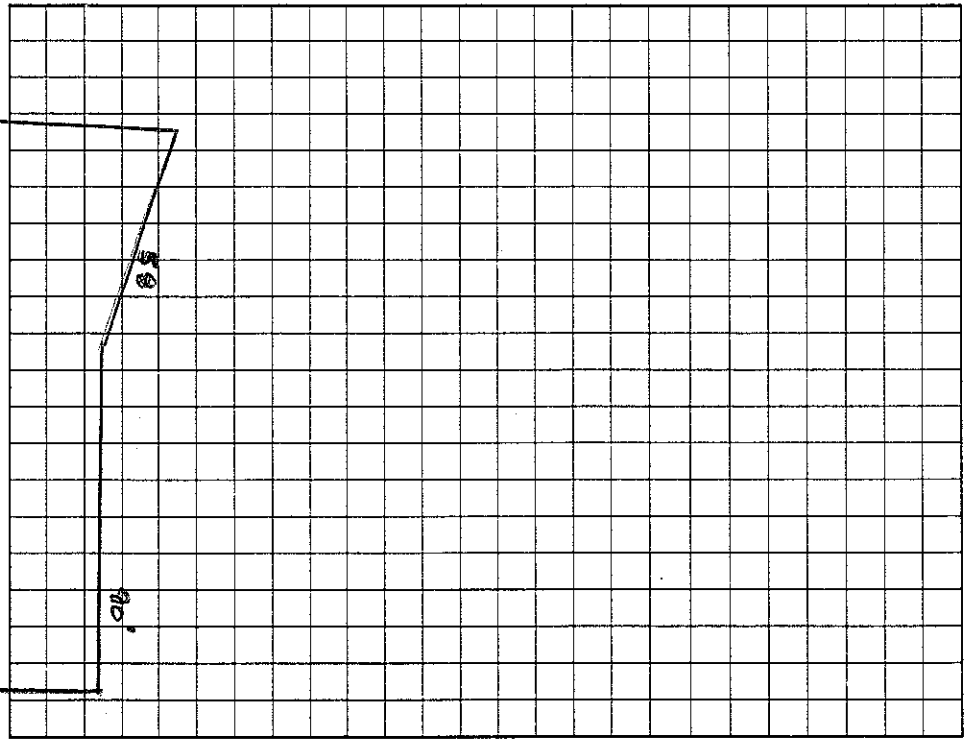

Permit can be suspended or revoked if any false information is supplied toward securing the permit/any unauthorized changes are made to the site/any unauthorized changes are made in the installation of the system. Improvement Permit with plan valid without expiration. Improvement Permit with site plan valid for sixty months. Authorization to Construct is valid for a period equal to that of Improvement Permit – not to exceed sixty months.

Signed: Carl Howard date _____

Improvement Permit by: Wesley Sparks RS. date 1/8/03

Authorization to Construct by: Wesley Sparks RS. date 1/8/03

Installed by: Todd Upright

Operation Permit by: Wesley Sparks RS date 3/28/03

Existing System Inspection by: _____ date _____

HEALTH DEPT. COPY: WHITE OWNER COPY (FINAL): YELLOW OWNER COPY (INITIAL): PINK