IREDELL COUNTY HEALTH DEPARTMENT - *ENVIRONMENTAL HEALTH* ☐ STATESVILLE OFFICE 704-878-5305 ☒ MOORESVILLE OFFICE 704-664-5281

IMPROVEMENT PERMIT / AUTHORIZATION TO CONSTRUCT / OPERATION PERMIT / EXISTING SYSTEM INSPECTION

PERMIT # 17755 PIN # 4615-91-0056 DATE 7-9-12

OWNER CAROLYN JUSTUS APPLICANT: MIKE ATHANAS PHONE: Home/Cell # 704-576-3887 Business #

SITE ADDRESS 448 STONEMARKER RD. OWNER / APPLICANT ADDRESS SAME

SITE DIRECTIONS RSR, TR STONEMARKER, ON R

SUBDIVISION CLET BLOCK / SECTION 6 LOT # 135 LOT AREA .68 AC DESIGN FLOW 480 GPD L.T.A.R. .3

Septic Tank 1000 Gallons: STB Date

Pump Tank 1000 Gallons: PT Date

Pump Make Model Serial #

No. Nitrification Fields: 1 No. Lines 5 Linear Feet 270'

Trench Width 24" Max. Trench Bottom Depth 36" Gravel Depth —

☒ New System ☐ Repair ☐ Expansion System Type I II III Ⓘ V VI

System Description: LP- PANEL BLOCK

Repair System Description: TS-II PANEL BLOCK

Maintenance Agreement Required ☒ YES ☐ NO

☐ GRAVITY ☒ PRESSURE

☒ Residence No. Bedrooms 4

☐ Business No. Persons

☐ Other No. Employees

☐ Slab ☐ Crawl Space

☒ Basement w/plumbing ☐ Basement w/o plumbing

Water Supply: ☒ Private ☐ Public ☐ Community


Comments / Conditions 2 EXISTING WELLS ON LOT
ANY PART OF PRESSURE LINE WITH IN 50' OF A WELL MUST BE CONSTRUCTED OF DUCTILE IRON PIPE.

NO BEDROOMS IN BASEMENT
Tanks checked 9-25-13, PT had no date on it, DO NOT ISSUE OP BEFORE 10-22-13 or ATLEAST 28 DAYS
*Septic lines checked 11-19-13 AP

INITIAL SITE SKETCH

SEE PLAN BY MIKE ATHANAS APPROVED BY ICHD

AS BUILT SKETCH

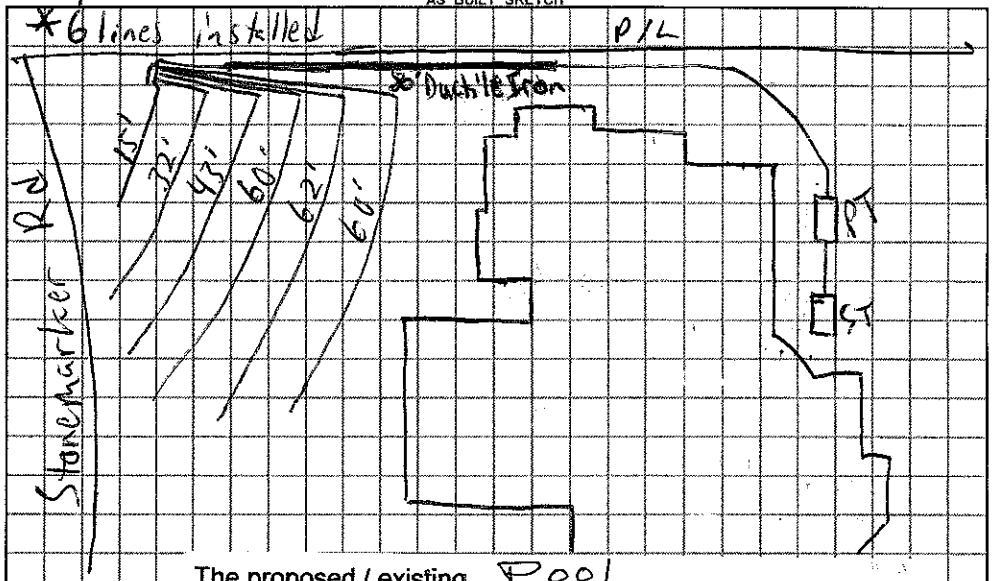

The proposed / existing Pool addition does not appear to impact the existing septic system.
**NOTE: See site Plan

Andy Melville R.S.
Date: 5-10-13
ICHD-Environmental Health Division

Permit can be suspended or revoked if any false information is supplied toward securing the permit / any unauthorized changes are made to the site / any unauthorized changes are made in the installation of the system.

☐ ***IMPROVEMENT PERMIT*** with plat valid without expiration. ☒ ***IMPROVEMENT PERMIT*** with plat valid without expiration. site plan valid 60 mo. ☐ ***AUTHORIZATION TO CONSTRUCT*** valid for period equal to IMPROVEMENT PERMIT--not to exceed 60 mo.

Owner / Applicant Signature: Date 7/16/12 Installed by: Piedmont Backhoe Service

IMPROVEMENT PERMIT by: REHS Date 7-9-12 OPERATION PERMIT by: REHS Date 2-17-14

AUTHORIZATION TO CONSTRUCT by: REHS Date 7-16-12 Existing System Inspected by: REHS Date

YOU SHOULD CONTACT A LOCATOR SERVICE PRIOR TO ANY EXCAVATION

White Copy – Environmental Health YELLOW COPY (Final) Owner / Applicant PINK COPY (Initial) Owner / Applicant