IREDELL COUNTY HEALTH DEPARTMENT ✓ Redraw ours ✓

STATESVILLE 704-878-5305 MOORESVILLE 704-664-5281

IMPROVEMENT PERMIT / AUTHORIZATION TO CONSTRUCT / OPERATION PERMIT / EXISTING SYSTEM INSPECTION

PERMIT # 145204 PIN # 4615910464.000 DATE 11/5/08

OWNER or APPLICANT Dave Walters PHONE: Business 336-978-8812 Home:

OWNER or APPLICANT ADDRESS 178 Mallard Glen Winston Salem NC

LOCATION / DIRECTIONS Brenda, Schl Rd. TR Stonemarker Rd, ≈ 1 mile on Right

SUBDIVISION CLOT BLOCK / SECTION 6 LOT # 132 LOT AREA 31,000 DESIGN FLOW 480 L.T.A.R. .275

Septic Tank 1000 Gallons: STB 312 Date 3/12/09
Pump Tank 1000 Gallons: PT 27 Date 7/16/09
Pump Make Orenco Model VEOZ12-HV Serial # S0071047
Nitrification Field No Fields 1 No Lines 5 Linear Feet 290
Trench Width 24" & 8'cc Max. Trench Bottom Depth 36" Gravel Depth N/A

☑ New System ☐ Repair ☐ Expansion System Type I II III IV V VI
System Description: LPP PBPS
Repair System Description: same
Maintenance Agreement Required ☑ YES ☐ NO
☐ GRAVITY ☑ PRESSURE


☑ Residence No. Bedrooms 4
☐ Business No. Persons
☐ Other No. Employees
☐ Slab ☐ Crawl Space
☑ Basement w/plumbing ☐ Basement w/o plumbing

Water Supply: ☑ Private ☐ Public ☐ Community


Comments / Conditions Maintain 50' min from Septic system + repair from all wells
*Pre-1977 Lot stay 5' min from all property lines

Comments / Conditions * 25' min from Cut of basement up slope from drainfield. - 15' min from Side slope from System + Tanks.
* System + repair min 15' from cut of pool.

INITIAL SITE SKETCH 1"=40'

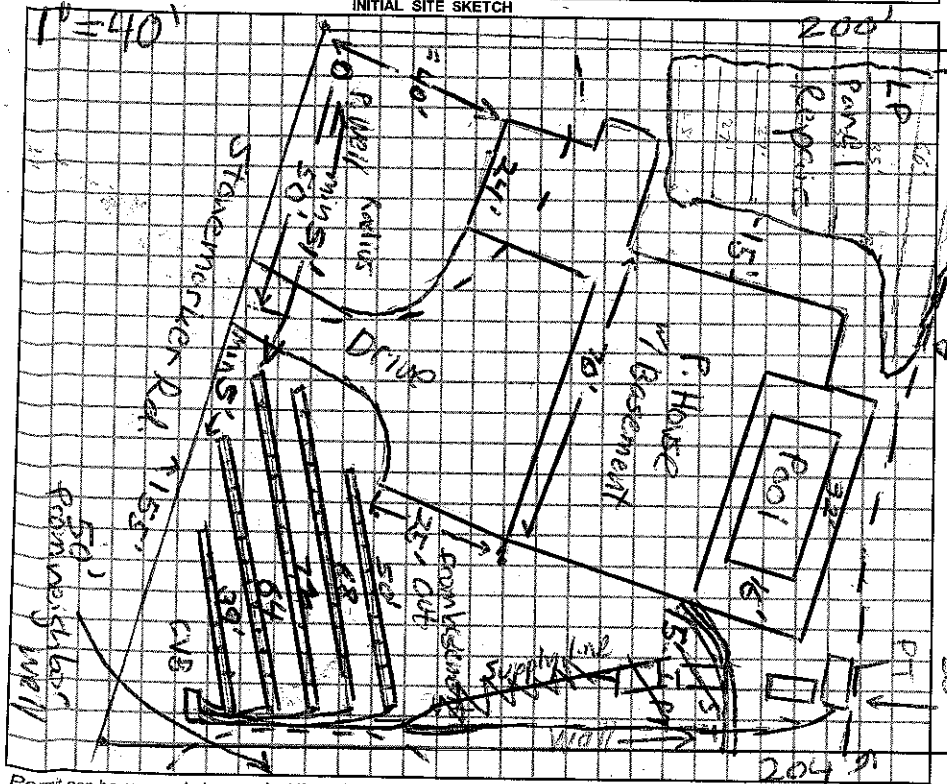

AS BUILT SKETCH

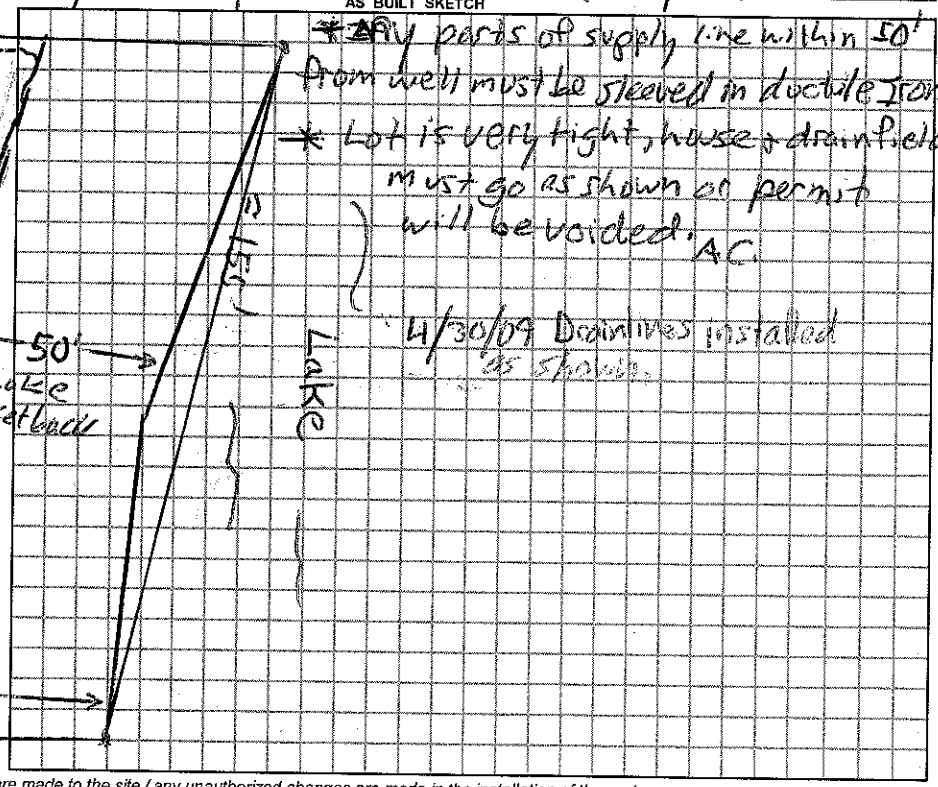

Permit can be suspended or revoked if any false information is supplied toward securing the permit / any unauthorized changes are made to the site / any unauthorized changes are made in the installation of the system.

☐ IMPROVEMENT PERMIT w / plat valid without expiration. ☑ IMPROVEMENT PERMIT w / site plan valid for 60 mos. ☑ AUTHORIZATION TO CONSTRUCT valid for period equal to IMPROVEMENT PERMIT-not to exceed 60 mo.

Owner / Applicant Signature: Carol Walters Date

Improvement Permit by: Anthony Coker R.S. Date 11/5/08

Authorization to Construct by: Anthony Coker R.S. Date 11/5/08

YOU SHOULD CONTACT A LOCATOR SERVICE PRIOR TO ANY EXCAVATION.

Installed by: FJ ERVIN

Operation Permit by: Anthony Coker R.S. Date: 7/20/09

Existing System Inspected by: Date:

WHITE COPY Environmental Health YELLOW COPY (Final) Owner / Applicant PINK COPY (Initial) Owner / Applicant