IREDELL COUNTY HEALTH DEPARTMENT

STATESVILLE 704-878-5305 / 130.00 Paid MOORESVILLE 704-664-5281

IMPROVEMENT PERMIT / AUTHORIZATION TO CONSTRUCT / OPERATION PERMIT / EXISTING SYSTEM INSPECTION

PERMIT# 112 226 PIN# 4615-91-1527 DATE 6/2/03

OWNER OR CONTRACTOR Jay Smith PHONE: Business 704-202-9461 Home

ADDRESS 141 Springwood Rd. Mooresville, NC. 28117 (429 Stonemarker Rd.)

LOCATION 1100 TR Stonemarker Rd straight, on (R) past Fourth Ln. 428 Stonemarker Rd.

SUBDIVISION CL+T BLOCK / SECTION 6 LOT 131 LOT AREA ~.75 AC SITE CLASS. PS DESIGN FLOW 480 L.T.A.R. .3

Septic Tank: 1000 Gallons; STB 1012 Date 10/22/02

Pump Tank: Gallons; PT Date

Pump Make: Model Serial No.

Nitrification Field: No Fields 1 Square Feet 536 * Linear Feet 268 *

No Lines 4@67' Trench Width 2-3' Max Trench Bottom Depth 36" Gravel Depth No

[X] New System [ ] Repair System Type: I, II, (III) IV, V, VI

System Description: GRAVITY - 16" PABS

Repair System Description: SAME TYPE

Maintenance Agreement Required: [ ] Yes [X] No

[X] House/Mod. Home No. Bedrooms 4

[ ] Mobile Home No. Bathrooms 3

[ ] Business No. Employees

[ ] Other


[ ] Slab [ ] Crawl Space [X] Basement w/plumbing [ ] Basement wo/plumbing

Water Supply: [X] Individual [ ] Public [ ] Community


Comments/Conditions: LINES TO FOLLOW SLOPE CONTOUR ATTEMPTING TO LEAVE ROOM FOR REPAIR AREA AND FUTURE HOME LOCATION.

Comments/Conditions: Deep Basement - 8' centers 16" PABS Installed.

INITIAL SITE SKETCH

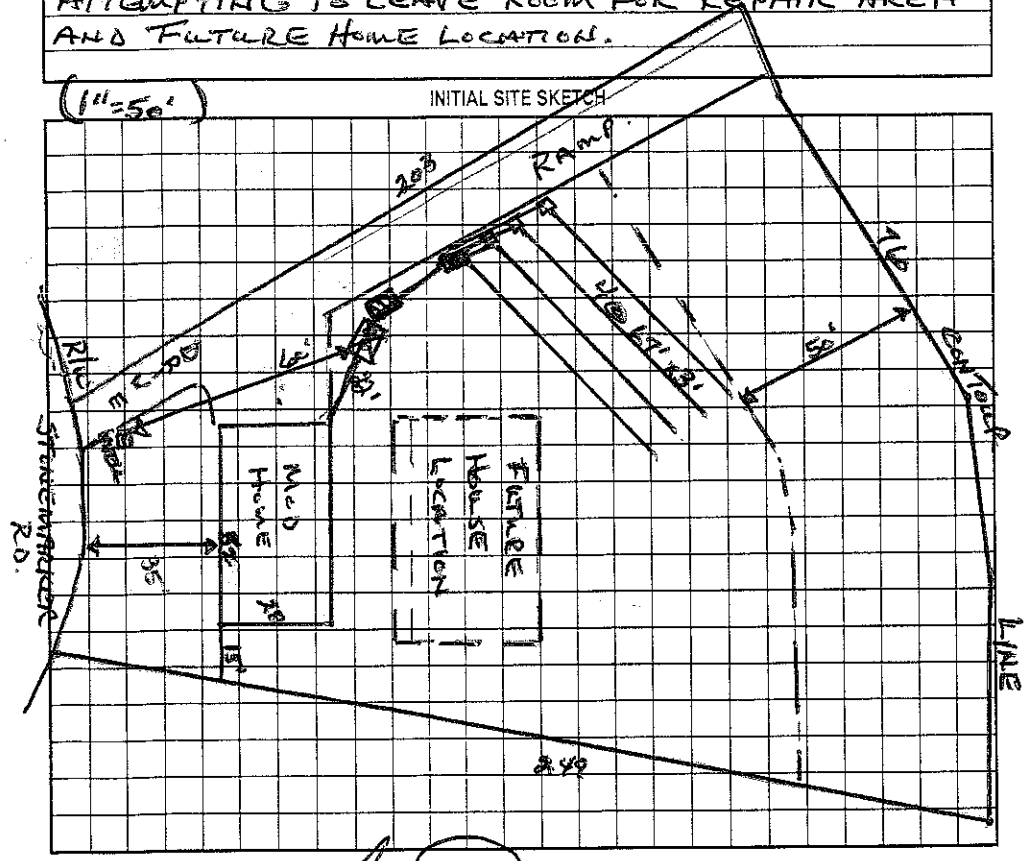

AS BUILT SKETCH

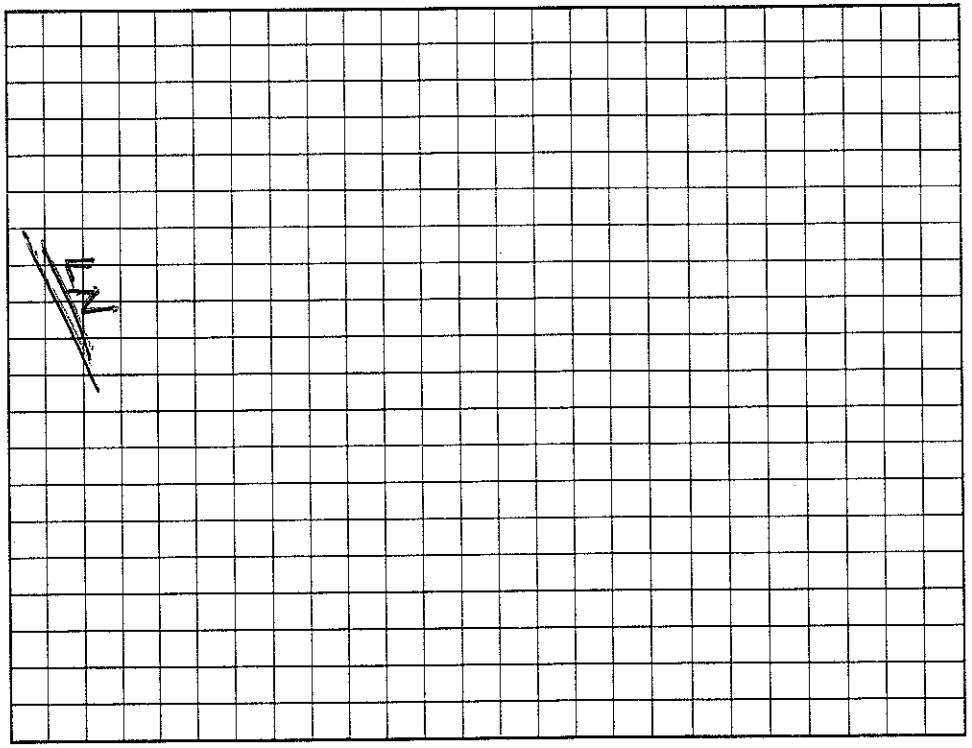

Permit can be suspended or revoked if any false information is supplied toward securing the permit/any unauthorized changes are made to the site/any unauthorized changes are made in the installation of the system. Improvement Permit with plat valid without expiration. Improvement Permit with site plan valid for sixty months. Authorization to Construct is valid for a period equal to that of Improvement Permit – not to exceed sixty months.

Signed: [signature] date 6-3-03 Installed by: A-1 Backhoe

Improvement Permit by: Wesley Sparks R.S. date 6/2/03 Operation Permit by: Wesley Sparks R.S. date 6/13/03

Authorization to Construct by: Wesley Sparks R.S. date 6/2/03 Existing System Inspection by: date

HEALTH DEPT. COPY: WHITE OWNER COPY (FINAL): YELLOW OWNER COPY (INITIAL): PINK