IREDELL COUNTY HEALTH DEPARTMENT

STATESVILLE 704-878-5305 MOORESVILLE 704-664-5281

IMPROVEMENT PERMIT / AUTHORIZATION TO CONSTRUCT / OPERATION PERMIT / EXISTING SYSTEM INSPECTION

PERMIT# 133874 PIN# 4615 91 1527 . 000 DATE 2/24/06

OWNER OR APPLICANT Guy Smith PHONE: Business 704-662-8467 Home

ADDRESS 428 Stonemarker Rd. Mooresville, NC. 28117

LOCATION 1100 TR Stonemarker Rd. straight to # 428 on (R) side of road

SUBDIVISION CL + T BLOCK / SECTION 6 LOT 131 LOT AREA ~.75 SITE CLASS. PS DESIGN FLOW 480 L.T.A.R. .3

Septic Tank: EXISTING Gallons; STB ____ Date ____

Pump Tank: ____ Gallons; PT ____ Date ____

Pump Make: ____ Model ____ Serial No. ____

Nitrification Field: No Fields ____ Square Feet 536 Linear Feet 268

No Lines ____ Trench Width ____ Existing System Max Trench Bottom Depth ____ Gravel Depth ____

☐ New System ☐ Repair ☐ Expansion System Type: I II (III) IV V VI

System Description: ____

Repair System Description: EXISTING

Maintenance Agreement Required: ☐ Yes ☒ No

☒ Gravity ☐ Pressure ☐ Slab ☐ Crawl Space ☒ Basement w/plumbing ☐ Basement wo/plumbing

☒ House/Mod. Home ☐ Mobile Home ☐ Business ☐ Other ____


No. Bedrooms 4 No. Persons 4 No. Employees ____

Water Supply: ☒ Individual ☐ Public ☐ Community

Comments:/Conditions:

Comments:/Conditions:

A.S BUILT SKETCH ~~INITIAL SITE SKETCH~~

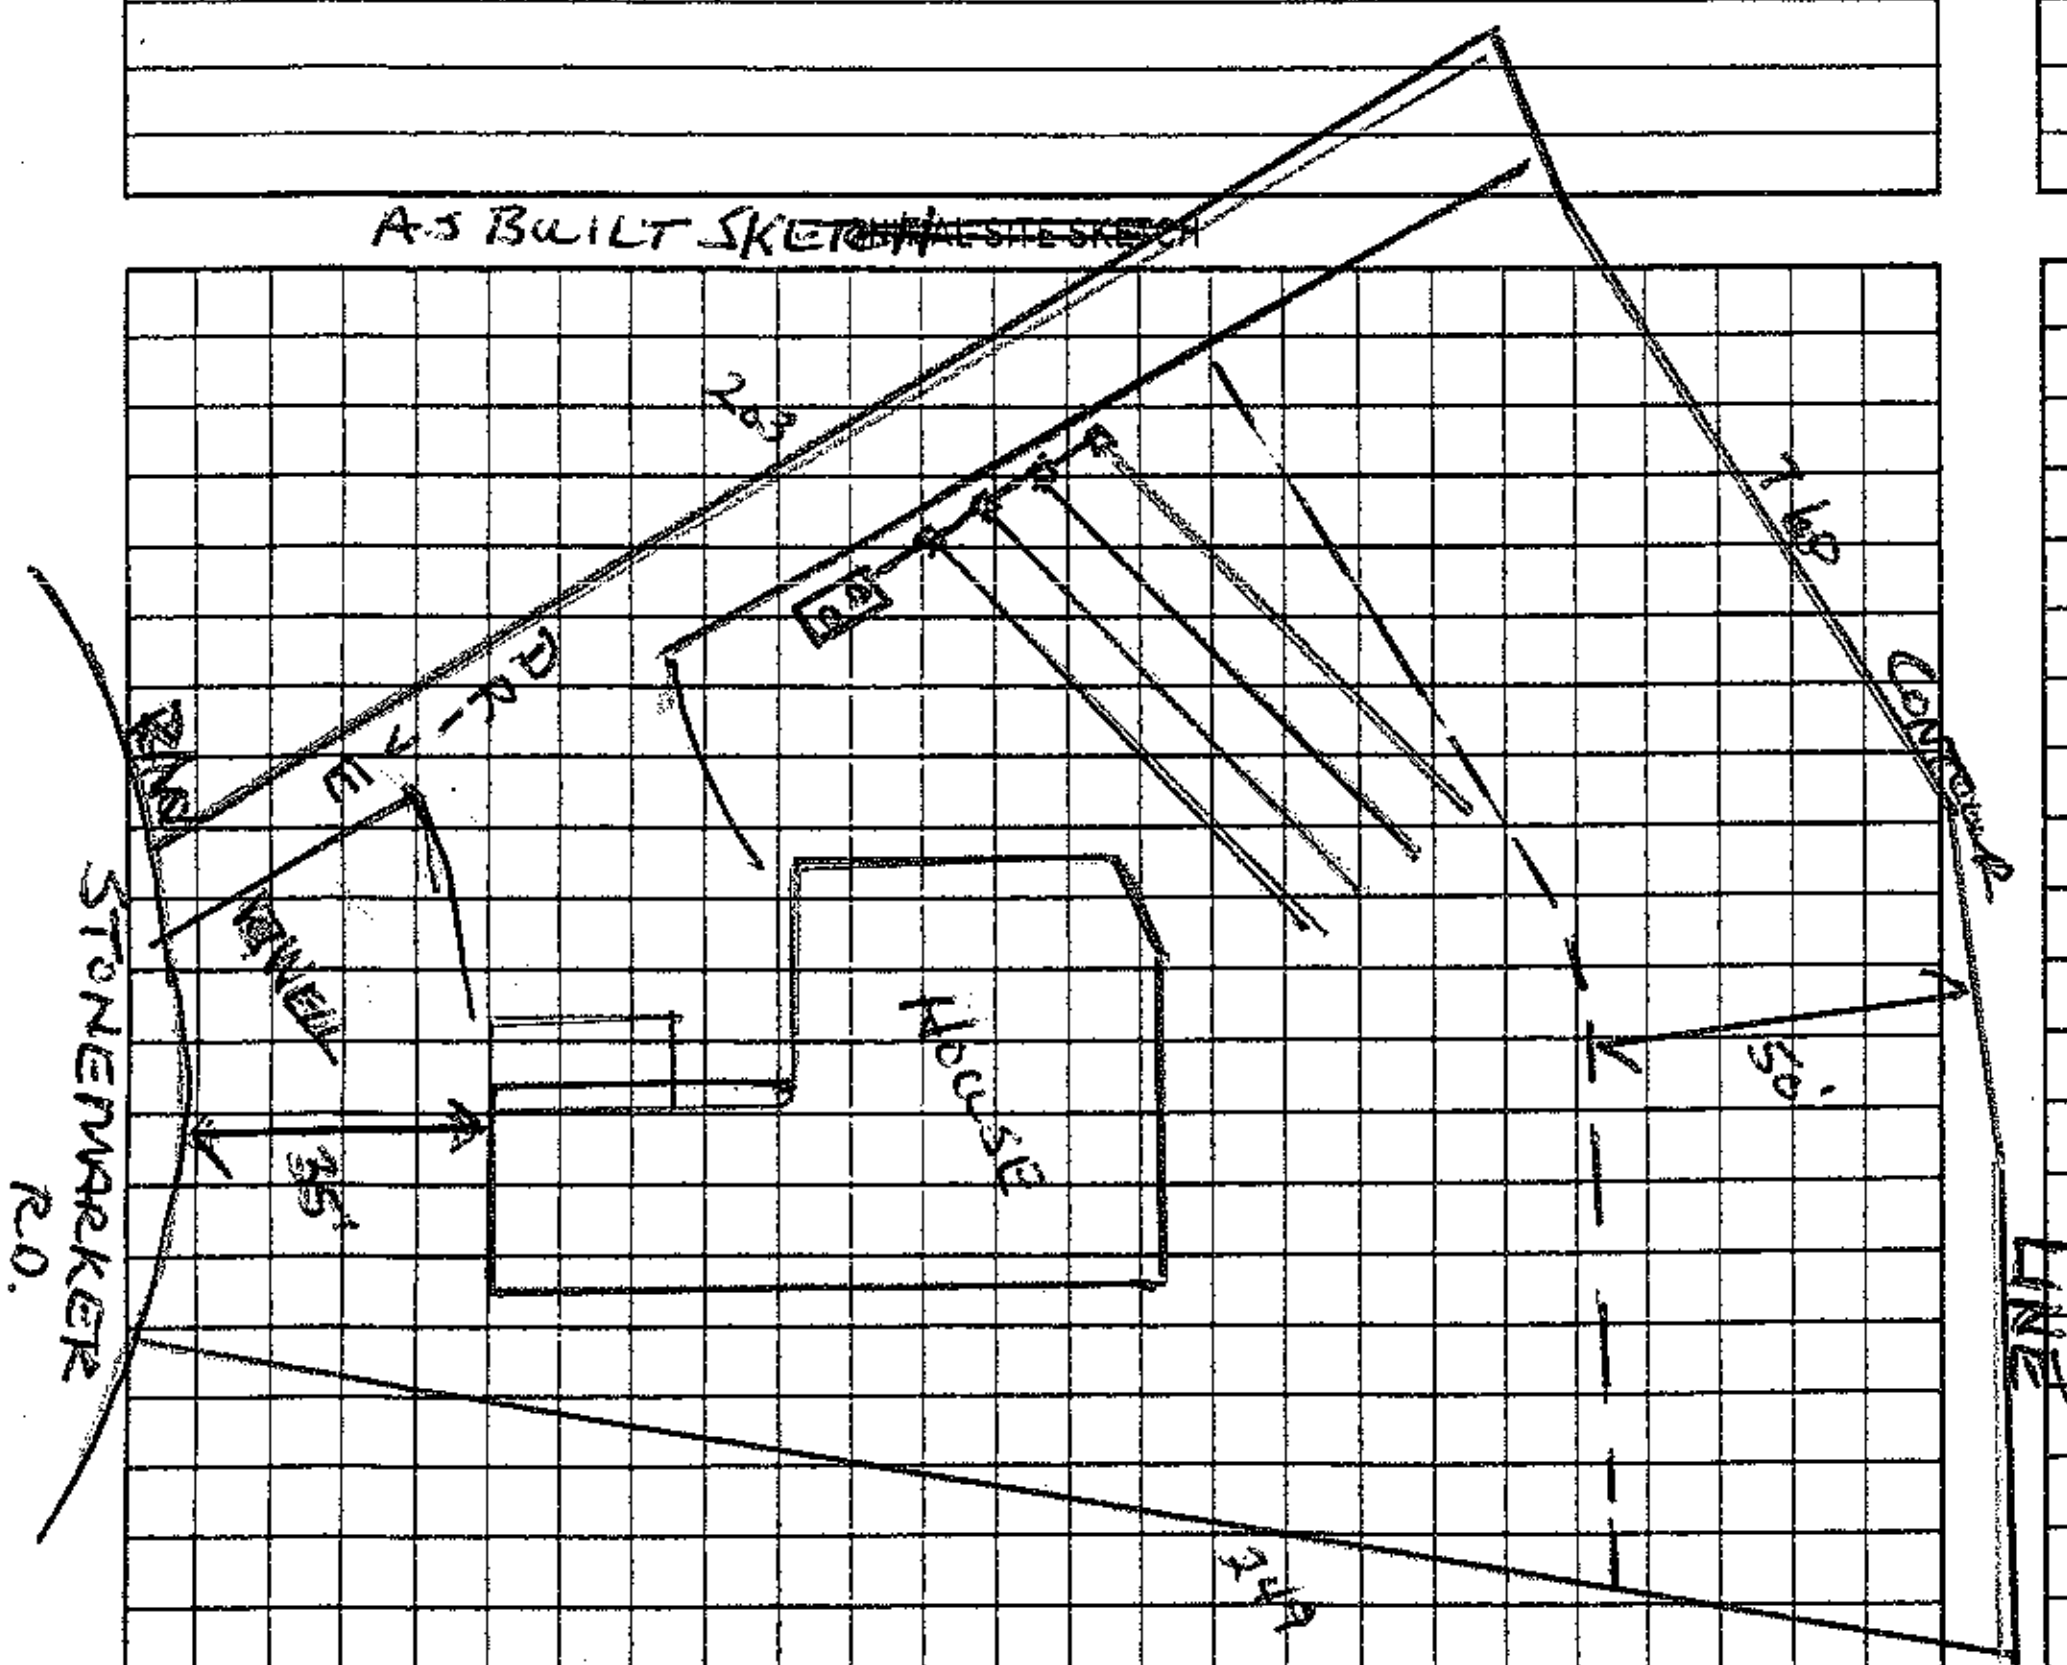

AS BUILT SKETCH

Permit can be suspended or revoked if any false information is supplied toward securing the permit/any unauthorized changes are made to the site/any unauthorized changes are made in the installation of the system. Improvement Permit with plat valid without expiration ☐ Improvement Permit with site plan valid for sixty months ☐ Authorization to Construct is valid for a period equal to that of Improvement Permit – not to exceed sixty months.

Signed: [signature] date 2/27/01

Improvement Permit by: ____ date ____

Authorization to Construct by: ____ date ____

Installed by: A-1 Backhoe

Operation Permit by: ____ date ____

Existing System Inspection by: Wesley Sparks RS date 2/24/06

HEALTH DEPT. COPY: WHITE OWNER COPY (FINAL): YELLOW OWNER COPY (INITIAL): PINK

IREDELL COUNTY HEALTH DEPARTMENT

STATESVILLE 704-878-5305 MOORESVILLE 704-664-5281

IMPROVEMENT PERMIT / AUTHORIZATION TO CONSTRUCT / OPERATION PERMIT / EXISTING SYSTEM INSPECTION

PERMIT# 106862 PIN# 4615911527 DATE 6/27/2002

OWNER OR CONTRACTOR Paul Norris (Jeff Hines) PHONE: Business 806-5134 Home

ADDRESS 428 Stonemarker Dr. Mooresville NC 28117

LOCATION Brawley School Rd TR Stonemarker on right just past Fawn Ln

SUBDIVISION CLAY TY BLOCK / SECTION 6 LOT 131 LOT AREA .75 Acre SITE CLASS. (V) DESIGN FLOW 360gpd L.T.A.R.

Septic Tank: 1000 Gallons; STB Date

Pump Tank: Existing Gallons; PT Date

Pump Make: Model Serial No.

Nitrification Field: No Fields Square Feet Linear Feet 225'

No Lines Bed Trench Width Existing Max Trench Bottom Depth Gravel Depth

☐ New System ☐ Repair System Type: I, II, III, IV, V, VI (V)

System Description: Existing Gravity Conventional

Repair System Description:

Maintenance Agreement Required: ☐ Yes ☒ No

☒ House/Mod. Home No. Bedrooms 3

☐ Mobile Home No. Bathrooms 2

☐ Business No. Employees

☐ Other


☐ Slab ☒ Crawl Space ☐ Basement w/plumbing ☐ Basement wo/plumbing

Water Supply: ☒ Individual ☐ Public ☐ Community

Comments/Conditions: Existing Septic System appears to be functioning okay at time of inspection

Comments/Conditions: Note: part of Drainfield may be covered by Boat ramp, no problems noticed Septic System originally installed 1969

INITIAL SITE SKETCH

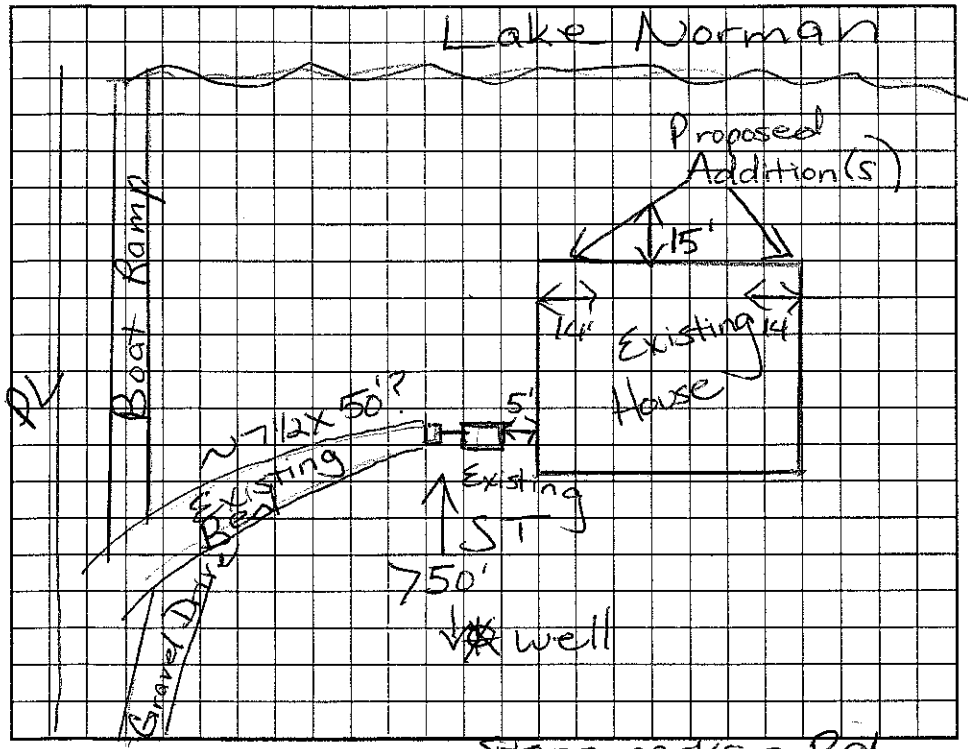

AS BUILT SKETCH

Owner — Darby

Permit can be suspended or revoked if any false information is supplied toward securing the permit/any unauthorized changes are made to the site/any unauthorized changes are made in the installation of the system. Improvement Permit with plat valid without expiration. Improvement Permit with site plan valid for sixty months. Authorization to Construct is valid for a period equal to that of Improvement Permit – not to exceed sixty months.

Signed: date Installed by:

Improvement Permit by: Maria H. Lopez RS date 6/27/2002 Operation Permit by: date

Authorization to Construct by: date Existing System Inspection by: Maria H. Lopez RS date 6/27/2002

HEALTH DEPT. COPY: WHITE OWNER COPY (FINAL): YELLOW OWNER COPY (INITIAL): PINK