4615915679

IREDELL COUNTY HEALTH DEPARTMENT

Statesville Phone TR 3-7271 Mooresville Phone NO 3-1271

PERMIT TO INSTALL SEPTIC TANK

Permit No. _____ Permit Date Dec 6 1968

Owner [illegible] Lawing Address [illegible]

Installed By [illegible] Address [illegible]

Location of Property Lot 127 Sec 6 CL+T


Site Address: 109 Fawn Lane - Mrsvl.

Tank		Capacity		Length of Lines		Fixtures	
Block	( )	1000	( )	225'	( )	No. of Baths	( )
Precast	(✓)	1250	( )	250'	( )	Dishwasher	( )
		1500	( )	Other		Garbage Grdr.	( )
		Other				Other	

NOTIFY HEALTH DEPARTMENT AT LEAST EIGHT HOURS BEFORE TANK IS TO BE INSPECTED.

Final Inspection 6 Dec. 1968 Approved (✓) Disapproved ( )

Remarks Well not Done

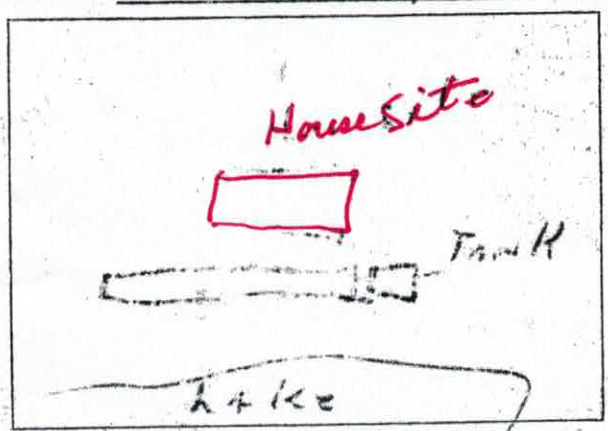

Sketch of Installation

[illegible]

Sanitarian