9130

IREDELL COUNTY HEALTH DEPARTMENT

STATESVILLE 704-878-5305 MOORESVILLE 704-664-5281

IMPROVEMENT PERMIT / AUTHORIZATION TO CONSTRUCT / OPERATION PERMIT / EXISTING SYSTEM INSPECTION

PERMIT # NO PIN # 4615 91 8634 DATE 7/16/09

OWNER or APPLICANT LAZAR KAY PHONE: Business 704-402-7551 Home: 704-663-0702

OWNER or APPLICANT ADDRESS 398 STONEMARKER RD. MOORESVILLE, NC. 28117

LOCATION / DIRECTIONS 1100 TR STONEMARKER STRAIGHT PAST BLARNEY, ON R. BEFORE FAWN LN.

SUBDIVISION CL+T BLOCK / SECTION 6 LOT # 104 LOT AREA ~1.23 DESIGN FLOW 240 L.T.A.R. .3

Septic Tank 1000 Gallons: STB 2-1-2 Date 7-23-08 ☐ New System ☒ Repair ☐ Expansion System Type I II (III) IV V VI

Pump Tank 1000 Gallons: P T 2-1 Date 5-4-09 System Description: PM – 25% REDUCTION

Pump Make Gould Model WE0311M Serial # Repair System Description:

Nitrification Field No Fields 1 No Lines 2 Linear Feet 200 Maintenance Agreement Required ☐ YES ☒ NO

Trench Width 3' Max. Trench Bottom Depth 3' Gravel Depth No ☐ GRAVITY ☒ PRESSURE


☒ Residence No. Bedrooms 2 ☐ Business No. Persons ☐ Other No. Employees ☐ Slab ☒ Crawl Space ☐ Basement w/plumbing ☐ Basement w/o plumbing

Water Supply ☒ Private ☐ Public ☐ Community

Comments / Conditions SEPTIC TANK MAY BE USEABLE IF IT HAS BAFFLE WALL AND SANITARY TEE?

Comments / Conditions 8/14/09 Tanks, lines & pressure (2#)

INITIAL SITE SKETCH

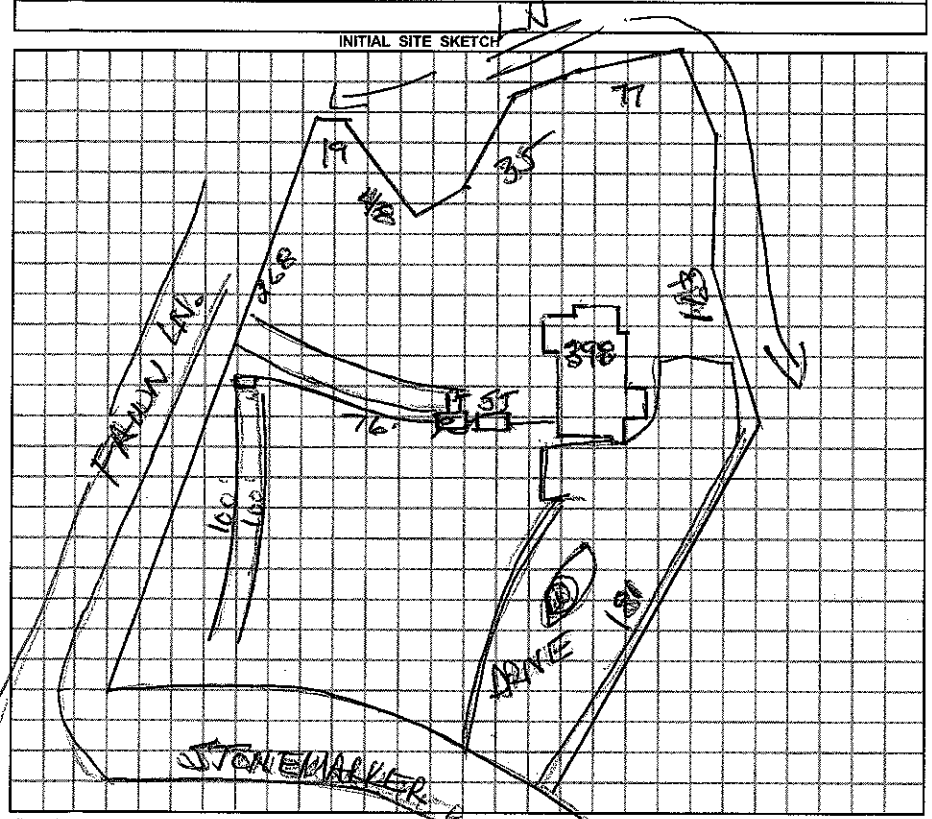

AS BUILT SKETCH

Installed essentially as Drawn
Used Quick 4
Grading not complete @ time of inspection

Permit can be suspended or revoked if any false information is supplied toward securing the permit / any unauthorized changes are made to the site / any unauthorized changes are made in the installation of the system.

☐ *IMPROVEMENT PERMIT w / plat valid without expiration.* ☐ *IMPROVEMENT PERMIT w / site plan valid for 60 mos.* ☒ *AUTHORIZATION TO CONSTRUCT valid for period equal to IMPROVEMENT PERMIT-not to exceed 60 mo.*

Owner / Applicant Signature: Lazar Kay Date 7/20/09

Improvement Permit by: Wesley Starnes RS. Date 7/16/09

Authorization to Construct by: Wesley Starnes RS. Date 7/16/09

Installed by: C Wayne Orison

Operation Permit by: Wesley Starnes RS. Date: 8/18/09

Existing System Inspected by: Date:

YOU SHOULD CONTACT A LOCATOR SERVICE PRIOR TO ANY EXCAVATION.

WHITE COPY Environmental Health YELLOW COPY (Final) Owner / Applicant PINK COPY (Initial) Owner / Applicant