IREDELL COUNTY HEALTH DEPARTMENT

Statesville Phone TR 3-7271 Mooresville Phone NO 3-1271

PERMIT TO INSTALL SEPTIC TANK

Permit No. 10 Permit Date 2-4 1972

Owner WRIGHT IRRIGATION Co Address 1014 RONALD ST CHARLOTTE, N C

Installed By Orbison Address MOORESVILLE

Location of Property


LOT # 103 - SECTION # 6

Tank		Capacity		Length of Lines		Fixtures	
Block	( )	1000	(✓)	225'	(✓)	No. of Baths	(1)
Precast	(✓)	1250	( )	250'	( )	Dishwasher	( )
		1500	( )	Other		Garbage Grdr.	( )
		Other				Other	

NOTIFY HEALTH DEPARTMENT AT LEAST EIGHT HOURS BEFORE TANK IS TO BE INSPECTED.

Final Inspection 2-4 1972 Approved (✓) Disapproved ( )

Remarks No well on property at time of insp.

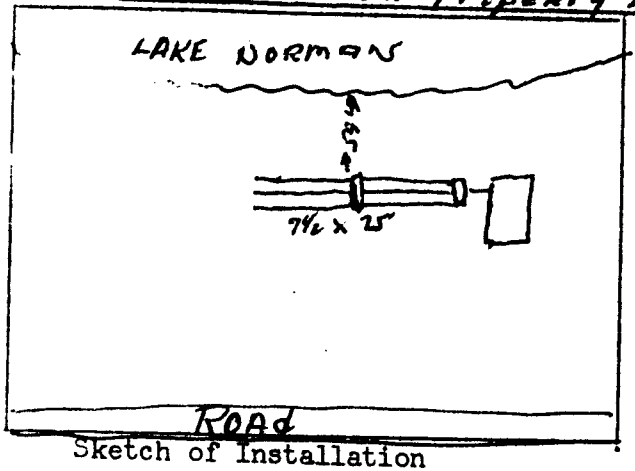

Sketch of Installation

Sanitarian