IREDELL COUNTY HEALTH DEPARTMENT

Statesville Office (704) 878-5305 Mooresville Office (704) 660-3625 PERMIT # 219841

IMPROVEMENT PERMIT / AUTHORIZATION TO CONSTRUCT / OPERATION PERMIT / EXISTING SYSTEM

PIN # 4615 92 0685

APPLICANT: Rollans Soil / Burton Melton APPLICANT ADDRESS: P.O. Box 832 Mooresville, NC 28117

SITE ADDRESS: 112 Stone Point Ct Mooresville, NC 28117 PHONE: 704 746-5046 ALT. PHONE: 704 799-0340

SITE DIRECTIONS: Brawley School Rd TR Stone marker TR Fawn Ln TR, Stone Point Ct on right

SUBDIVISION: Stonemarker Pointe SECTION: — LOT # 3 LOT AREA: DESIGN FLOW: 480 gpd L.T.A.R.: .3

Septic Tank Exist 1000 (gal) STB Date
Pump Tank Exist 1000 (gal) PT Date
Pump Make Model Serial #
Nitrification Fields 1 # Lines 3 Linear Ft: 61
Trench Width min 24" Max. Trench Bottom Depth 30" Gravel Depth N/A

☐ New System ☐ Repair ☒ Expansion System Type: I II III (IV) V VI
System Description: LPPPBPS
Repair System Description: LPPPBPS
Maintenance Agreement Required: ☒ YES ☐ NO
☐ GRAVITY ☒ PRESSURE

☒ Residence No. Bedrooms 4
☐ Business No. Persons 8
☐ Other No. Employees
☐ Slab ☐ Crawl Space
☒ Basement w/plumbing ☐ Basement w/o plumbing

Water Supply: ☒ Private ☐ Public ☐ Community

Comments / Conditions: *

INITIAL SITE SKETCH

See attached, approved plan by Rollans Soil & Environmental Services, PA (dated 6/24/16)

AS BUILT SKETCH

Checked Lines, New CUB 8-2-16 BA
Set 2' PH
Using Existing Pump > 8-4-16 BA
Checked Alarm
Checked Breakers 8-12-16 BA

Permit can be suspended or revoked if any false information is supplied toward securing the permit / any unauthorized changes are made to the site / any unauthorized changes are made in the installation of the system. **CONTACT A LOCATOR SERVICE PRIOR TO ANY EXCAVATION**

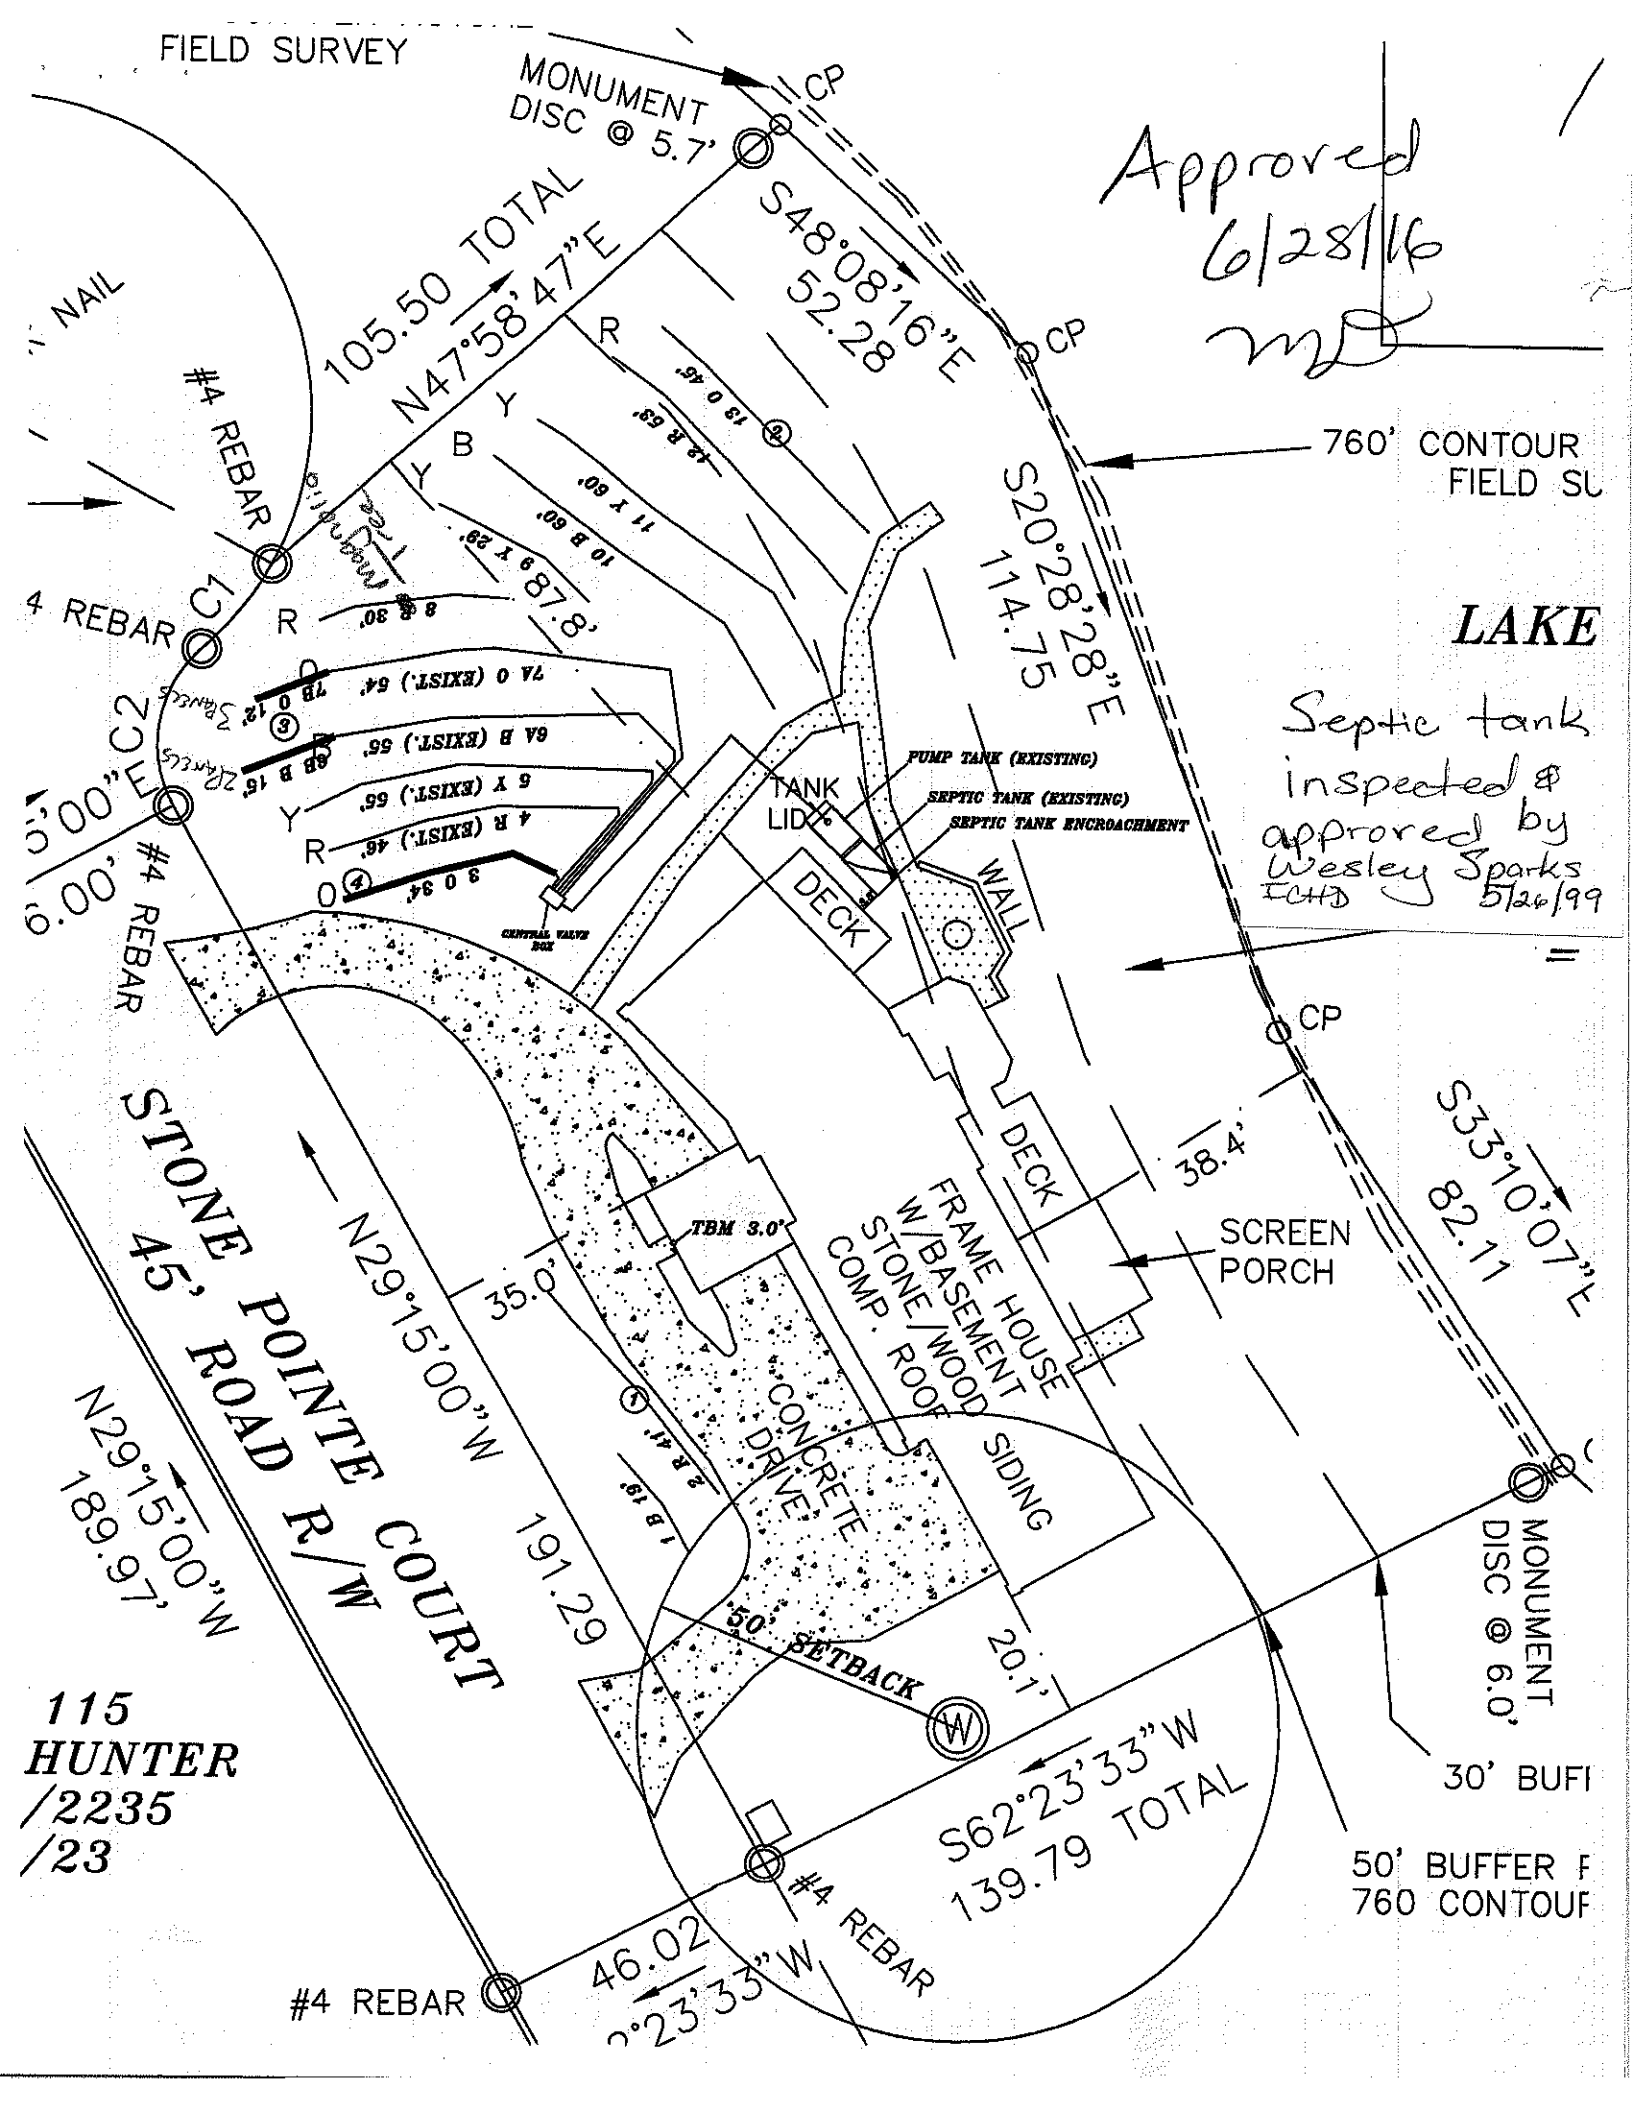
☐ **IMPROVEMENT PERMIT** *with plat valid without expiration* ☒ **IMPROVEMENT PERMIT** *with site plan valid for 60 mos.* ☒ **AUTHORIZATION TO CONSTRUCT** *valid for period equal to IMPROVEMENT PERMIT--not to exceed 60 mo.*

Owner / Applicant Signature: Date: 7/1/16 Installed by: Russell Williams

IMPROVEMENT PERMIT by: Date: 6/28/16 OPERATION PERMIT by: BA Date: 8-12-16

AUTHORIZATION TO CONSTRUCT by: Date: 6/28/16 Existing System Inspected by: Date:

Health Dept. Copy - WHITE Applicant (Final Approval) - YELLOW Applicant (Conditional Approval) - PINK


FIELD SURVEY
MONUMENT DISC @ 5.7'
CP
105.50 TOTAL
N47°58'47"E
S48°08'16"E
52.28
CP
Approved
6/28/16
760' CONTOUR
FIELD SU
NAIL
#4 REBAR
#4 REBAR
#4 REBAR
S20°28'28"E
114.75
LAKE
Septic tank inspected & approved by Wesley Sparks ECHD 5/26/99
PUMP TANK (EXISTING)
SEPTIC TANK (EXISTING)
SEPTIC TANK ENCROACHMENT
TANK LID
DECK
WALL
CENTRAL VALVE BOX
CP
DECK
38.4'
S33°10'07"E
82.11
SCREEN PORCH
FRAME HOUSE W/BASEMENT STONE/WOOD COMP. ROOF
SIDING
TBM 3.0'
35.0'
N29°15'00"W
191.29
CONCRETE DRIVE
50' SETBACK
20.1'
STONE POINTE COURT
45' ROAD R/W
N29°15'00"W
189.97'
115
HUNTER
/2235
/23
MONUMENT DISC @ 6.0'
30' BUFI
S62°23'33"W
139.79 TOTAL
50' BUFFER F
760 CONTOUF
#4 REBAR
46.02
S62°23'33"W
#4 REBAR