IREDELL COUNTY HEALTH DEPARTMENT

STATESVILLE 704-878-5305 MOORESVILLE 704-664-5281

IMPROVEMENT PERMIT / AUTHORIZATION TO CONSTRUCT / OPERATION PERMIT / EXISTING SYSTEM INSPECTION

PERMIT# 072011 PIN# 4615 92 0685 DATE 3/16/98

OWNER OR CONTRACTOR David S Miller PHONE: Business NOT ON PD Home

ADDRESS 2800 One First Union Center Charlotte, NC. 28202c

LOCATION 1100, TR Stonemeher, TR Fawn Ln, TR ~~St~~ Pl. STONEPOINTE CT. 1 2ND on (R)

SUBDIVISION Stonemeher Pl. BLOCK / SECTION LOT 3 LOT AREA NOT ON PD SITE CLASS. PS DESIGN FLOW 360 L.T.A.R. .3

Septic Tank: 1000 Gallons; STB 794 Date 5/21/98
Pump Tank: 1000 Gallons; PT 27 Date 11/23/98
Pump Make: Builds Model WED5111H Serial No M9834709
Nitrification Field: No Fields 1 Square Feet 630 Linear Feet 210
No Lines 14 Trench Width 36" Max Trench Bottom Depth 36" Gravel Depth SAND

☑ New System ☐ Repair System Type: I, II, III, (IV) V, VI
System Description: Jty IV 16" PPBS
Repair System Description: Same
Maintenance Agreement Required: ☒ Yes ☐ No


☒ House/Mod. Home No. Bedrooms 3
☐ Mobile Home No. Bathrooms 3
☐ Business No. Employees
☐ Other
☐ Slab ☐ Crawl Space ☒ Basement w/plumbing ☐ Basement wo/plumbing

Water Supply: ☒ Individual ☐ Public ☐ Community


Comments:/Conditions: LN

Comments:/Conditions:

INITIAL SITE SKETCH

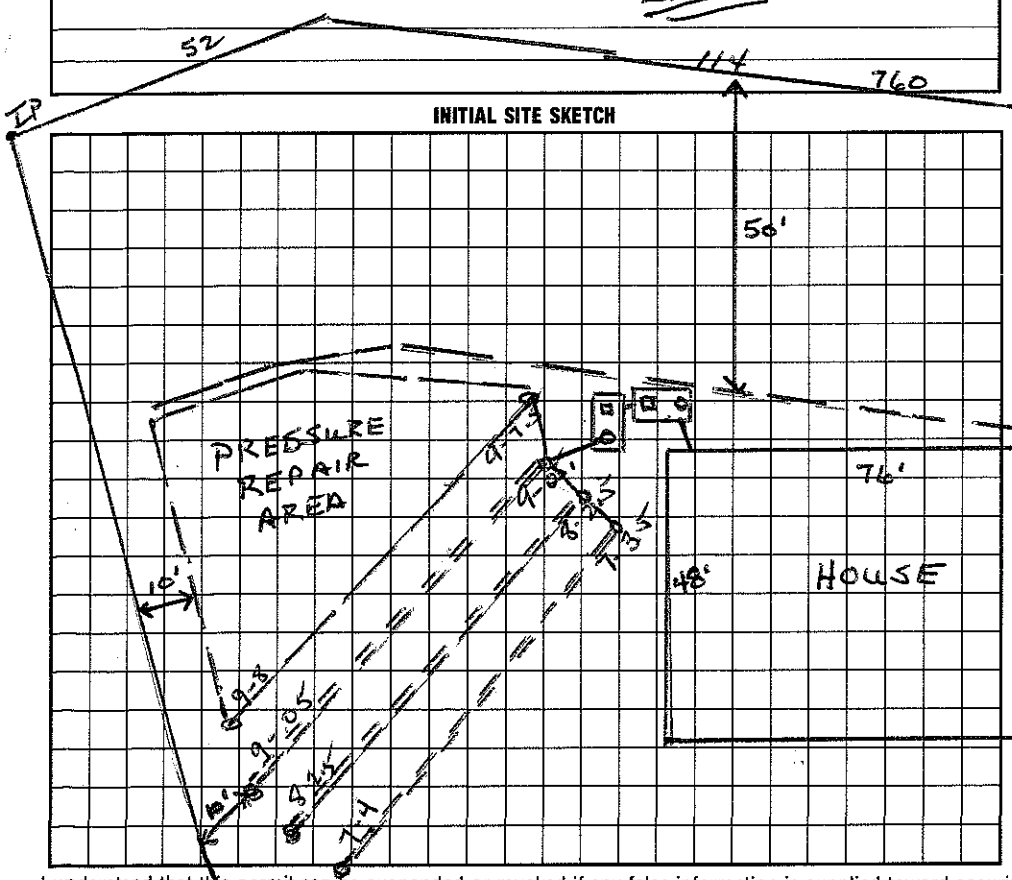

AS BUILT SKETCH

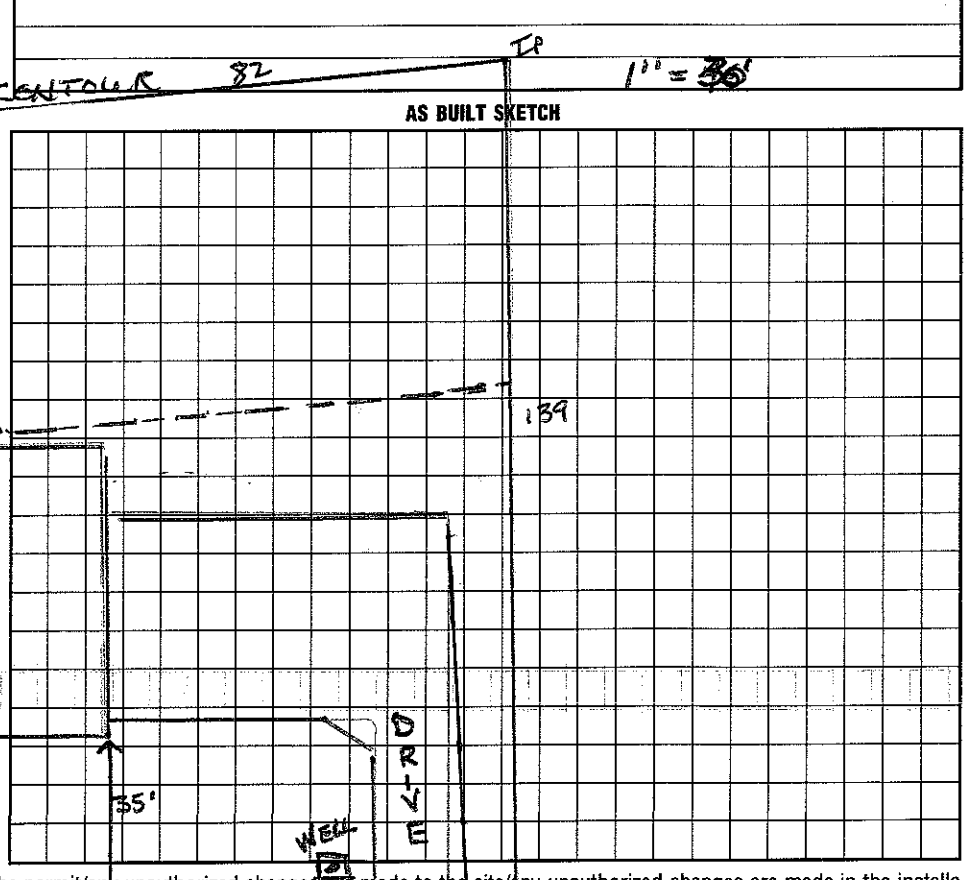

I understand that this permit can be suspended or revoked if any false information is supplied toward securing the permit/any unauthorized changes are made to the site/any unauthorized changes are made in the installation of the system. Improvement Permit with plat valid without expiration. Improvement Permit with site plan valid for sixty months. Authorization to Construct is valid for a period equal to that of Improvement Permit – not to exceed sixty months.

Signed: ~~X~~ ARS BS date 3/12/98 Installed by: WS FJ Ewing

Improvement Permit by: Wesley Sparks RS. date 3/10/98 Operation Permit by: Wesley Sparks RS date 5/26/99

Authorization to Construct by: Wesley Sparks RS. date 3/10/98 Existing System Inspection by: date

HEALTH DEPT. COPY: WHITE INSPECTION COPY (FINAL): GREEN OWNER COPY (FINAL): YELLOW INSPECTION COPY (INITIAL): PINK OWNER COPY (INITIAL): GOLD