IREDELL COUNTY HEALTH DEPARTMENT

Statesville Phone TR 3-7271 Mooresville Phone NO 3-1271

PERMIT TO INSTALL SEPTIC TANK

Permit NO. _____ Permit Date 1 April 1964

Owner Mr. Henry Elmore Address Charlotte, N.C.

Installed By " " Address " "

Location of Property Lake Norman Section 6


Lot # 122

Tank		Capacity		Length of Lines		Fixtures	
Block	(Y)	800	( )	150'	( )	No. of Baths	( )
Precast	( )	900	( )	175'	( )	Dishwasher	( )
		1000	(X)	200'	( )	Garbage Grdr.	( )
		1100	( )	225'	(Y)	Auto-Washer	( )
		1200	( )	250'	( )	Other	
		Other		Other			

NOTIFY HEALTH DEPARTMENT AT LEAST EIGHT HOURS BEFORE TANK IS TO BE INSPECTED.

Final Inspection 1 April 1964 Approved (✓) Disapproved ( )

Remarks _____

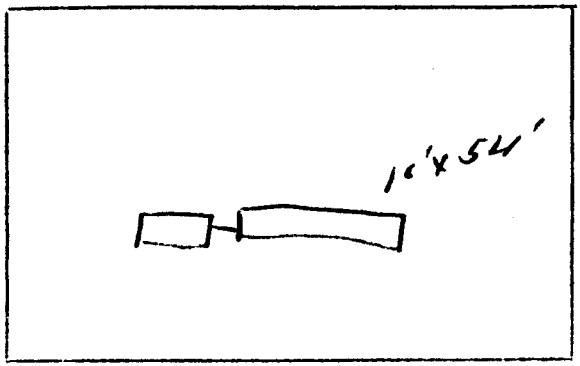

Sketch of Installation

Guy R. Sergeant, RS

Sanitarian