IREDELL COUNTY HEALTH DEPARTMENT

STATESVILLE 704-878-5305 MOORESVILLE 704-664-5281

IMPROVEMENT PERMIT / CERTIFICATE OF COMPLETION / OPERATION PERMIT / EXISTING SYSTEM INSPECTION

PROPERTY DESCRIPTION NO. 069438 DATE 9/19/97 TAX MAP NO. 4615922419 Watershed: ☒ Yes ☐ No

OWNER OR CONTRACTOR JOHN RAROLS PHONE: Business _____ Home _____

ADDRESS 12600 RAMAH RD. HUNTERSVILLE, NC. 28078

LOCATION Brawley Sch. TR Stonemarker, straight TR Fourth Lane, on (R) where sign is located.

SUBDIVISION STONEMARKER BLOCK / SECTION _____ LOT 4 LOT AREA .91 AC SITE CLASS. PS DESIGN FLOW 480 L.T.A.R. .3

Septic Tank: 1000 Gallons; STB 794 Date 2/18/98

Pump Tank: 1000 Gallons; PT 27 Date 1/26/96

Pump Make: _____ Model _____ Serial No. _____

Nitrification Field: No Fields 1 Square Feet ~~480~~ 480+ Linear Feet 240+

No Lines 4 Trench Width 36" Max Trench Bottom Depth 32" Gravel Depth #57 NO.

☒ New System ☐ Repair System Type: I, II, (III) IV, V, VI

System Description: Press - 1.64 PPBS

Repair System Description: SAME

Maintenance Agreement Required: ☐ Yes ☐ No

☒ House/Mod. Home No. Bedrooms 4

☐ Mobile Home No. Bathrooms 3

☐ Business No. Employees _____

☐ Other _____

☐ Slab ☐ Crawl Space ☒ Basement w/plumbing ☐ Basement w/o plumbing


Water Supply: ☒ Individual ☐ Community ☐ Public

Comments: 1" = 40'


~~☐~~ Prof: Paul Block

Comments:

INITIAL SITE SKETCH

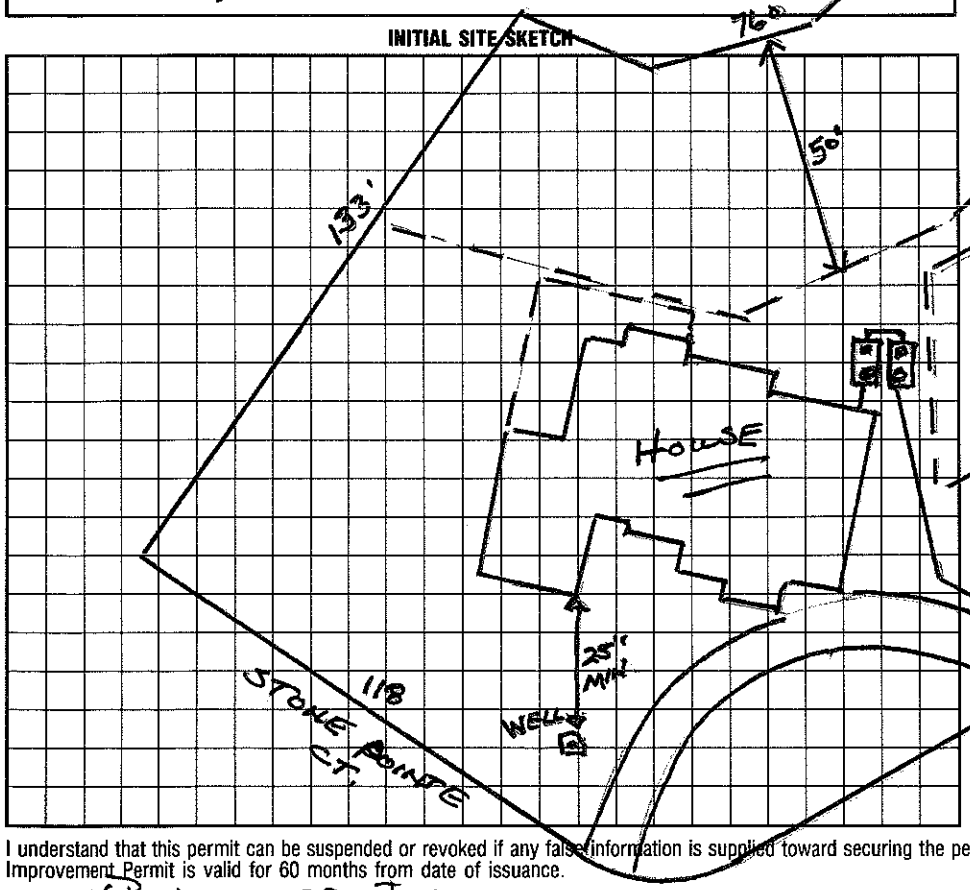

AS BUILT SKETCH

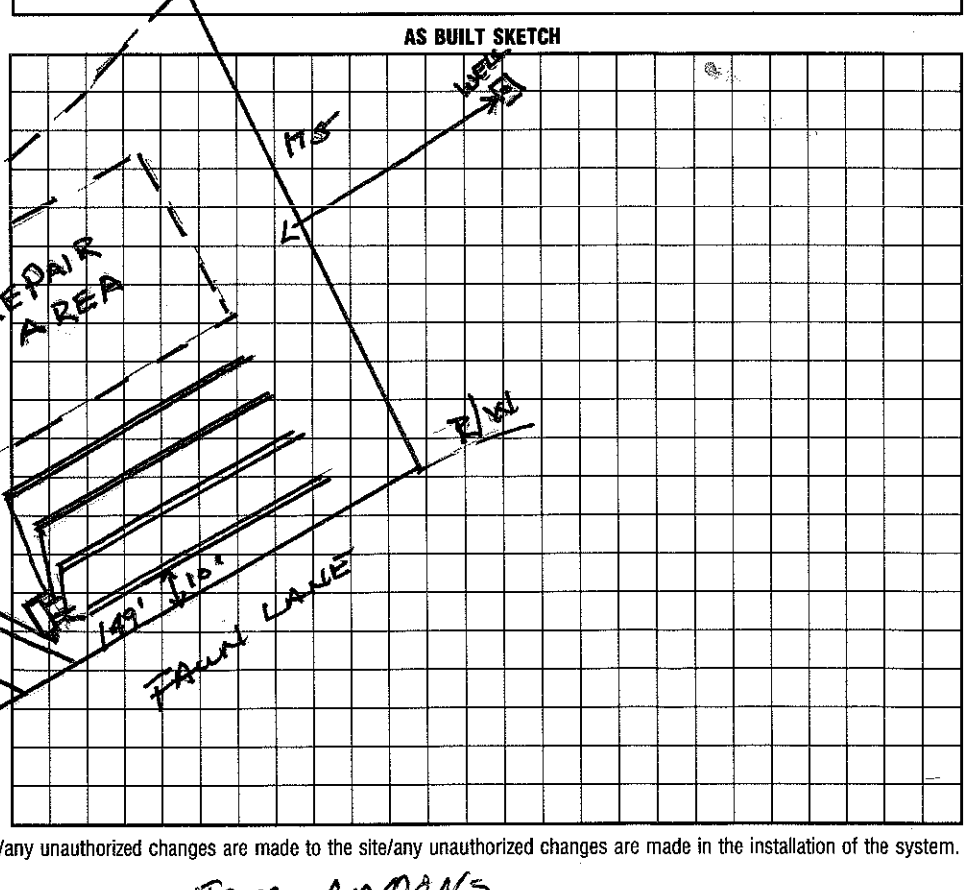

I understand that this permit can be suspended or revoked if any false information is supplied toward securing the permit/any unauthorized changes are made to the site/any unauthorized changes are made in the installation of the system. Improvement Permit is valid for 60 months from date of issuance.

Signed: Barbara Martin

Improvement Permit by: Wesley Sparks RS. date 9/19/97

Existing System Inspected by: Wesley Sparks RS. date 9/19/97

Installed by: TJM ANNONS

Certificate of Completion by: _____ date _____

Operation Permit by: _____ date 5/13/98

HEALTH DEPT. COPY: WHITE INSPECTION COPY (FINAL): GREEN OWNER COPY (FINAL): YELLOW INSPECTION COPY (INITIAL): PINK OWNER COPY (INITIAL): GOLD