Site Address: 395 Barber Loop Mrsvl.

IREDELL COUNTY HEALTH DEPARTMENT

STATESVILLE 704-878-5305 MOORESVILLE 704-664-5281

IMPROVEMENT PERMIT / AUTHORIZATION TO CONSTRUCT / OPERATION PERMIT / EXISTING SYSTEM INSPECTION

PERMIT# ~~13267~~ 14932 PIN# 4615991188.000 DATE 8/14/07

OWNER OR APPLICANT MATTHEW ROMANOFF PHONE: Business _____ Home _____

ADDRESS 395 BARBER LOOP MOORESVILLE NC 28115

LOCATION Brawley School Rd. TR Chuckwood TL Barber Loop on Left 395 Barber Loop

SUBDIVISION ~~N/A~~ CL&T BLOCK / SECTION 7 LOT 106 LOT AREA .77 SITE CLASS PS DESIGN FLOW 480 L.T.A.R. .36 gpd/Ft²

Septic Tank: 1000 Gallons: STB ~~1794~~ Date 8-8-08

Pump Tank: 1000 Gallons: PT 39 Date 8-8-08

Pump Make: Goulds Model PES1M½HP Serial No 00357573

Nitrification Field: No Fields 1 Square Feet 540' Linear Feet 270'

No Lines 3 Trench Width 24" Max Trench Bottom Depth 36" Gravel Depth NA ☐ Gravity ☑ Pressure

☑ New System ☐ Repair ☐ Expansion System Type: I II III (IV) V VI

System Description: LP PPBPS

Repair System Description: LPPPBPS Max Feasible

Maintenance Agreement Required: ☑ Yes ☐ No

☑ House/Mod. Home No. Bedrooms 4

☐ Mobile Home No. Persons ___

☐ Business No. Employees ___

☐ Other ___

Water Supply: ☑ Individual ☐ Public ☐ Community

☐ Slab ☐ Crawl Space ☐ Basement w/plumbing ☐ Basement wo/plumbing


Comments:/Conditions: * Must stay 25' min from basement with up slope drainfield, House will be min. 15' crawl space in front b/c starting basement or the house must be smaller and set min. 15' further back 221' to maintain min. 25' separation.

Comments:/Conditions:

1/4/08 Reviewed Plans, essentially same as I.P. A.C.

1" = 50'

INITIAL SITE SKETCH

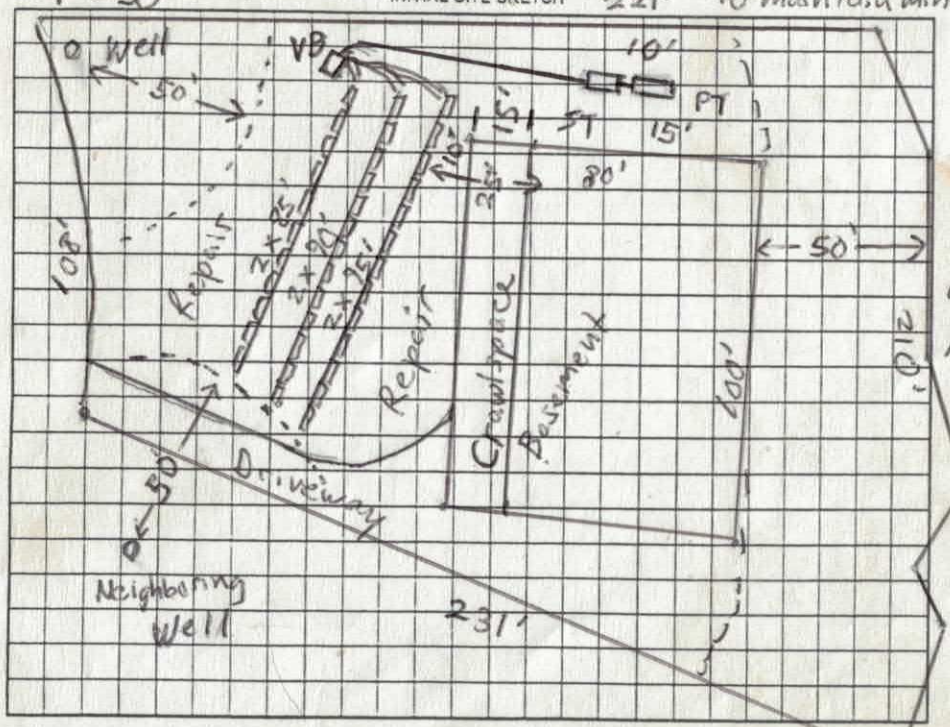

AS BUILT SKETCH

10/6/08 V. sited site for tank final found 2-3' of fill Told Installer they have to remove fill in drainfield area b/f Installation. A.C.

10/8/08 Checked Tanks A.C.

5/32" holes - .41 GPM - 10/16/08 - Pressure Set

Lake Norman

Permit can be suspended or revoked if any false information is supplied toward securing the permit/any unauthorized changes are made to the site/any unauthorized changes are made in the installation of the system. Improvement Permit with plat valid without expiration ☐ Improvement Permit with site plan valid for sixty months ☑ Authorization to Construct is valid for a period equal to that of Improvement Permit – not to exceed sixty months.

Signed: Debra Moss as REagent date 9/10/07

Improvement Permit by: Anthony Coberly date 8/14/07

Authorization to Construct by: Anthony Coberly date 1/4/08

Installed by: Water Management - Caldwell (1077)

Operation Permit by: Working Spaces 25. date 11/4/08

Existing System Inspection by: _____ date _____

HEALTH DEPT. COPY: WHITE OWNER COPY (FINAL): YELLOW OWNER COPY (INITIAL): PINK

DEPARTMENT OF ENVIRONMENT AND NATURAL RESOURCES
DIVISION OF ENVIRONMENTAL HEALTH
ON-SITE WASTEWATER SECTION

Sheet ___ of ___
PROPERTY ID #: _____
COUNTY: _____

SOIL/SITE EVALUATION
for ON-SITE WASTEWATER SYSTEM

OWNER: _____
ADDRESS: _____ APPLICATION DATE _____
PROPOSED FACILITY: _____ PROPOSED DESIGN FLOW (.1949): _____ DATE EVALUATED: 8-25-0
LOCATION OF SITE: #106 PROPERTY SIZE: _____
WATER SUPPLY: ☐ Private ☐ Public ☒ Well ☐ Spring ☐ Other _____ PROPERTY RECORDED: _____
EVALUATION METHOD: ☐ Auger Boring ☐ Pit ☐ Cut TYPE OF WASTEWATER: ☐ Sewage ☐ Industrial Process ☐ Mixed

PROFILE #	.1940 LANDSCAPE POSITION/ SLOPE %	HORIZON DEPTH (IN.)	SOIL MORPHOLOGY (.1941)		OTHER PROFILE FACTORS				PROFILE CLASS & LTAR
			.1941 STRUCTURE/ TEXTURE	.1941 CONSISTENCE/ MINERALOGY	.1942 SOIL WETNESS/ COLOR	.1943 SOIL DEPTH	.1956 SAPRO CLASS	.1944 RESTR HORIZ	
1		0-12	1 sbk l	common 2" stones		48			-3
		12-20	1 sbk cl	few gravel/stones					
		20-48	1 sbk c						
		soil very dry - difficult digging through stones							
2									
3									
4									


DESCRIPTION	INITIAL SYSTEM	REPAIR SYSTEM
vailable Space (.1945)		
stem Type(s)		
e LTAR		

OTHER FACTORS (.1946): _____
SITE CLASSIFICATION (.1948): _____
EVALUATED BY: J. McWilliams
OTHER(S) PRESENT: Kevin Hollman
MMENTS: _____

.005 17:31 704-871-2777

Co Kerin Noto Fax 704-799-8665

Date of Exemption for Repair

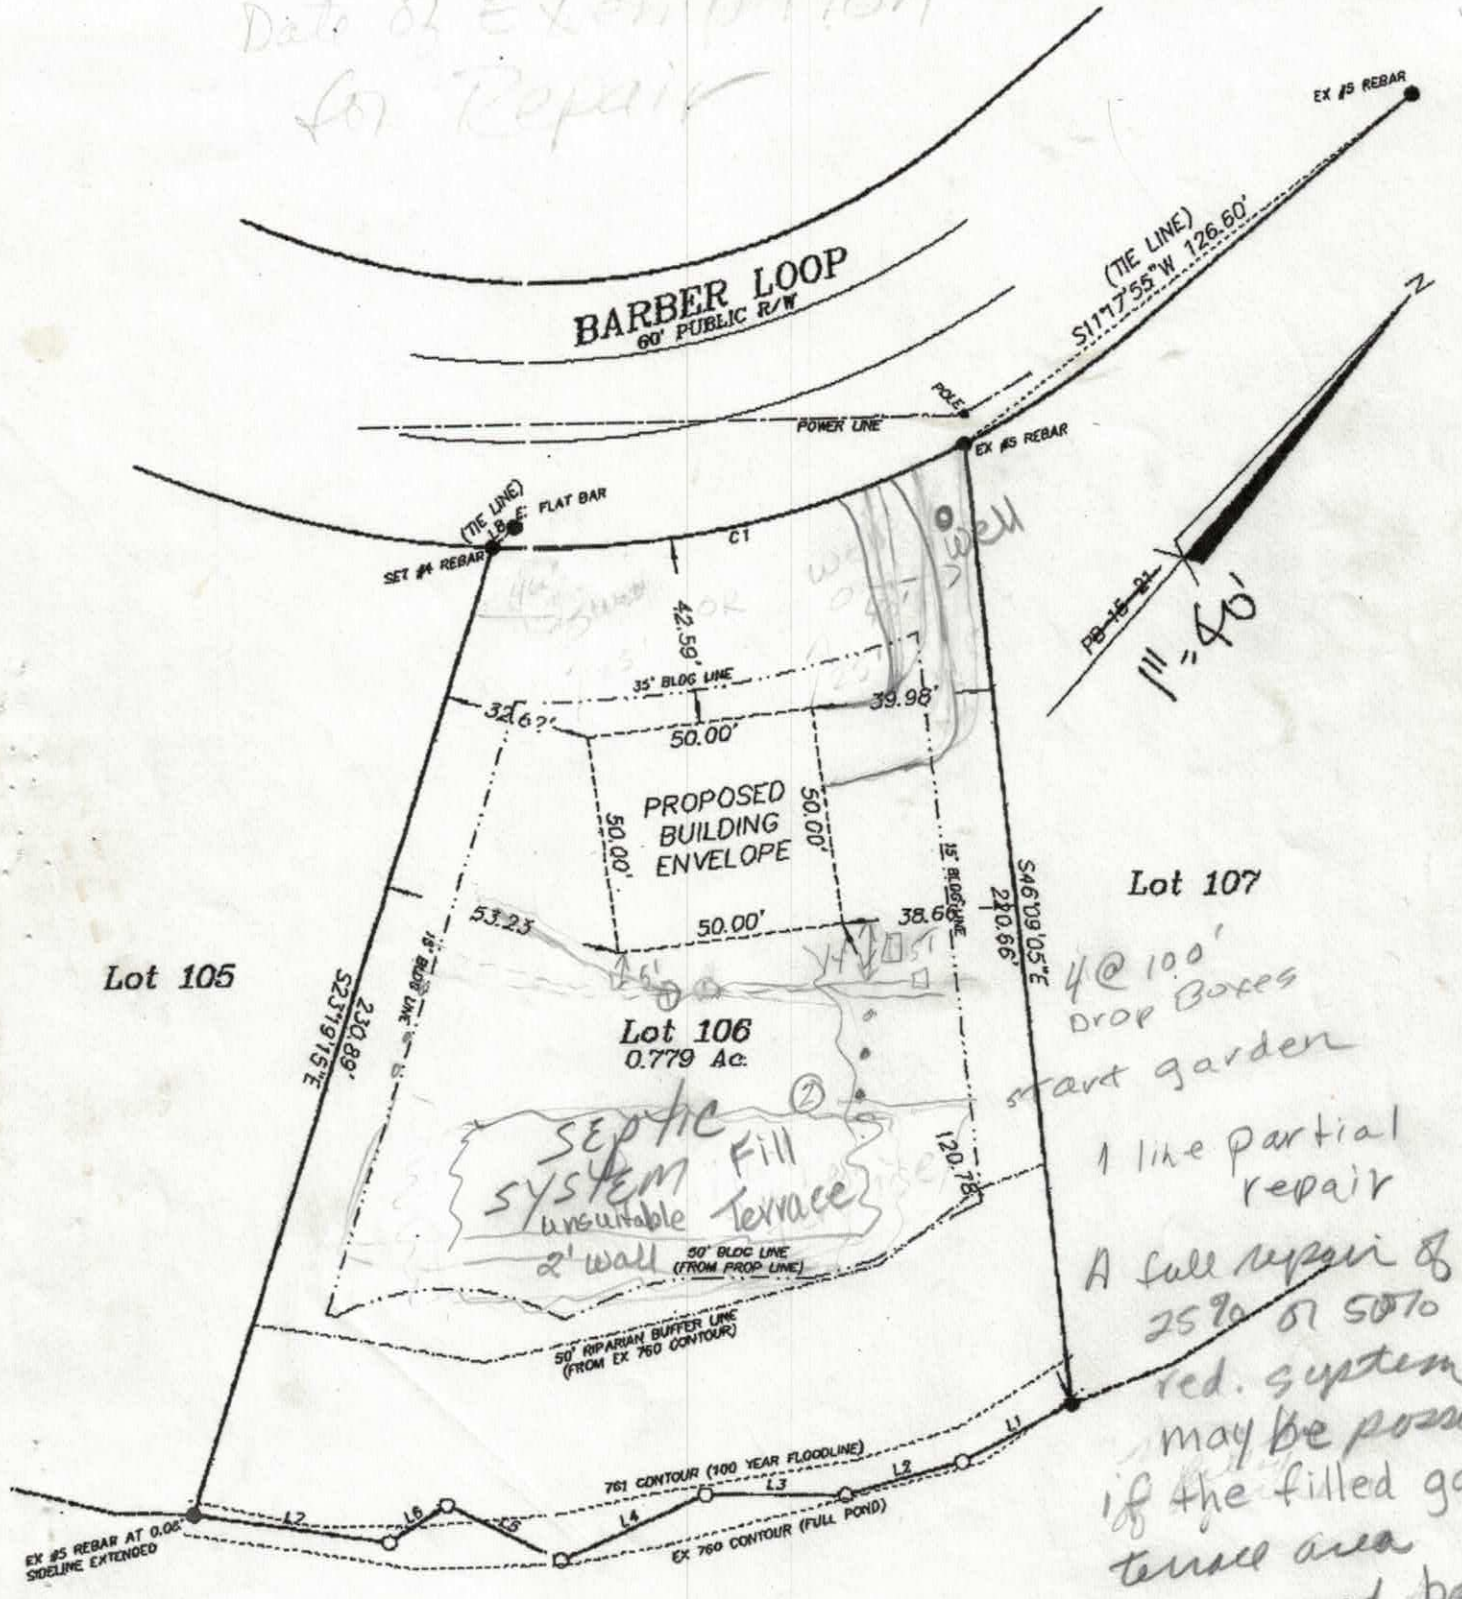

DEPARTMENT OF ENVIRONMENT AND NATURAL RESOURCES
DIVISION OF ENVIRONMENTAL HEALTH
ON-SITE WASTEWATER SECTION

Sheet ___ of ___
PROPERTY ID #: _____
COUNTY: _____

SOIL/SITE EVALUATION
for ON-SITE WASTEWATER SYSTEM

OWNER: Kevin Noto / Charles McCarty
ADDRESS: _____
APPLICATION DATE _____
DATE EVALUATED: 12-14-05
PROPOSED FACILITY: Residential PROPOSED DESIGN FLOW (.1949): 480
PROPERTY SIZE: .77Ac
LOCATION OF SITE: Chuckwood to Barber Loop #106
PROPERTY RECORDED: _____
WATER SUPPLY: ☐ Private ☐ Public ☒ Well ☐ Spring ☐ Other _____
EVALUATION METHOD: ☒ Auger Boring ☐ Pit ☐ Cut
TYPE OF WASTEWATER: ☒ Sewage ☐ Industrial Process ☐ Mixed

PROFILE #	.1940 LANDSCAPE POSITION/ SLOPE %	HORIZON DEPTH (IN.)	SOIL MORPHOLOGY (.1941) .1941 STRUCTURE/ TEXTURE	SOIL MORPHOLOGY (.1941) .1941 CONSISTENCE/ MINERALOGY	OTHER PROFILE FACTORS .1942 SOIL WETNESS/ COLOR	OTHER PROFILE FACTORS .1943 SOIL DEPTH	OTHER PROFILE FACTORS .1956 SAPRO CLASS	OTHER PROFILE FACTORS .1944 RESTR HORIZ	PROFILE CLASS & LTAR
1	5' below house center 10+ 8%	0-5	1sbkcl			48			PS .3
		5-48	1sbkc	fr ss/sp se					
2		0-4	1sbkcl			48			PS .3
		4-48	1sbkc						
3									
4									

DESCRIPTION	INITIAL SYSTEM	REPAIR SYSTEM
Available Space (.1945)	YES	NO
System Type(s)	25% red.	
Site LTAR	.3	

OTHER FACTORS (.1946): _____
SITE CLASSIFICATION (.1948): PS
EVALUATED BY: Judy Melville
OTHER(S) PRESENT: _____

COMMENTS: Repair exempt by deed date 1973

DEPARTMENT OF ENVIRONMENT AND NATURAL RESOURCES
DIVISION OF ENVIRONMENTAL HEALTH
ON-SITE WASTEWATER SECTION

Sheet ___ of ___
PROPERTY ID #: _____
COUNTY: _____

SOIL/SITE EVALUATION
for ON-SITE WASTEWATER SYSTEM

OWNER: _____ APPLICATION DATE _____
ADDRESS: _____ DATE EVALUATED: 10/14/08
PROPOSED FACILITY: _____ PROPOSED DESIGN FLOW (.1949): 480 PROPERTY SIZE: _____
LOCATION OF SITE: 345 Barber Loop CUST Sec 7 Lot 106 PROPERTY RECORDED: _____
WATER SUPPLY: ☐ Private ☐ Public ☐ Well ☐ Spring ☐ Other _____
EVALUATION METHOD: ☐ Auger Boring ☒ Pit ☐ Cut TYPE OF WASTEWATER: ☐ Sewage ☐ Industrial Process ☐ Mixed

PROFILE NUMBER	.1940 LANDSCAPE POSITION/ SLOPE %	HORIZON DEPTH (IN.)	SOIL MORPHOLOGY (.1941) .1941 STRUCTURE/ TEXTURE	SOIL MORPHOLOGY (.1941) .1941 CONSISTENCE/ MINERALOGY	OTHER PROFILE FACTORS .1942 SOIL WETNESS/ COLOR	.1943 SOIL DEPTH	.1956 SAPRO CLASS	.1944 RESTR HORIZ	PROFILE CLASS & LTAR
1	L ≈ 3%	0-10	Gr Loam	vPr ns np	a lot of medium sized stones				
		10-48	mAbk C	Pr-Fi ss,sp					
		Soil does not appear to have been compromised by the fill that was on top of the drainfield							
2									
		Pit dug in center of proposed drainfield.							
3									
4									

DESCRIPTION	INITIAL SYSTEM	REPAIR SYSTEM
Available Space (.1945)		
System Type(s)		
Site LTAR		

OTHER FACTORS (.1946): _____
SITE CLASSIFICATION (.1943): _____
EVALUATED BY: Anthony Cokes Jr. R.S.
OTHER(S) PRESENT: Septic contractor water Mgmt.

IREDELL COUNTY HEALTH DEPARTMENT

Application For Improvement Permit and/or Authorization To Construct, Existing System Inspection

(THE ABOVE PERMIT DOCUMENTS WILL BECOME INVALID IF INFORMATION PROVIDED ON THIS APPLICATION IS FALSIFIED OR CHANGED, OR IF THE SITE IS ALTERED. THE IMPROVEMENT PERMIT IS VALID FOR EITHER 60 MONTHS OR WITHOUT EXPIRATION DEPENDING UPON DOCUMENTATION SUBMITTED - APPLICATION WITH SITE PLAN 60 MONTHS, APPLICATION WITH COMPLETE, SCALED PLAT WITHOUT EXPIRATION. SEE 15A NCAC 18A .1937(f) FOR DETAILS)

1. APPLICATION FOR: ✓ Improvement Permit ___Authorization To Construct ___BOTH ___Existing System Inspection

2. Page 2: *Site Plan Worksheet* Form MUST Accompany This Application
   The following optional attachments may also be submitted: ___ Survey Plat, Scaled no more than 1 Inch = 60 Feet
   Place check ( ) beside whichever is submitted if applicable ___ Custom Site Plan, Scaled no more than 1 Inch = 60 Feet

3. **Applicant Information:**

Applicant Name	Mailing Address	Home Phone	Work Phone
Matthew Romanoff			
Owner Name	**Mailing Address**	**Home Phone**	**Work Phone**

4. **Property Information:**

Street Address	Subdivision Name	Section/Phase and Lot Number
395 Barber Loop	-NA-	

Driving Directions: Brawley School Rd to (R) Chuckwood (L) Barber Loop

****

5. **RESIDENTIAL Site Development Information:** *(Check or Complete ALL that apply)*

(✓) New, Single Family Residence
( ) New, Multi-Family Residence
( ) Expansion of Existing Septic System
( ) Repair To Failing Septic System

Maximum Number of Bedrooms 4
Maximum Number of Occupants ___
If Expansion, Current Number of Bedrooms ___

( ) Crawl Space Foundation?
( ) Concrete Slab Foundation?
(X) Basement w/Plumbing?
( ) Basement w/out Plumbing?

IF Non- Residential Site Development:
Type of Business ___
Square Footage of Building ___
Maximum Number of Employees ___
Maximum Number of Seats ___

****

6. **Proposed Water Supply:**

(✓) New Well ( ) Existing Well ( ) Community Well ( ) City Water ( ) Other Public Water

****

7. **Desired Septic System Type:** *(You may rank in order of preference, if any)*

( ) Alternative ( ) Conventional ( ) Innovative ( ) Modified Conventional ( ) Other_____ ( ) No Preference

****

8. **Please Answer The Following To The Best of Your Ability:**

( ) Yes (✓) No Does the site contain any jurisdictional wetlands?
( ) Yes (✓) No Is any non-domestic sewage (i.e. industry) to be generated?
( ) Yes (✓) No Is the site subject to approval by any other public agency?


****

I have read this application and certify that the information provided herein is true, complete, and correct. Authorized county and state officials are granted right of entry to conduct necessary inspections to determine compliance with applicable laws and rules. I understand that I am solely responsible for the proper identification and labeling of all property lines and corners and making the site accessible so that a complete site evaluation can be performed.

9. **Signature:** Debra S. Moss as RE Agent — 9-10-07

Property owner or owner's legal representative signature (SIGNATURE REQUIRED) — DATE

VICINITY MAP – NTS

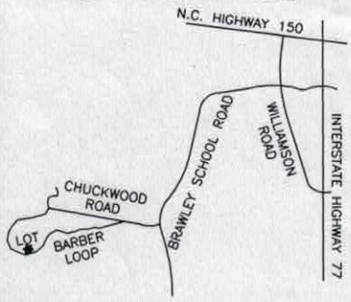

SURVEYOR CERTIFICATION

THIS IS TO CERTIFY THAT ON THE 14TH DAY OF NOVEMBER, 2007 AN ACTUAL SURVEY WAS MADE UNDER MY SUPERVISION OF THE PROPERTY SHOWN ON THIS PLAT, AND THAT THE BOUNDARY LINES AND THE IMPROVEMENTS, IF ANY, ARE AS SHOWN HEREON. THIS PLAT MEETS THE MINIMUM STANDARDS OF PRACTICE FOR LAND SURVEYING IN NORTH CAROLINA, BOARD RULE .1600 (21 NCAC 56) AND THE RATIO OF PRECISION DOES NOT EXCEED AN ERROR OF CLOSURE OF ONE (1) FOOT PER 10,000 FEET OF PERIMETER SURVEYED NOR 20 SECONDS TIMES THE SQUARE ROOT OF THE NUMBER OF ANGLES TURNED.

SIGNED _____

FLOOD CERTIFICATION

THIS IS TO CERTIFY THAT THE SUBJECT PROPERTY IS LOCATED IN A SPECIAL FLOOD HAZARD AREA AS SHOWN ON MAPS PREPARED BY THE FEDERAL EMERGENCY MANAGEMENT AGENCY, FEDERAL INSURANCE ADMINISTRATION, DATED JUNE 22, 1998 .
COMMUNITY PANEL 370313 0200 C

1 INCH = 40 FEET

40 0 40 80


REVISED NOVEMBER 20TH, 2007 TO SHOW BOUNDARY SURVEY
REVISED NOVEMBER 29TH, 2007 TO MOVE & ROTATE HOUSE
REVISED DECEMBER 26TH, 2007 TO ROTATE HOUSE & MOVE GARAGE

LEGEND
E.I.R. = EXISTING IRON ROD
N.I.R. = NEW IRON ROD
R/W = RIGHT OF WAY
SQ.FT. = SQUARE FOOT
NTS = NOT TO SCALE
NAVD = NORTH AMERICAN VERTICAL DATUM

REFERENCE MAP BOOK 14-76
R.B. PHARR & ASSOCIATES, P.A. SURVEYING & MAPPING

NORTH CAROLINA PROFESSIONAL SEAL L-3848 LAND SURVEYOR DOUGLAS E. MORRISON

LAKE NORMAN
WATER LEVEL ELEVATION=753.19' (NAVD 29)
NOVEMBER 20TH, 2007
FULL POND ELEVATION=760.00' (NAVD 29)

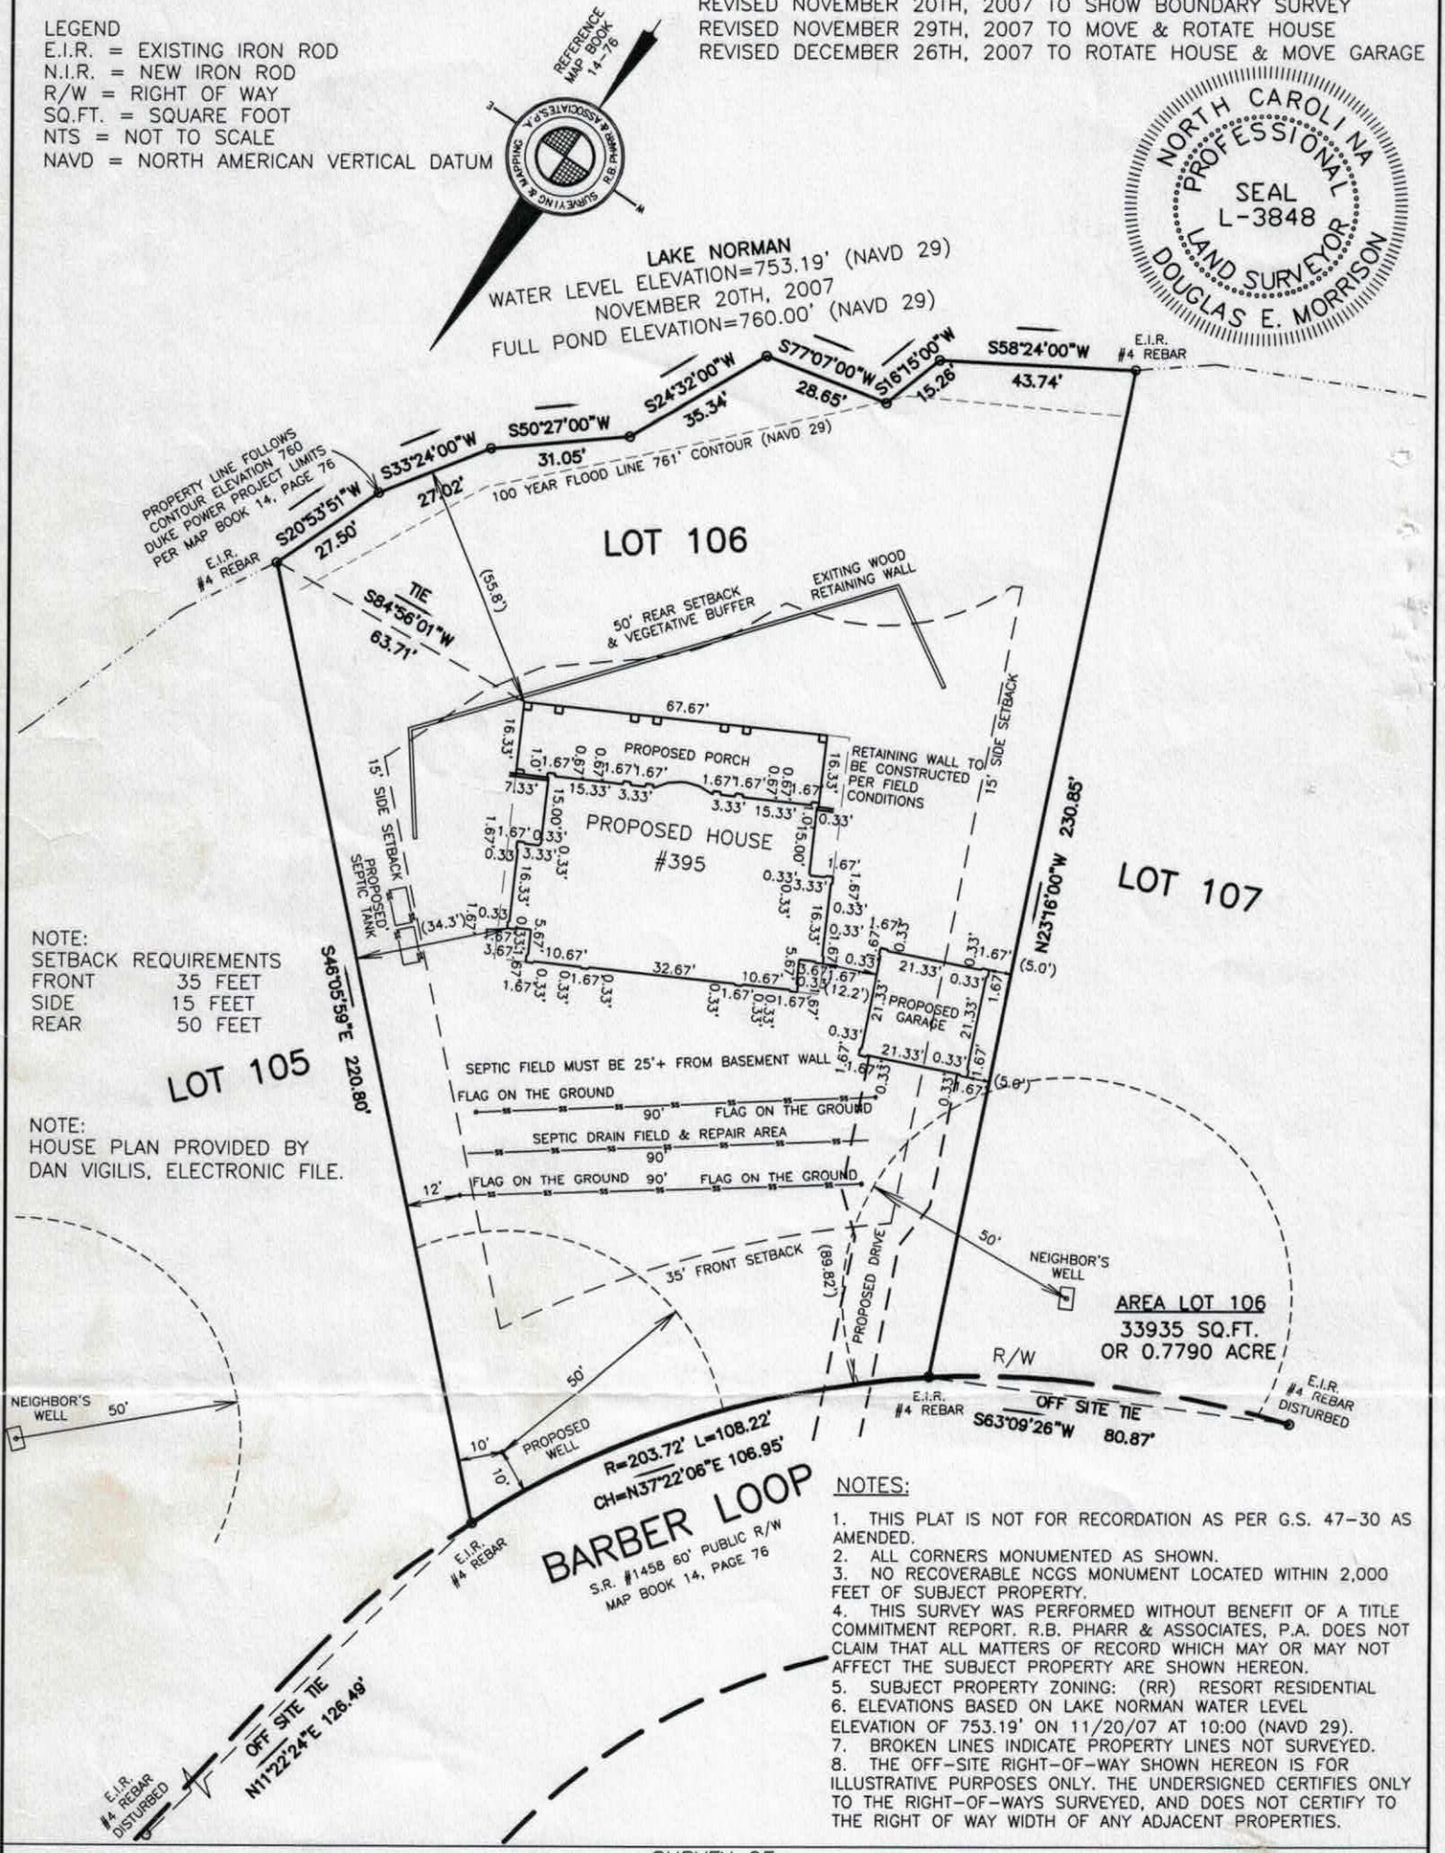

NOTE:
SETBACK REQUIREMENTS
FRONT 35 FEET
SIDE 15 FEET
REAR 50 FEET

NOTE:
HOUSE PLAN PROVIDED BY DAN VIGILIS, ELECTRONIC FILE.

NOTES:

1. THIS PLAT IS NOT FOR RECORDATION AS PER G.S. 47-30 AS AMENDED.
2. ALL CORNERS MONUMENTED AS SHOWN.
3. NO RECOVERABLE NCGS MONUMENT LOCATED WITHIN 2,000 FEET OF SUBJECT PROPERTY.
4. THIS SURVEY WAS PERFORMED WITHOUT BENEFIT OF A TITLE COMMITMENT REPORT. R.B. PHARR & ASSOCIATES, P.A. DOES NOT CLAIM THAT ALL MATTERS OF RECORD WHICH MAY OR MAY NOT AFFECT THE SUBJECT PROPERTY ARE SHOWN HEREON.
5. SUBJECT PROPERTY ZONING: (RR) RESORT RESIDENTIAL
6. ELEVATIONS BASED ON LAKE NORMAN WATER LEVEL ELEVATION OF 753.19' ON 11/20/07 AT 10:00 (NAVD 29).
7. BROKEN LINES INDICATE PROPERTY LINES NOT SURVEYED.
8. THE OFF-SITE RIGHT-OF-WAY SHOWN HEREON IS FOR ILLUSTRATIVE PURPOSES ONLY. THE UNDERSIGNED CERTIFIES ONLY TO THE RIGHT-OF-WAYS SURVEYED, AND DOES NOT CERTIFY TO THE RIGHT OF WAY WIDTH OF ANY ADJACENT PROPERTIES.

SURVEY OF
LOT 106, SECTION 7, CRESCENT LAND AND TIMBER RECREATION LOTS

R. B. PHARR & ASSOCIATES
PROFESSIONAL SURVEYORS
19801 S. MAIN STREET
CORNELIUS, NC 28031
TEL: 704-895-1730
FAX: 704-895-1964

DAVIDSON TOWNSHIP, IREDELL COUNTY, N.C.
PREPARED FOR
MATTHEW B. ROMANOFF & KAREN MINER-ROMANOFF

REFERENCE: MAP BOOK 14, PAGE 76
TAX PARCEL: 4615-91-1181


CREW:	DRAWN:	REVISED:	JOB NUMBER:
P.T.	T.K.		71968

DOOR SCHEDULE		
MARK	SIZE	
1	3'-0" x 6'-8"	
2	2'-6" x 6'-8"	
3	2'-8" x 6'-8"	
4	2'-4" x 6'-8"	
5	2'-0" x 6'-8"	

CRAWL SPACE AREA

1250 SQ.FT.

NOTE:
THIS CRAWL SPACE IS SEALED AND PROVIDED WITH CONDITIONED AIR. CONTRACTOR TO PROVIDE CODE APPROVED VAPOR BARRIER, AND ALL EXTERIOR WALLS ARE TO BE INSULATED PER SECTION N1102.1.7. WITH AN APPROVED INSULATION.

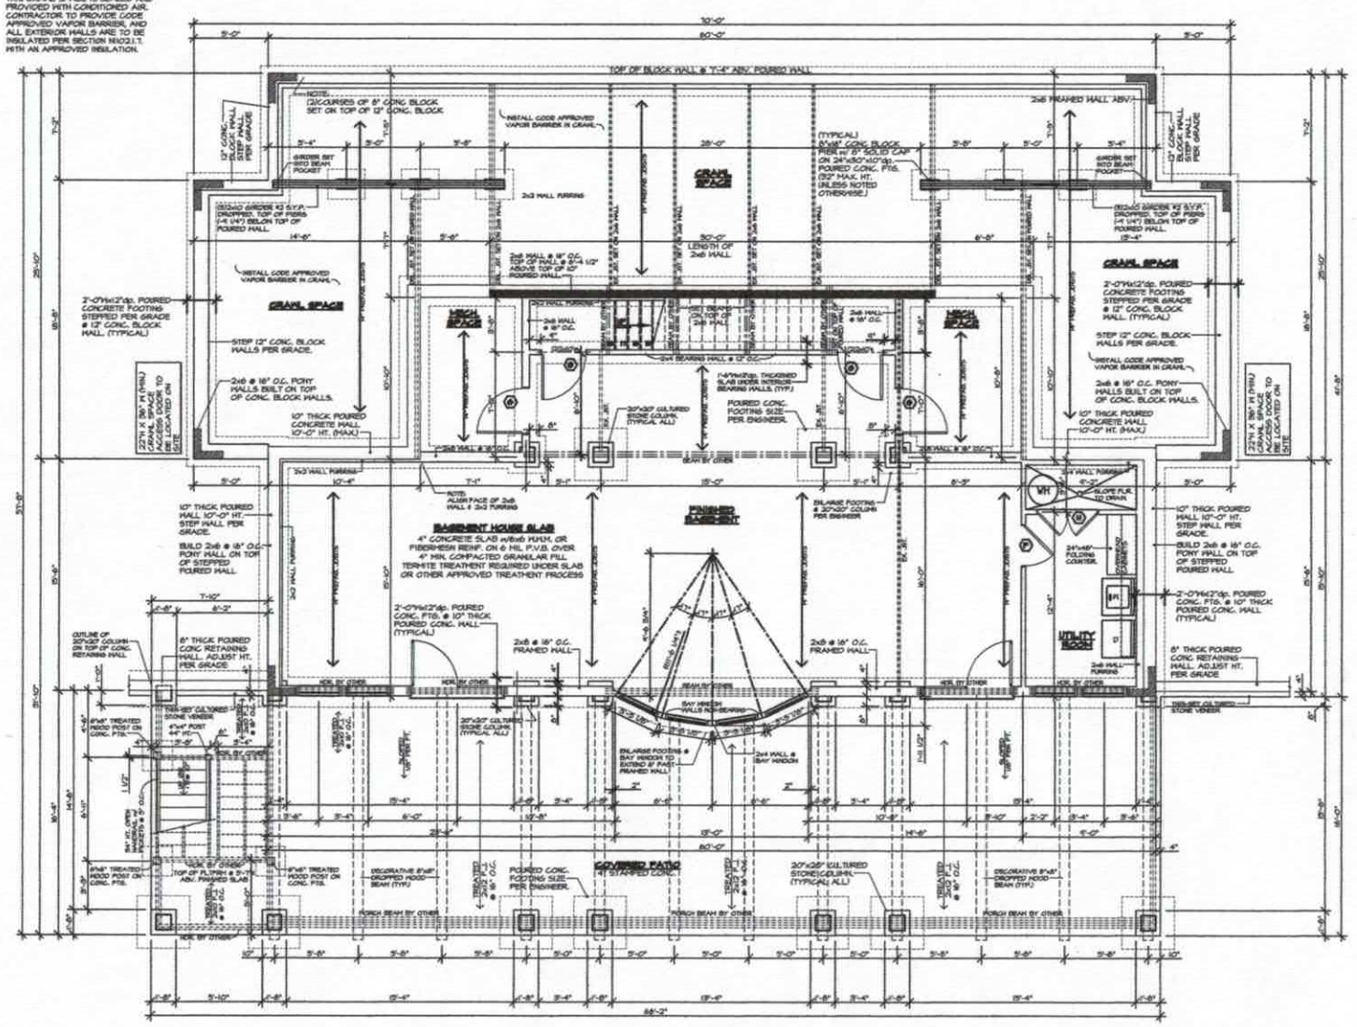

Acknowledgement Of
Plans Submittal ONLY!
Date 1/4/08
Date 1/4/08

DOOR SCHEDULE	
MARK	SIZE
1	16'-0"x8'-0"
2	16'-0"x8'-0"
Iredell County
ZONING PERMIT

227 South Center St. PO Box 788 Statesville, NC 28687 Phone 704-878-3118

Call Sanitarian between 8 a.m. & 9 a.m. Statesville 704-878-5305 Mooresville 704-664-5281

Permit #:	132697ZO	Subdivision:	
Proposed Use:	Single Family	Township:	1700 Davidson
Location of Property:	000 BARBER LOOP Mooresville NC 28117		
Parcel #:	4615991188.000	Zoning:	RR
Lot #:	0 Size: 0.772	Flood Plain:	No Watershed: WSIV-CA
Applicant:	Kevin Noto	Owner:	BEAUPINE M TOWNSEND
Address:	4455 Kiser Island Rd Terrell NC 28682	Address:	1200 REMBRANDT CIRCLE CHARLOTTE, NC 282110000
Phone:	704-737-1771	Phone:	
Property Recorded:	Yes Site Plan Reviewed:	Community Water:	No Community Sewer:

If permitted the following minimum requirements must be met, unless Health Department requires more land area, or other qualifications are indicated in the comments.

Min. Lot Area: 30000 Min. Front Yard: 35 ft Min. Left Side Yard: 15 ft
Min. Lot Width: 100 Min: Rear Yard: 50 ft Min: Right Side Yard: 15 ft
Min. Number Parking Spaces: Max. Built Upon Area:

Comments:

DEVELOPER PERMIT

rec# 3491
ck# 1185
CC

Directions:

Exit 36 west to Williamson Rd, South Williamson Rd, right Brawley School Rd, right Chuckwood, left Barber Loop, property on left

FEES

Zoning Permit/Inspection Fee	☑	$45.00
Site Plan Review Fee	☐	$0.00
Environmental Health New System	☑	$350.00
Environmental Health Existing System	☐	$0.00
Total Fees:		$395.00

I certify that all statements made in this application and any attached documents are true, complete, and correct to the best of my knowledge and belief and are made in good faith. I understand that false information may be grounds for rejection of this application. Authorized Health Department and Planning & Enforcement Representatives are granted right of entry to make evaluations or inspections and to release information upon public request.

Applicant: Kevin Noto Date: 11-28-05

A non-refundable fee of $45.00 is charged on all permit applications.

DEBBIE WILLIAMS Printed: 11/28/2005

TOTAL P.01